


Lat. 14, Sub. 21, S.S. 22.
 W. B. Carter Construction Company Inc.
 Date: Nov. 6, 1969. Proj. No. C28-36
 Book K-87



Lat. 19, Sub. 10, S.S. No. 22
 Utility Contractors, Inc.
 Date: Nov. 7, 1969. Project No. C28-4
 Book K-78

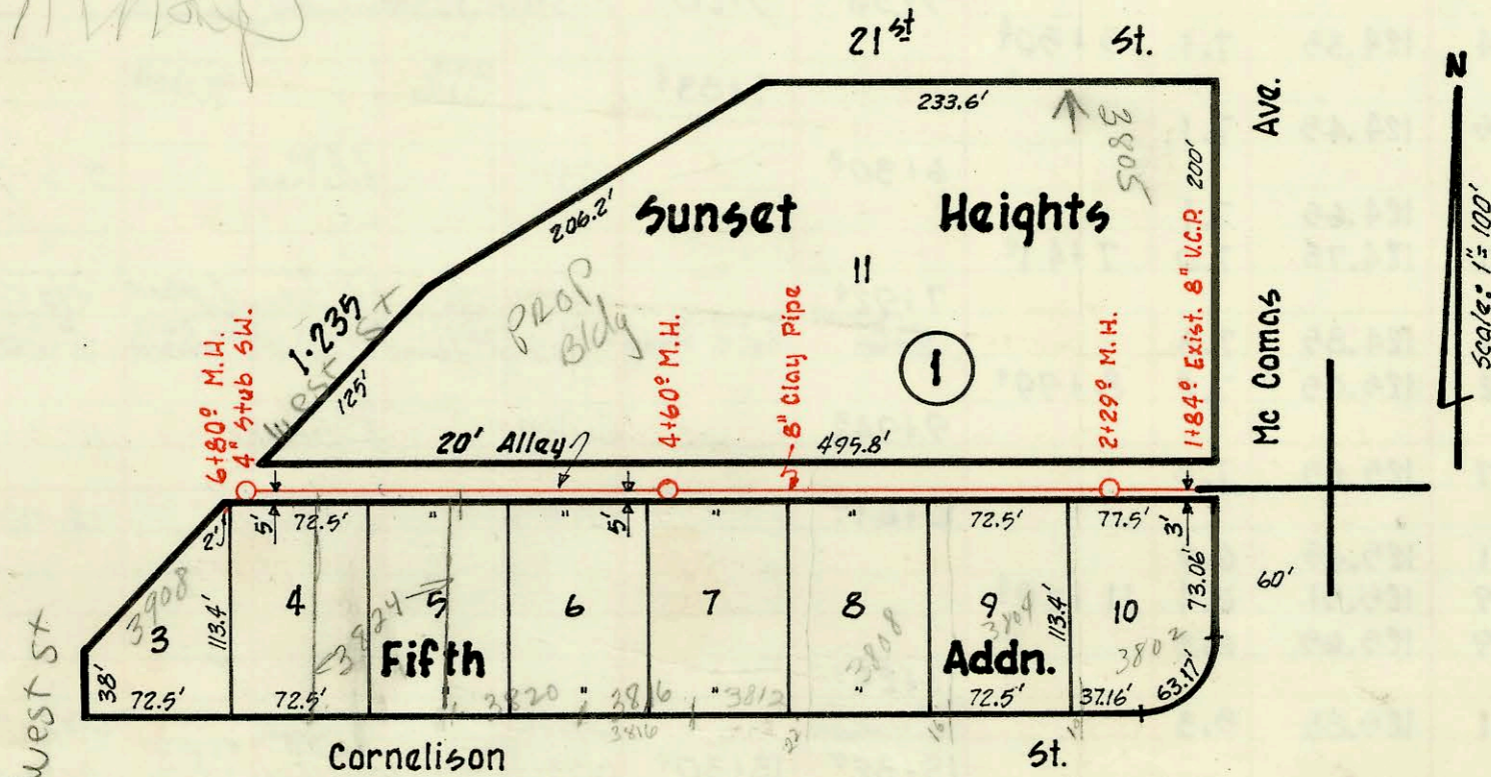