


Lat. 9, Sub. 10, W.I.S.
 W. B. Carter Construction Company Inc.
 Date: Nov. 13, 1969 Project No. C29-35
 Book: 258.4

on map

2001-01547-612561-3244 Woodland - Mies Const - 4" stub 40 17W110 CO, trap

Lat. 17, Sub. 4, S.S.#23
 Mid States Construction Company, Inc.
 Date: Dec. 9, 1969. Project No. C23-69
 Book AR-61

on map

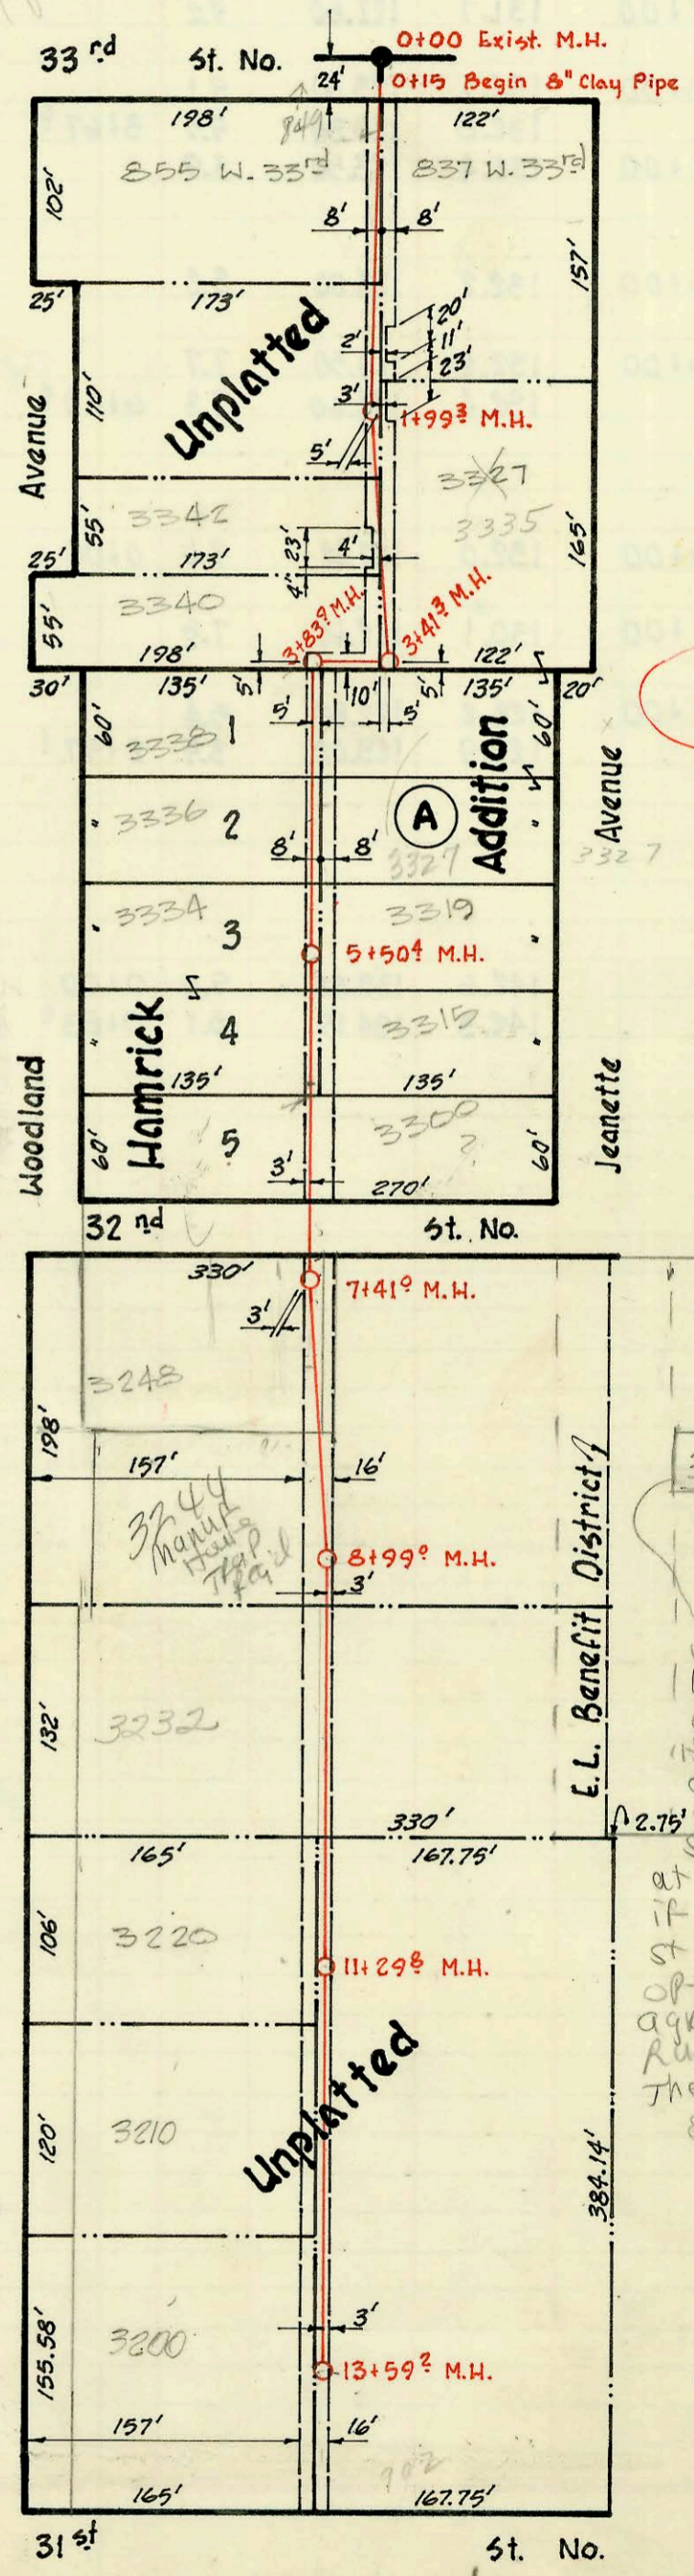

Trap Area

3251
 Mount House
 Trap Reg'd
 Note:
 Owner, Lee
 Hay, signed
 agreement
 to have city
 sewer at
 at his expense
 if Jeanette
 St is ever
 opened. This
 agreement
 runs with
 the land
 8/21/01
 BSR

Trap Area

