


Lot 15, Sub. 21, S.S. #22

W.B. Carter Construction Company, Inc.  
Dec. 30, 1969 Project No. C28-39  
Book: J.K. 55.#13

*on map*

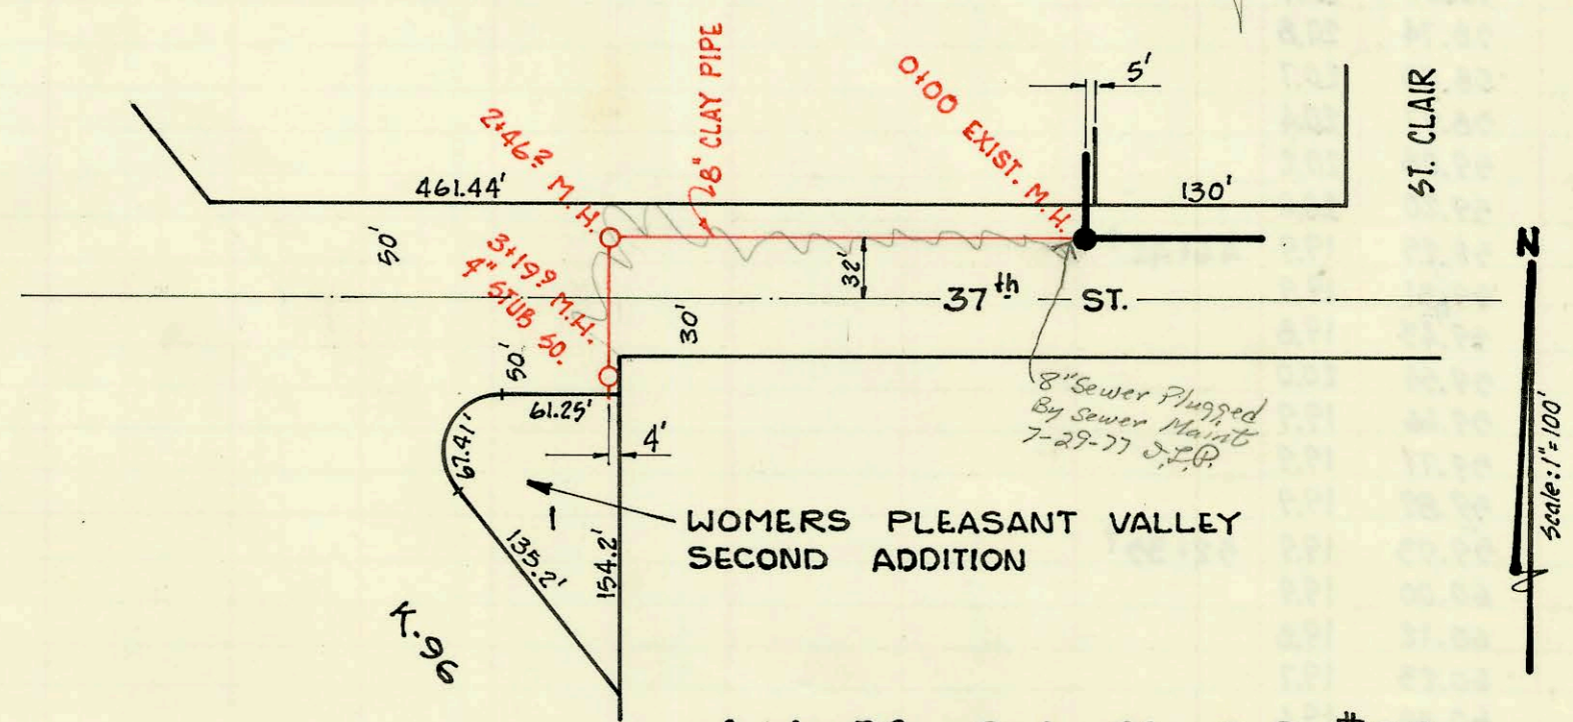

Lot 22, Sub. 21, S.S. #22

W.B. Carter Construction Company, Inc.  
Booked: May 15, 1970, from K.85  
Private Project

*on map*

