


11=100

SERVICE RECORD


CONSTRUCTION RECORD

Note
 This area still has
 some homes on a
 septic system
 10/26/98

Neighborhood
 Area - Bldg permits
 after 7/95 must show
 value of 10,000 or over
 waived fee can be

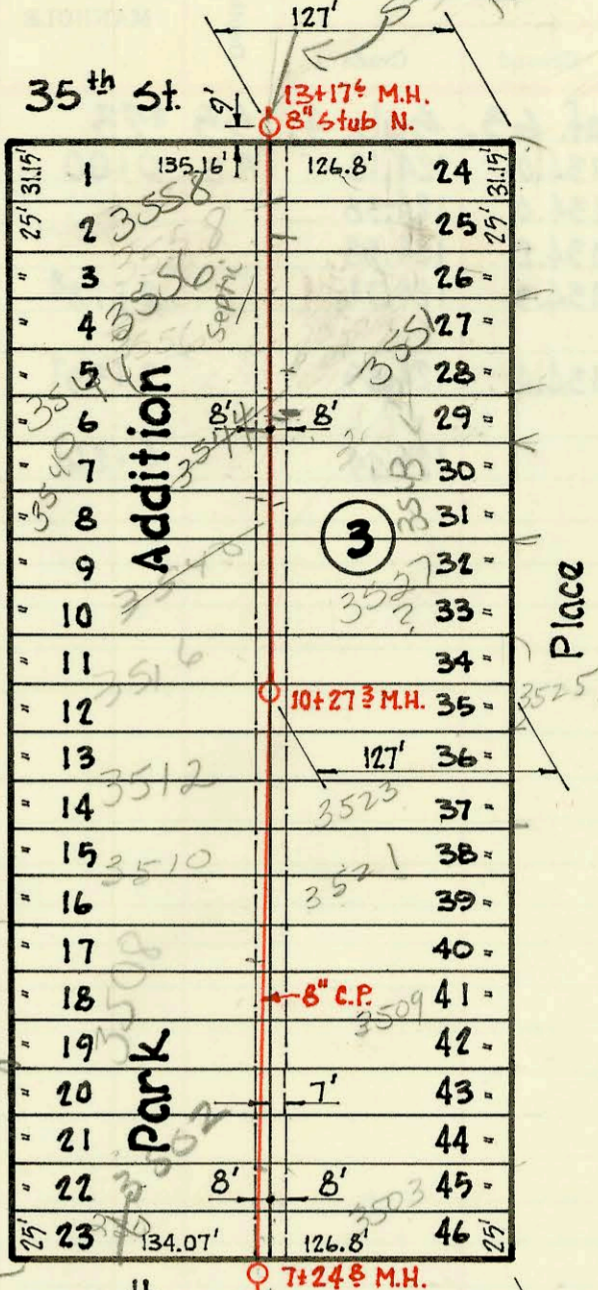

North
 Scale: 1" = 100'

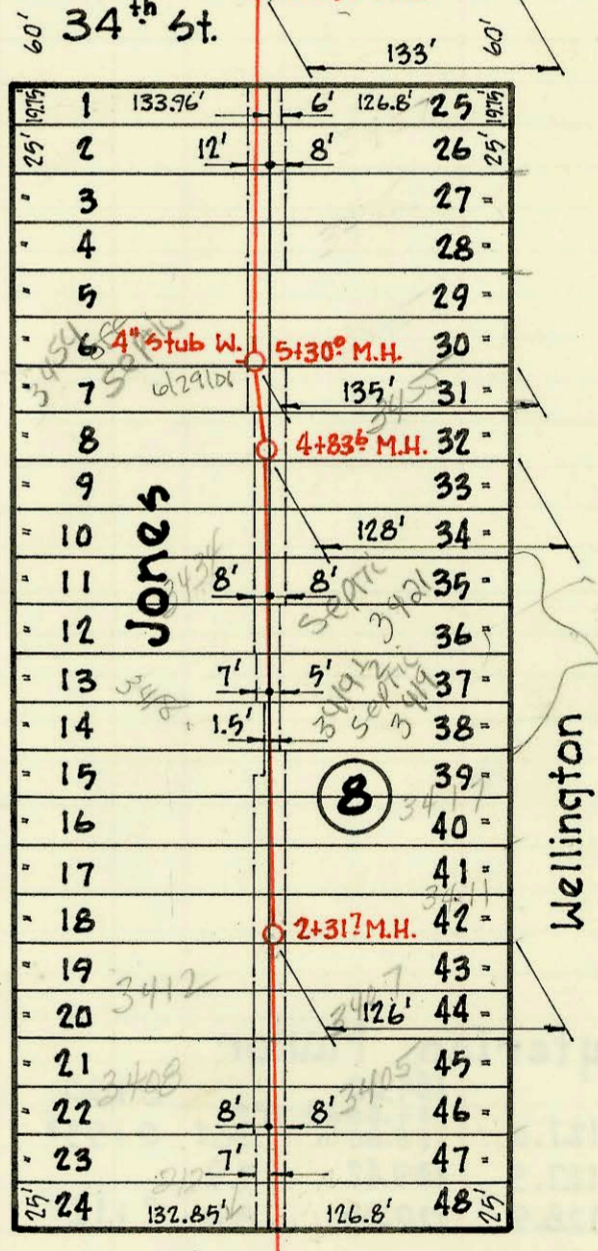

3419 03419 1/2 and
 3421 1/2
 Wellington
 are on septic
 We test on
 1/20/05 by
 sewer
 maint

Lat. 9, Sub. 4, S.S. # 23

Mid-states Construction Company, Inc.

Jan. 16, 1970.

Project No. C23-61

Book: I.H.-69

201210A

CONSTRUCTION RECORD					SERVICE RECORD							
STATION	ELEVATION		Depth	MANHOLE	4-INCH "Y" BRANCHES		No. of Permit		House Number		DATE OF PERMITS	
	Ground	Grade			North West	South East	North West	South East	North West	South East	North West	South East
0+02 ^o	129.6	122.96	6.6	0+00	Exist. w/ stub N. Begin 8" Clay Pipe							
1+00	129.7	123.11	6.6		1+20 ^o		C40566		212 W, 33rd		8-13-73	
					1+42 ^o		C40567		3408 Fairview		8-13-73	
					1+53 ^o			C17667	3405 Wellington		1-16-70	
					1+85 ^o			C58856	3407 Wellington		11-29-76	
2+00	130.1	123.26	6.8		1+93 ^o		C47108		3412 Fairview		10-21-74	
					2+25 ^o							
	129.8	123.31	6.5	2+31 ^o	2+52 ^o							
					2+75 ^o							
					2+90 ^o							
3+00	130.8	123.41	7.4		2+83 ^o		C65474	#C19054	3414 Fairview	3411 Wellington	3-21-78	5-1-70
					2+90 ^o		7158		3416 Fairview		12-13-80	
					3+18 ^o			#C19055		3417 Wellington		5-1-70
					3+20 ^o							
					3+37 ^o		C19184		3418 Fairview		5-7-70	
4+00	130.0	123.56	6.4		3+99 ^o							
					4+01 ^o		C40783		3434 Fairview		8-21-73	
					4+37 ^o							
					4+39 ^o							
	130.0	123.69	6.3	4+83 ^o	4+91 ^o			#C20858		3455 Wellington Pl.		6-12-72
5+00					4+90 ^o							
					5+01 ^o							
	130.4	123.76	6.6	5+30 ^o	4" stub W.		2001-01578		3454 N Fairview		6-28-01	
6+00	130.5	123.86	6.6		6+08 ^o					3459 Wellington Pl.		6-11-73
					6+30 ^o							
7+00	130.0	124.01	6.0		7+24 ^o							
	130.2	124.09	6.2	7+24 ^o	7+37 ^o							
					7+51 ^o		1481		230 W 345 N	3503 Well. Pl.	10-10-80	9/15/71
8+00	130.5	124.15	6.4		8+48 ^o							
					8+86 ^o							
9+00	130.7	124.30	6.4		8+50 ^o		C64929	C52535	3508 Fairview	3509 Wellington Pl.	1-30-78	11-21-75
					9+03 ^o							
					9+33 ^o		C49637	C55742	3512 N. Fairview	3521 Wellington Pl.	5-23-75	6-4-76
					9+56 ^o		C52444		3510 N. Fairview		11-13-75	
10+00	130.0	124.45	5.6		10+09 ^o					3525 Wellington Pl.		2-26-70
	129.1	124.49	4.6	10+27 ^o	10+61 ^o							
					10+74 ^o		C18080					
					11+26.2		C18304		3516 Fairview		3-9-70	
11+00	129.3	124.60	4.7		11+15 ^o		24918	C72999		3527 Wellington	3-12-70	7-13-79
					11+23 ^o		C10277		3540512 Fairview		2-15-79	
					11+59 ^o							
					11+65 ^o		24929	00940 R	3544 R		9-3-03	8-7-80
					12+23 ^o		C50487		Fairview	3543 Wellington Pl.	7-23-75	
12+00	129.7	124.79	5.0		12+60 ^o							
			5.0		12+78 ^o		C40578					8-14-73
					12+23 ^o		C52774	2000-00905	3558 Fairview	3551 Wellington	12/11/75	41300
13+00	129.7	124.89	4.8		13+17 ^o	8" stub N.						
	129.6	124.93	4.7									

2000-00905-3551 N Wellington Pl - off septic 4/18/00 - tap 126.11 S. of MH 13+17.6 4" sch 40 PVC