


Extension of
Lat. 63, Sub. 4, S.S.#23
 Utility Contractors Inc.
 Jan. 19, 1970 Private Project
 Book: I.H-71

See L-28 for Coleman Sewer 801 E. 37th St. See map at Washington 129th intersection

80 E 37th Bldg add proposed - clay to top back to Bldg Sewer cannot tap M.H. 7-21-95 60'

NORTH
 Scale: 1" = 100'

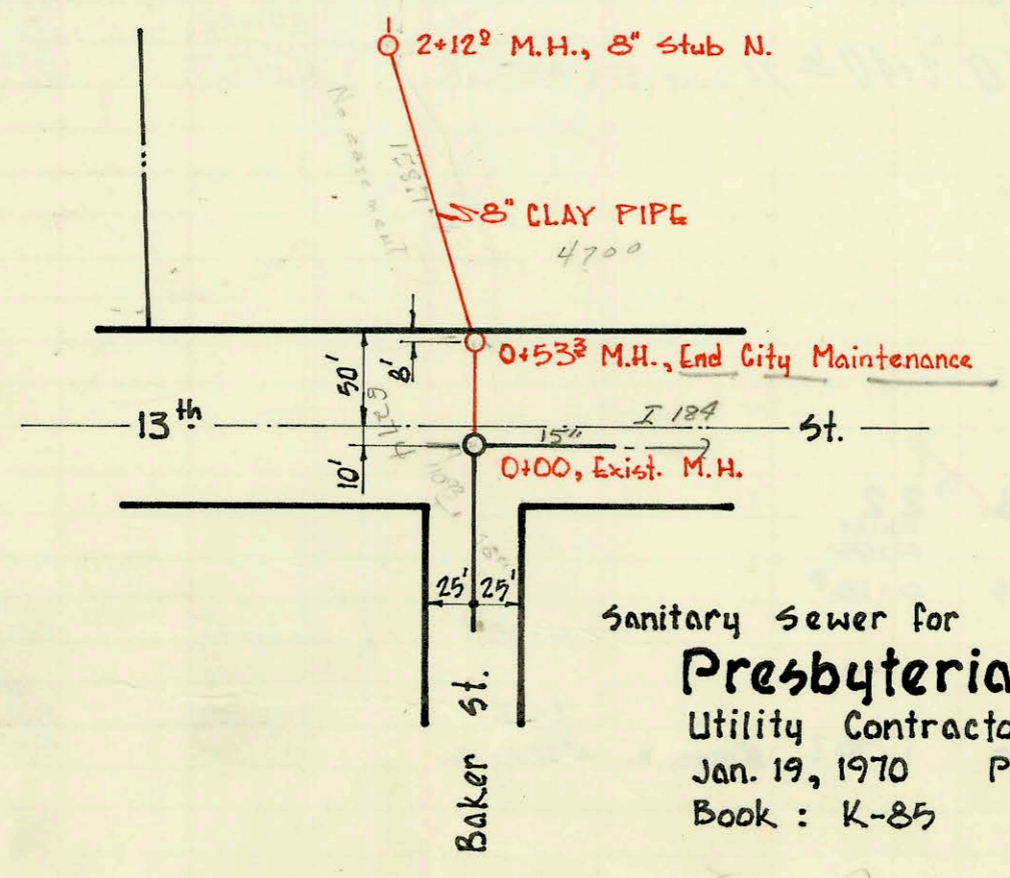

Sanitary Sewer for
Presbyterian Manor
 Utility Contractors, Inc.
 Jan. 19, 1970 Private Project
 Book: K-85

ON map

