


CONSTRUCTION RECORD

SERVICE RECORD

Lat. 12, Sub. 4, S.S. NO. 23.
 Mid-States Construction Company, Inc.
 Booked: April 29, 1970 from K-100
 Project No. C23-64

on map

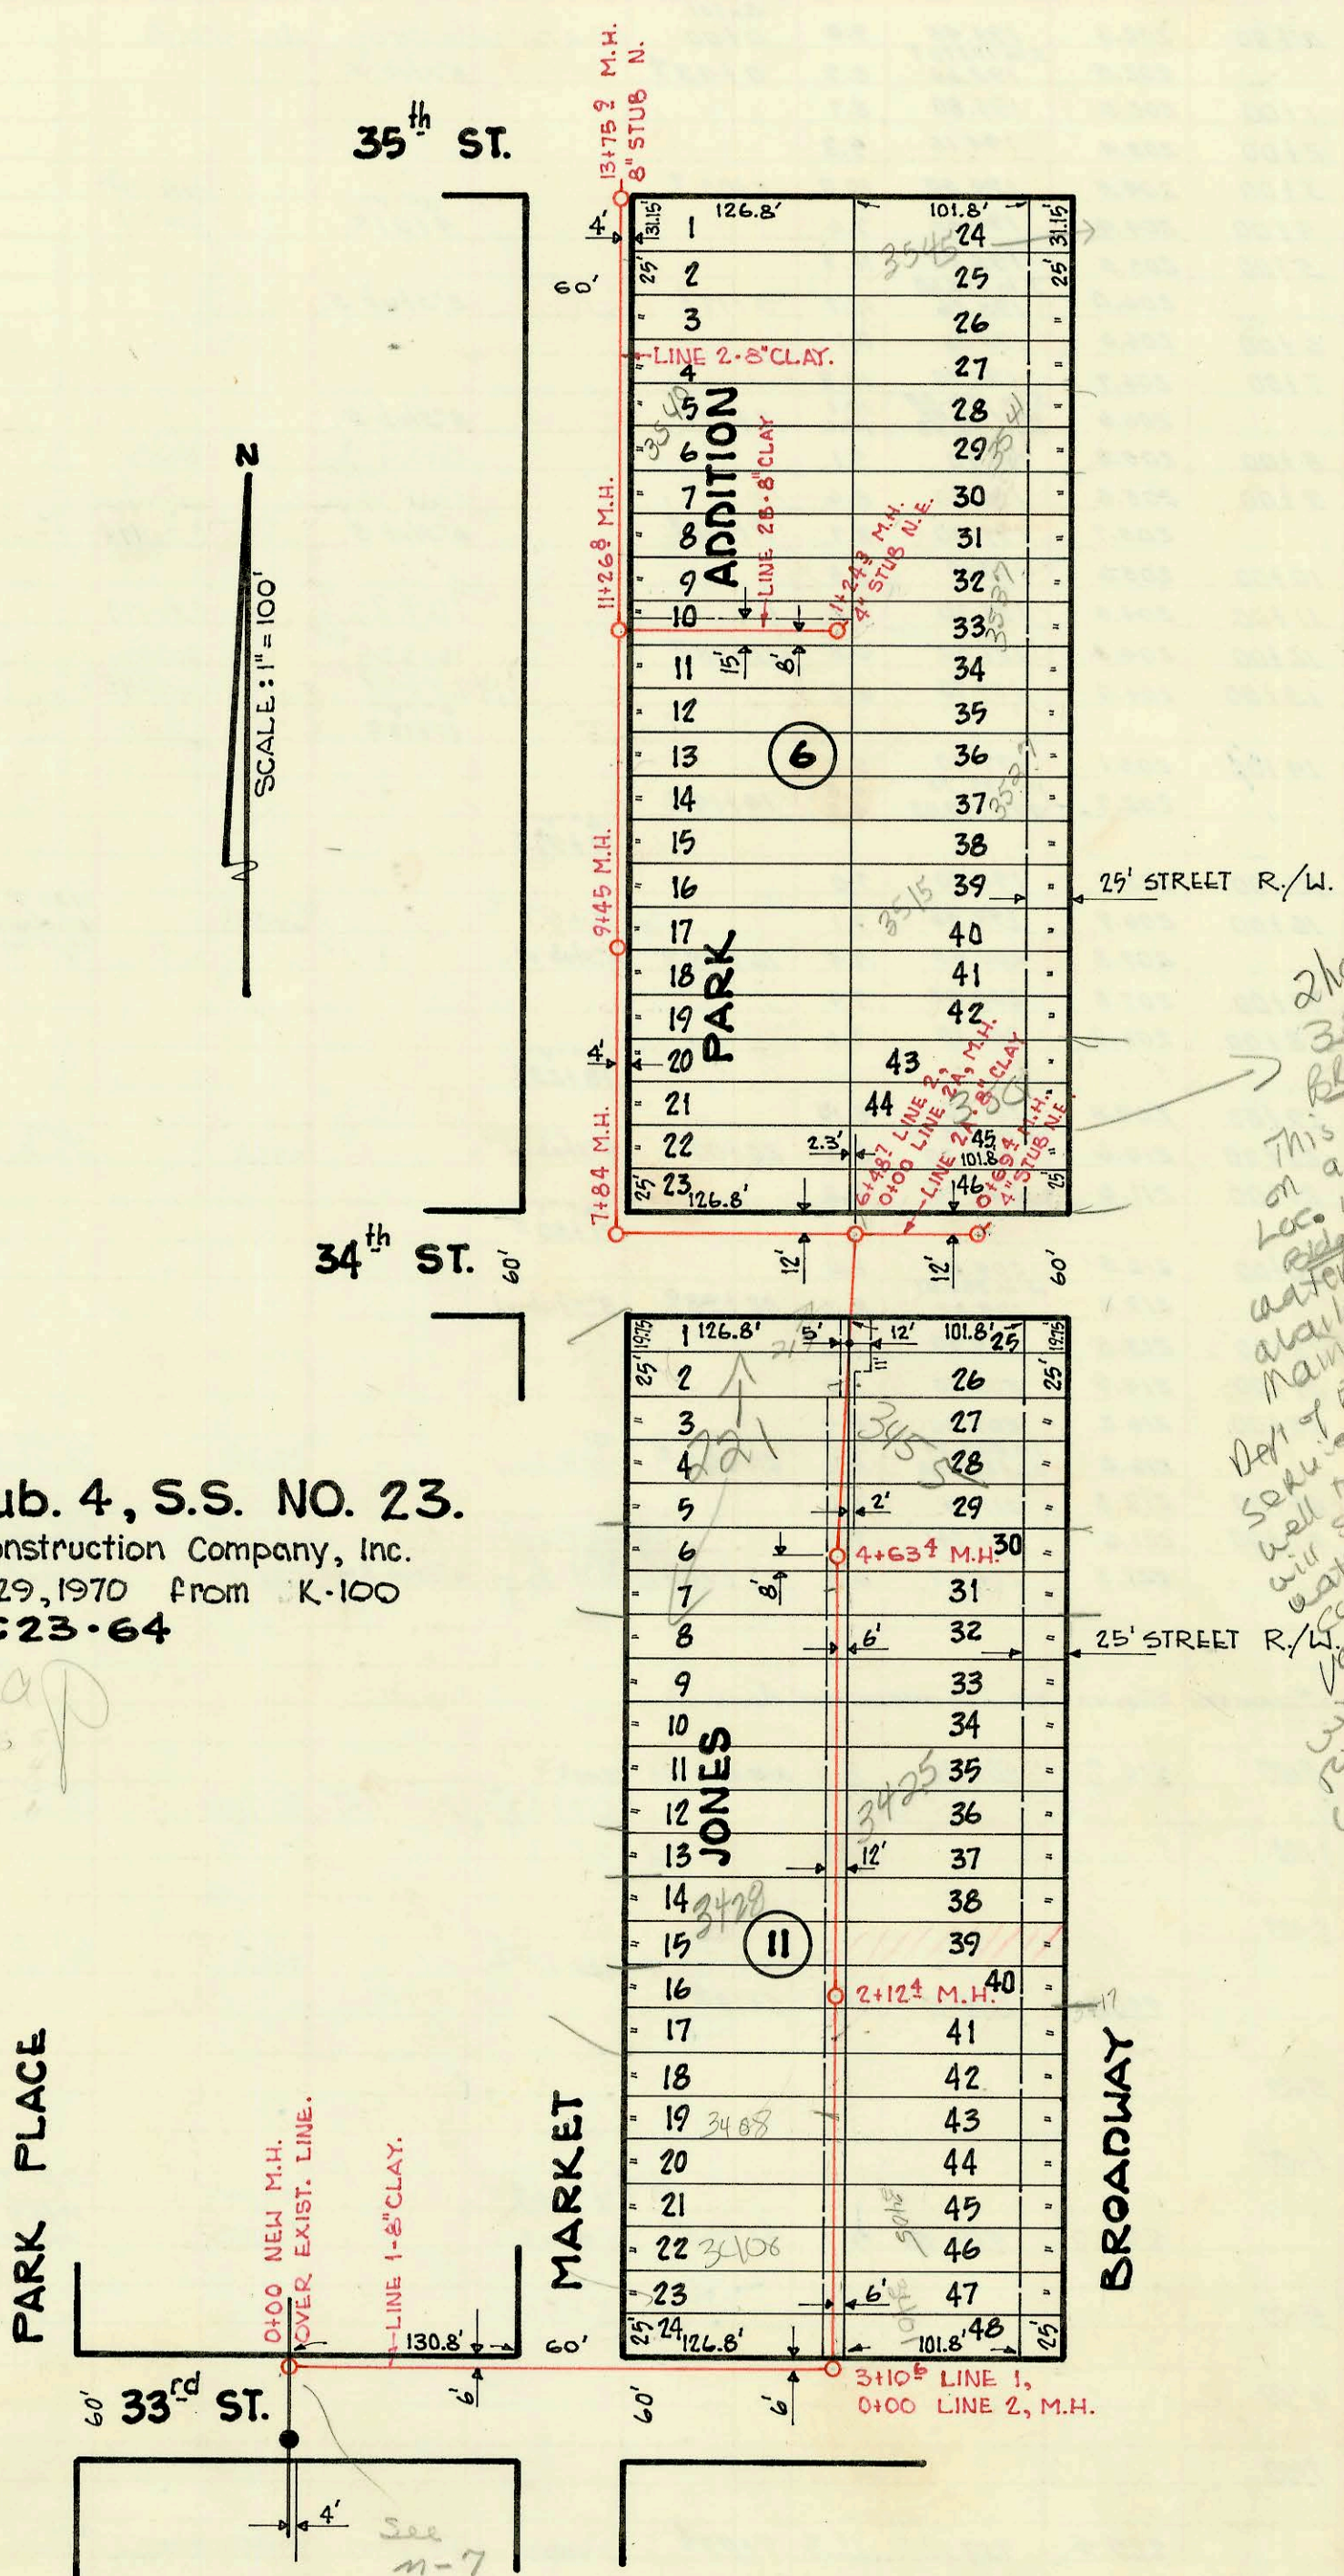

*2/10/10
 3507 N Broadway
 This Bldg is on a well loc. inside the Bldg. City water not available w/o main NAT sewer is at low will sample the water. If it contains Vee's - owned will be sent to Filtered City water BOM*

