


SERVICE RECORD

CONSTRUCTION RECORD

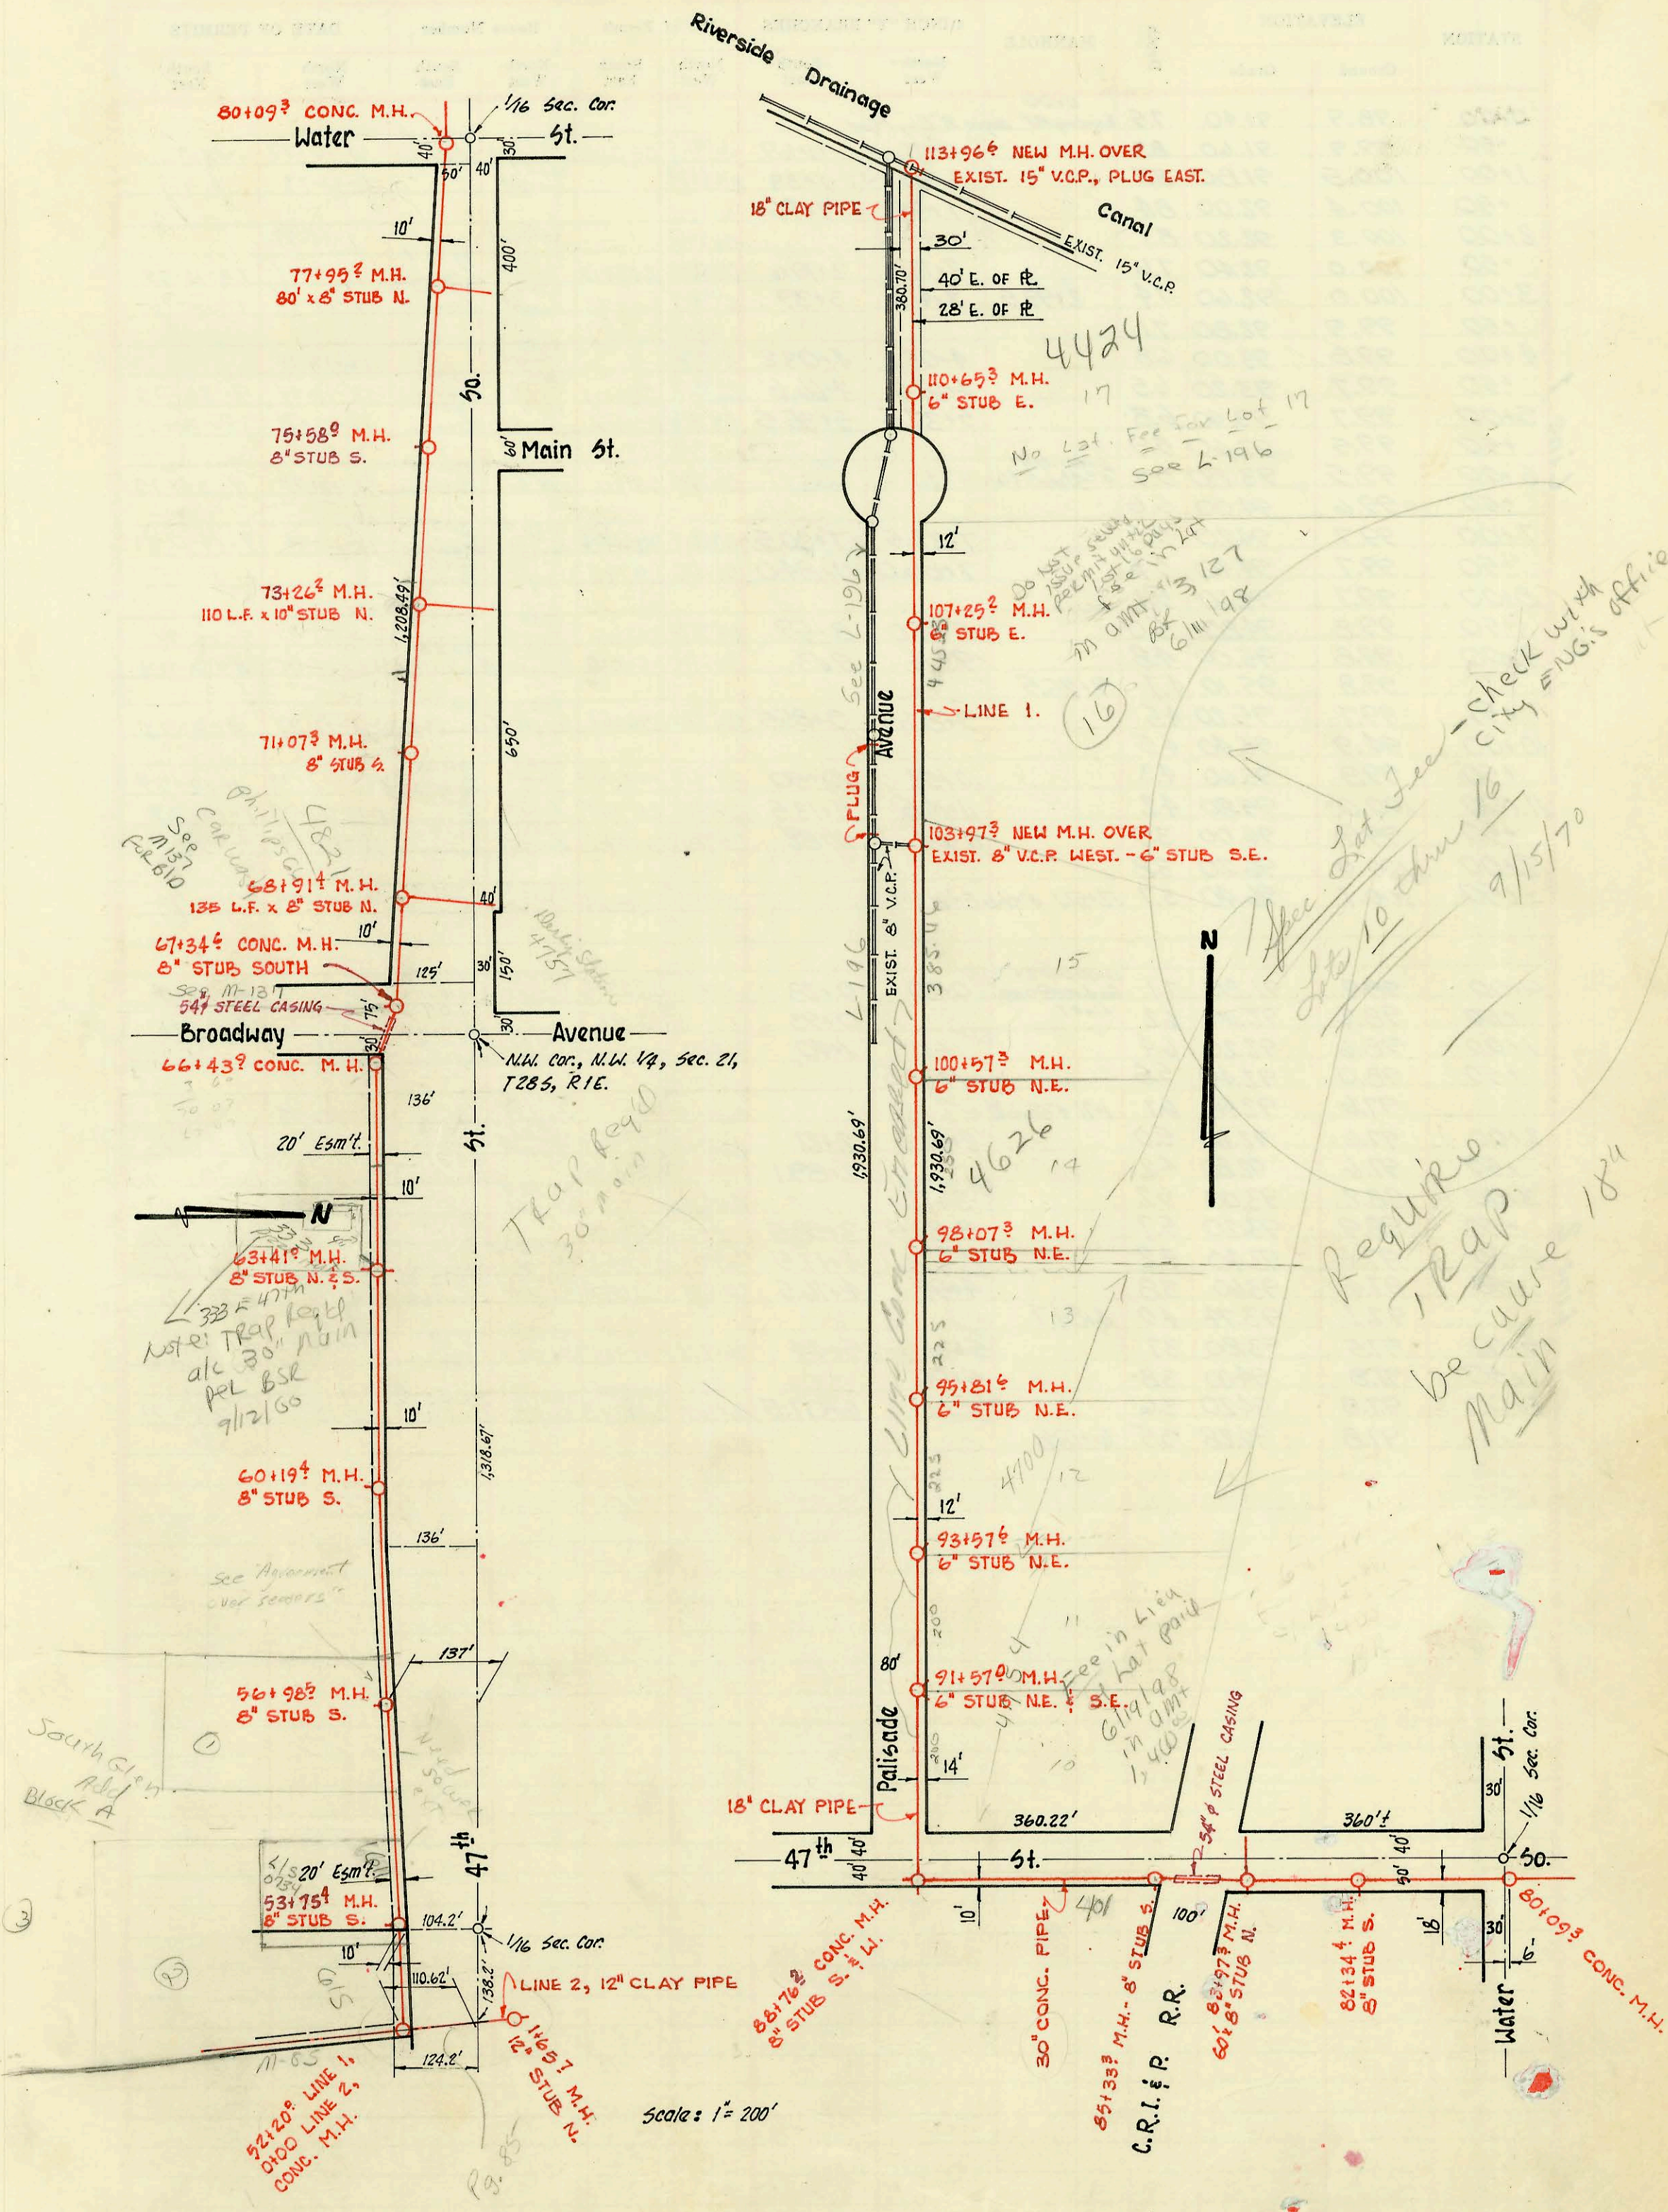

See M137  
CAL-610  
See Agreement  
over sewers

333 = 4774  
NOTE: TRAP RECD  
at 30" main  
REL BSR  
9/12/50

South Glen  
Add  
Block A

TRAP RECD  
30" main

4424  
17  
No Lot Fee for Lot 17  
See L-196

Do not seal  
pot hole  
in dirt  
6/11/98

Spec Lot Fee - check with  
City Eng's office  
9/15/70

Require  
TRAP  
be cause 18"

see in Lien  
hat pond  
in dirt  
1,400

Scale: 1" = 200'

Sur 2003-0828 2/11/03  
4626 S Palisade - BRAND  
4" PVC tied new plbg into ex st SPR  
full 1/4", shallow, 4" twinco@ bldg 3145

*JAMPA*

CONSTRUCTION RECORD						SERVICE RECORD						
STATION	ELEVATION		Depth	MANHOLE	4-INCH "Y" BRANCHES		No. of Permit		House Number		DATE OF PERMITS	
	Ground	Grade			North West	South East	North West	South East	North West	South East	North West	South East
<b>LINE 1</b>												
53+00	81.6	70.40	11.2									
	82.6	70.48	12.1	53+75 <sup>4</sup>		8" STUB So.						
54+00	83.0	70.50	12.5									
55+00	82.4	70.60	11.8									
56+00	83.3	70.70	12.6									
	83.8	70.80	13.0	56+98 <sup>5</sup>		8" STUB So.						
58+00	83.8	70.90	12.9									
59+00	83.8	71.00	12.8									
60+00	84.0	71.10	12.9									
	84.2	71.12	13.1	60+19 <sup>4</sup>		8" STUB So.						
61+00	84.6	71.20	13.4			4" SCH 40 1" 1000 GAL 4" SCH 40 9" STUB S		2000 Grease Interceptor	3335 47th 332 E 47th		9-21-00	
62+00	84.3	71.30	13.0									9-21-00
63+00	83.0	71.40	11.6									
	83.4	71.44	12.0	M.H. TAP 63+41 <sup>5</sup>	8" STUB No.	8" STUB So.		SWP 250 0246 C61712	333 E. Pkwy 47th Street			4-12-00 6-22-77
64+00	84.1	71.50	12.6									
65+00	85.0	71.60	13.4									
66+00	86.0	71.70	14.3									
	86.6	71.75 out 71.76 in	14.9	CONC. 66+43 <sup>5</sup>								
67+00	87.1	71.83	15.3									
	86.5	71.88	14.6	CONC. 67+34 <sup>6</sup>		8" STUB So.						
68+00	85.1	71.97	13.1									
	84.6	72.10	12.5	M.H. TAP 68+91 <sup>4</sup>	8" STUB No.			19013	4821 S (Phillips Boulevard)		9-9-87	
69+00	84.6	72.11	12.5									
70+00	84.7	72.25	12.5					19014	4821 S (Garwood Boulevard)		9-9-87	
71+00	84.9	72.39	12.5									
	84.9	72.40	12.5	71+07 <sup>3</sup>		8" STUB So.		08751947	245 47th ATA - 47th Hollywood Viduo		8-14-98	
72+00	85.3	72.53	12.7									
73+00	85.4	72.67	12.7									
	85.4	72.71	12.7	73+26 <sup>2</sup>		10" STUB No.						
74+00	85.0	72.81	12.2									
75+00	84.8	72.95	11.8									
	84.6	73.03	11.6	75+58 <sup>2</sup>		8" STUB So.						
76+00	84.4	73.09	11.3									
77+00	84.4	73.23	11.2									
	85.4	73.36	12.0	77+95 <sup>2</sup>		8" STUB No.						
79+00	85.8	73.51	12.3									
80+00	85.0	73.65	11.3									
	85.1	73.66	11.4	CONC. 80+09 <sup>3</sup>								
81+00	85.0	73.79	11.2									
82+00	85.0	73.93	11.1									
	85.1	73.98	11.1	82+34 <sup>4</sup>		8" STUB So.						
83+00	85.1	74.07	11.0									
	86.0	74.21	11.8	83+97 <sup>3</sup>		8" STUB No.						
85+00	85.6	74.35	11.2									
	86.0	74.40	11.6	85+33 <sup>3</sup>		8" STUB So.						
86+00	86.7	74.49	12.2									
87+00	87.0	74.63	12.4									
88+00	87.5	14.77 74.87 out 75.86 in	12.7/11.7	CONC. 88+76 <sup>2</sup>	8" STUB W.	8" STUB So.		C39396	M.H. Tap 401 47th St. So.		Rec. #467642 (Spec. Lat. Assessment Fee 100) 6-6-73	
89+00	89.7	75.88	13.8									
90+00	88.8	75.98	12.8									
91+00	88.7	76.08	12.6									
	88.8	76.14	12.7	91+57 <sup>2</sup>	6" STUB N.E.	6" STUB S.E.		810827	4754 Palisade		6-14-98	
92+00	88.7	76.18	12.5									
93+00	88.5	76.28	12.2									
	88.4	76.34	12.1	93+57 <sup>6</sup>	6" STUB N.E.			TAP C20996	4700 Palisade		Spec. Lat. Assmt Fee 100 Rec. #73213 9-22-70	
94+00	88.3	76.38	11.9									
95+00	88.1	76.48	11.6									
	88.0	76.57	11.4	M.H. TAP 95+81 <sup>6</sup>	6" STUB N.E.			1138	4700 Palisade		9-4-80	
96+00	88.0	76.58	11.4									
97+00	87.8	76.68	11.1									
	87.5	76.78	10.7	98+07 <sup>3</sup>		6" STUB N.E.						
99+00	87.3	76.88	10.4									
100+00	87.1	76.98	10.1									
	87.0	77.04	10.0	100+57 <sup>3</sup>		6" STUB N.E.		712517	4626 Palisade	Fee of 1925 <sup>00</sup> 5-12-94		
101+00	86.9	77.08	9.8									
102+00	86.7	77.18	9.5									
103+00	86.5	77.28	9.2									
	86.4	77.38	9.0	103+97 <sup>3</sup>	EXIST. 8" V.C.P. WEST	6" STUB S.E.						
105+00	86.2	77.48	8.7									
106+00	86.0	77.58	8.4									
107+00	85.8	77.68	8.1									
	85.7	77.71	8.0	107+25 <sup>3</sup>		6" STUB E.						
108+00	85.6	77.78	7.8									
109+00	85.0	77.88	7.1									
110+00	85.6	77.98	7.6									
	85.8	78.05	7.8	110+65 <sup>3</sup>		6" STUB E.		2000 01005	4421 Palisade		42500	
111+00	85.6	78.08	7.5									
112+00	86.3	78.18	8.1									
113+00	87.4	78.28	9.1									

Addn.