



Two corner parcels at
 Laura Street
 MacArthur
 Private
 Lateral
 9-80
 9-81
 212310
 65K

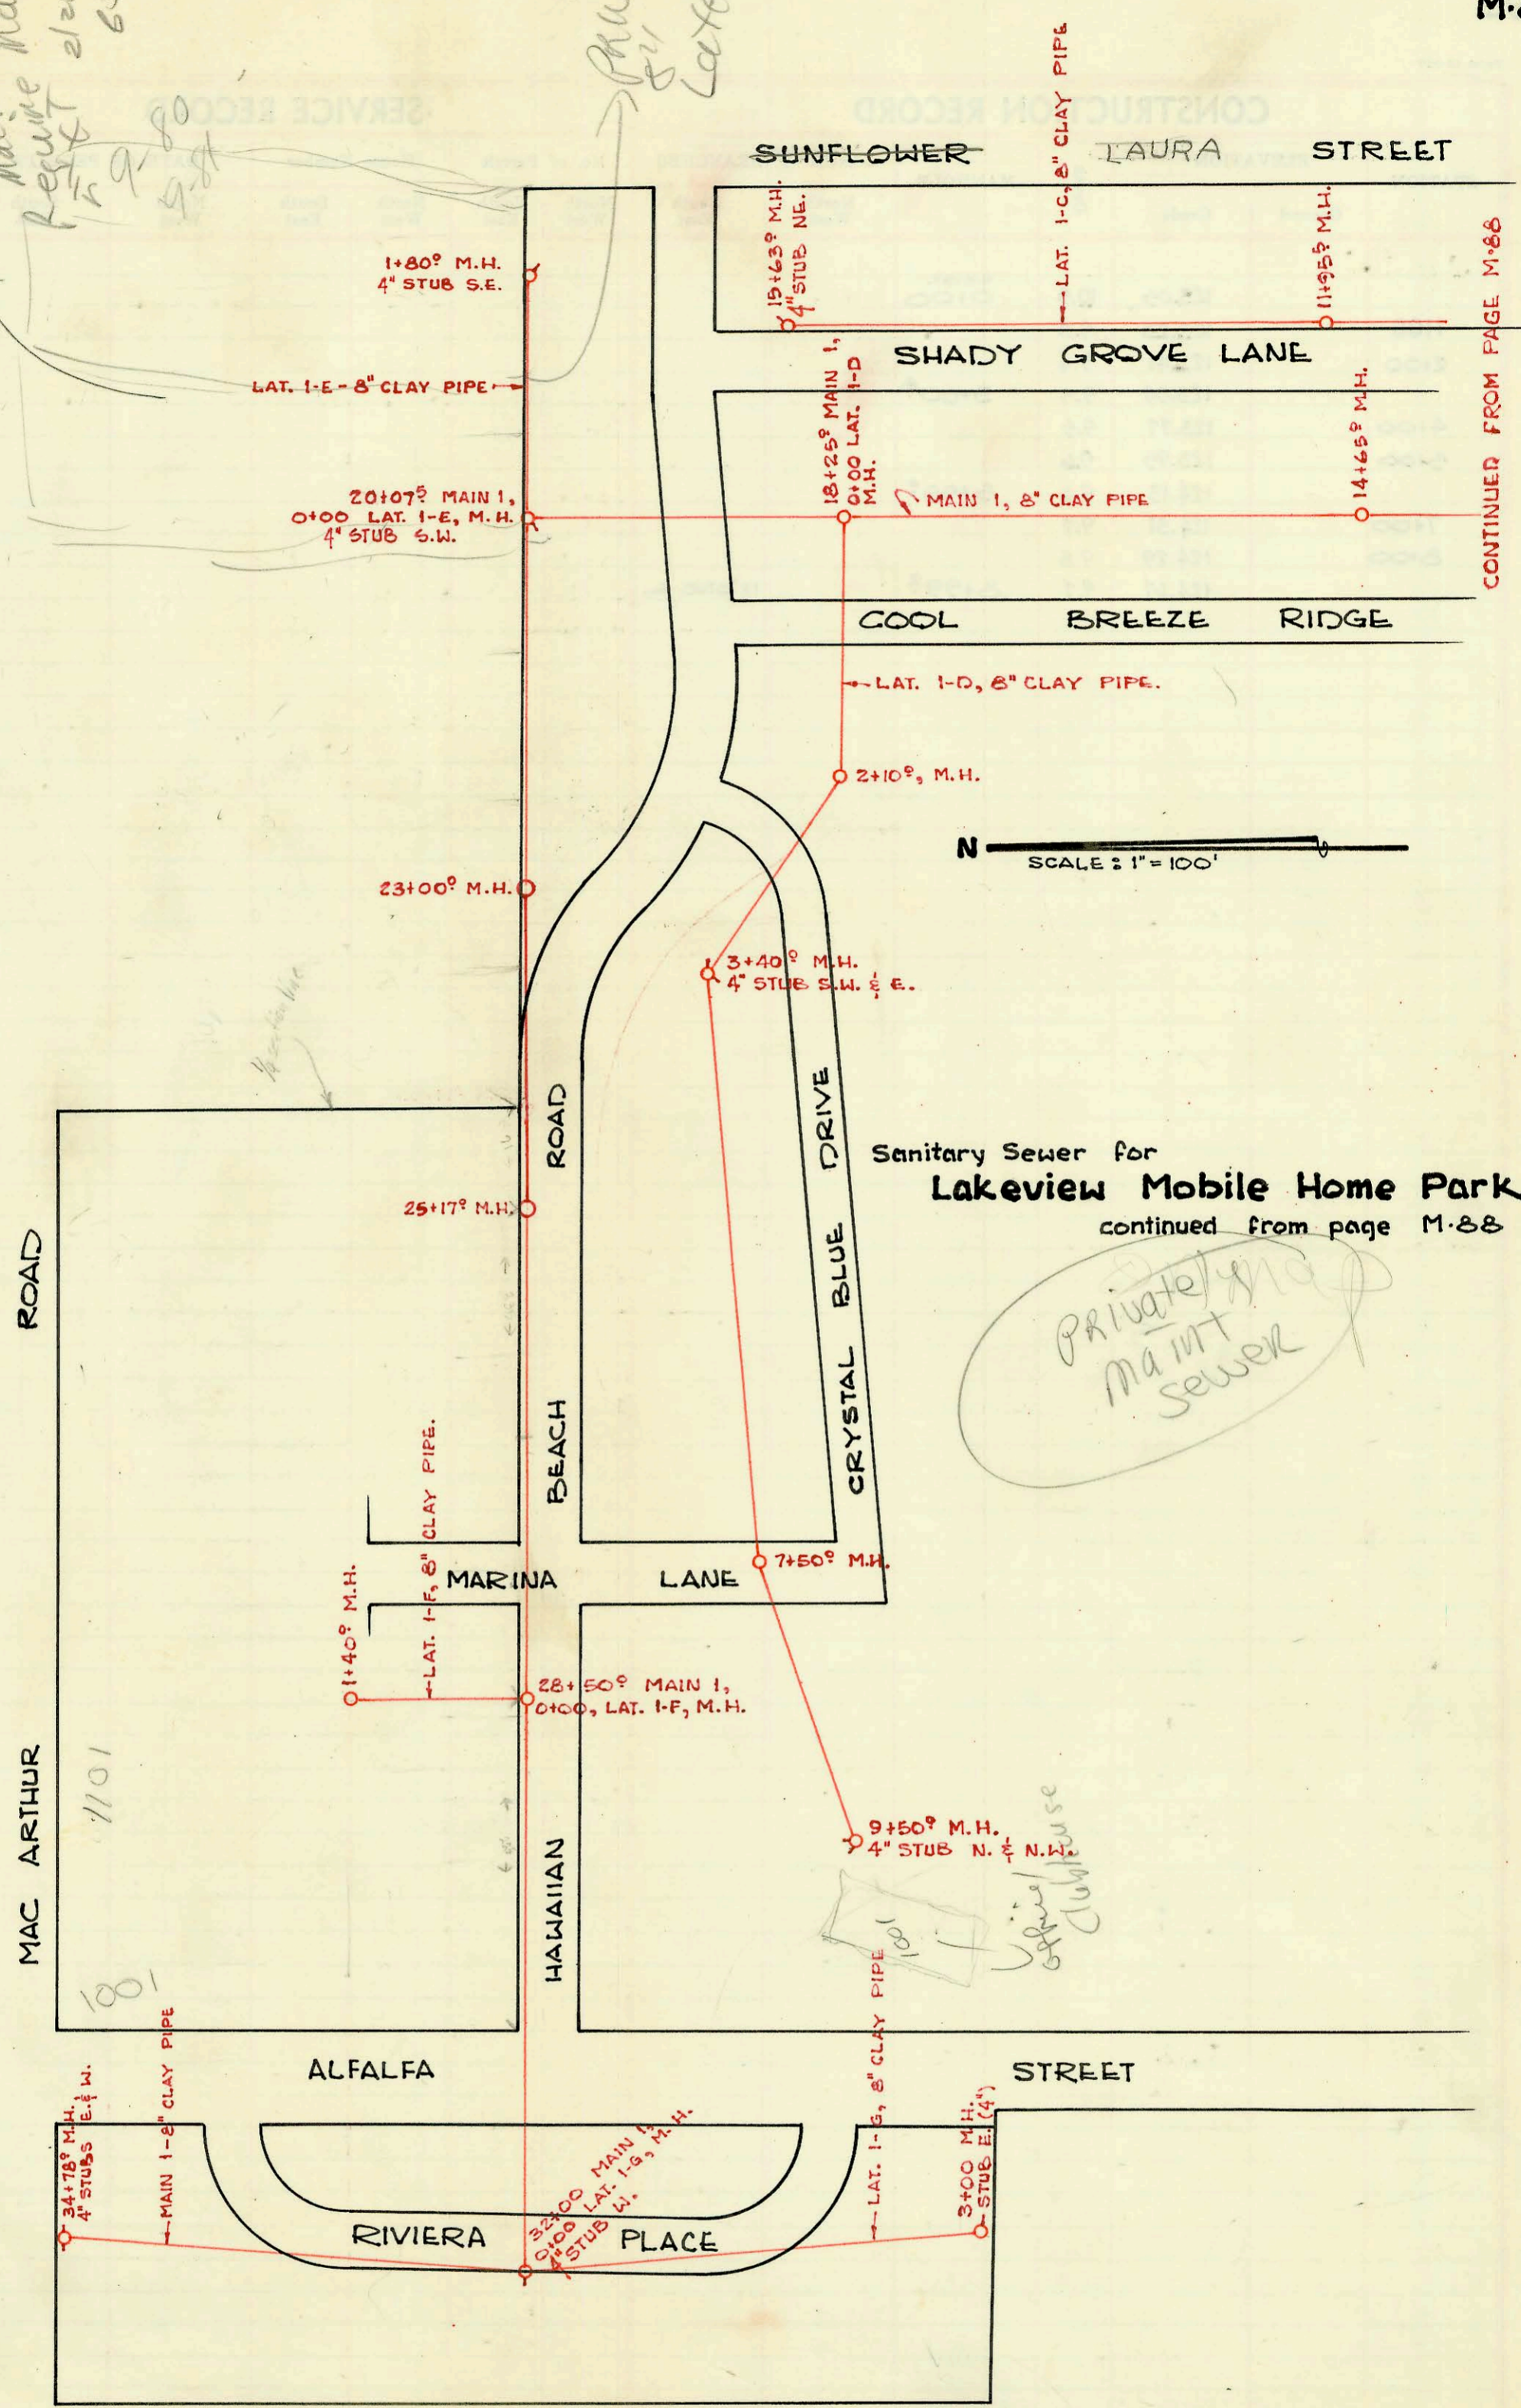

Sanitary Sewer for
Lakeview Mobile Home Park
 continued from page M-88

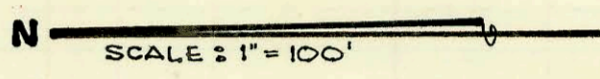

Private Maint Sewer

Office Clubhouse

7191-1121 E MacArthur-12-16-82 Mike Bratcher 20+07.5 (21+67.9) (157.4W) No. 1
 #12028-1003 E MacArthur Lot 22-Richard Hardison 9-28-81-23+00.0 W (62.5) -23+2.5?
 #18427-62-87-1101 E MacArthur-Rep (Tied into existing line 40' from house.-existing line was installed by Bogges in 1986)
 92-43657-7 12-2-92 1121 E. Mac Arthur (Trailer to tie into house Rdy line) tied onto existing house line between trailer and commercial building) (4" PVC 4V 1/4" Fall)

CONSTRUCTION RECORD						SERVICE RECORD						
STATION	ELEVATION		Depth	MANHOLE	4-INCH "Y" BRANCHES		No. of Permit		House Number		DATE OF PERMITS	
	Ground	Grade			North West	South East	North West	South East	North West	South East	North West	South East
Lat. 1-D		81.29	5.5	0+00°	(18+25°, MAIN 1)							
1+00		81.49	5.8			1+72°	C16866		Lot 47		11-17-69	
		81.72	5.2	2+10°								
3+00		81.90	5.0									
		81.98	5.0	3+40°	4" STUB S.W.	4" STUB E.	C16871	C16872	Lot 42	Lot 41		11-17-69
					3+52°		C16873		Lot 40			
4+00		82.10	5.1		4+01°	4+18°		C16870		Lot 43		
					4+50°		C16874		Lot 39			
5+00		82.30	5.3		5+00°	5+03°	C16875	C16869	Lot 38	Lot 44		
					5+50°	5+79°	C16876	C16868	Lot 37	Lot 45		
6+00		82.49	5.2		6+00°		C16877		Lot 36			
					6+50°	6+59°	C16878	C16867	Lot 35	Lot 46		
7+00		82.69	5.0		7+17°		C16879		Lot 34			
		82.79	5.0	7+50°								
8+00			4.8		8+27°		C16880		Lot 22			
9+00			4.4									
		83.59	4.2	9+50°	4" STUB N.	4" STUB N.W.	C16881	C16882	Lot 21	Lot 20		
Lat. 1-E		83.13	4.8	0+00	(20+07°, MAIN 1)							
1+00		83.57	4.8			0+52°		C16843		Lot 53		
						1+06°		C16844		Lot 54		
		83.93	4.6	1+80°		1+57°		C16845		Lot 55		
						4" STUB S.E.		C16846		Lot 56		
Lat. 1-F		83.56	4.8	0+00	(28+50°, MAIN 1)							
						0+47°		C16841		Lot 26		
1+00		83.75	4.1			0+89°		C16842		Lot 28		
		83.83	4.7	1+40°								
Lat. 1-G		84.24	3.3	0+00	(32+00° MAIN 1)							
						0+34°	C16832		Lot 9			
1+00		84.44	3.2			0+86°	C16833	C16839	Lot 10	Lot 16		
						1+33°	C16834		Lot 11			
2+00		84.65	3.0			1+74°	C16835		Lot 12			
						2+04°	C16836		Lot 13			
		84.85	3.0	3+00		2+57°	C16837		Lot 14			
						4" STUB E.		C16838		Lot 15		
Main 2		77.35		0+00	(0+00, MAIN 1)							
1+00		77.55				1+59°		C16863		Lot 148		
		77.69		1+70°	4" STUB S.W.		C16865		Lot 163			
						1+75°		C16864		Lot 164		
2+00		77.75										
3+00		77.94										
		78.12		3+91°		4" STUB N.E.		C16888		Lot 165		
						4+30°	C16903		Lot 166			
5+00		78.38				4+81°	C16904		Lot 167			
						5+23°	C16905		Lot 168			
6+00		78.61				5+74°	C16906		Lot 169			
						6+32°	C16907		Lot 170			
7+00		78.78		6+70°		6+98°	C16908		Lot 171			
		78.84				7+60°	C16909		Lot 172			
8+00						7+82°	C16910		Lot 173			
9+00		79.03				8+43°	C16911		Lot 174			
		79.23										
		79.32 OUT										
		79.43 IN										
10+00		79.54		9+46°		4" STUB N.E.		C16912		Lot 175		
						10+33°		C16914		Lot 176		
						10+84°		C16913		Lot 177		
11+00		79.74				11+22°		C16915		Lot 178		
						11+69°		C16916		Lot 179		
12+00		79.94				12+20°		C16917		Lot 180		
		80.01		12+35°								
						12+67°		C16918		Lot 181		
13+00		80.27				13+24°		C16919		Lot 182		
						13+66°		C16920		Lot 183		
14+00		80.67				14+28°		C16921		Lot 184		
		81.07		15+00°	4" STUB N.E.	4" STUB S.E.	C16923	C16922	Lot 186	Lot 185		
Lat. 2-A		77.81	6.4	0+00	(1+70° MAIN 2)							
						0+42°	C16889	C16902	Lot 149	Lot 162		
						0+91°	C16890	C16901	Lot 150	Lot 161		
1+00		78.20	6.0			1+40°	C16891	C16900	Lot 151	Lot 160		
						1+89°	C16892	C16899	Lot 152	Lot 159		
2+00		78.68	5.6			2+48°	C16893	C16898	Lot 153	Lot 158		
3+00		78.99	5.1			3+01°	C16894	C16897	Lot 154	Lot 157		
						3+36°		C16895		Lot 155		
		79.27	4.6	3+70°	4" STUB N.W.		C16896		Lot 156			