


Sanitary Sewer for the Pines
 ALLIED CONSTRUCTION COMPANY
 BOOKED FROM PLAN, AUG. 24, 1970.

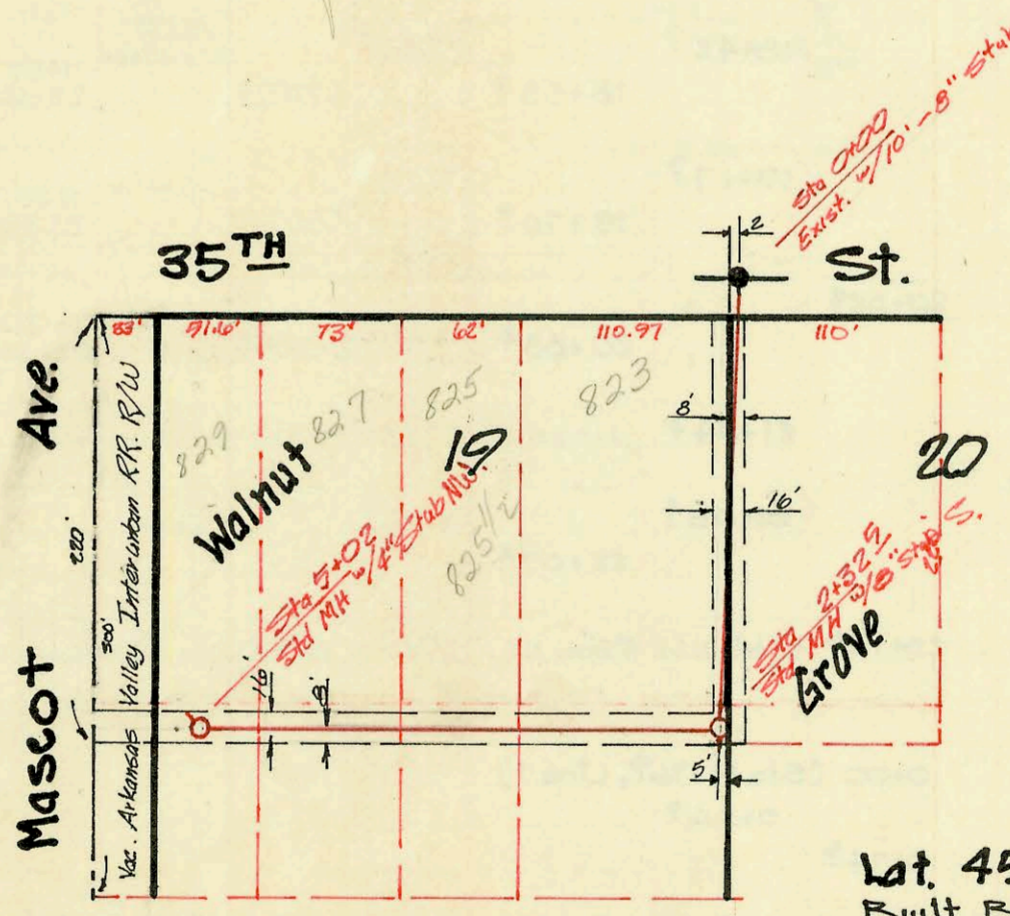

Lat. 45, Sub. 4, SS # 23
 Built By: Utility Contractors Inc.
 Booked: 11 Jan 71 from IH-76
 Proj. No. C25-15

on map

