
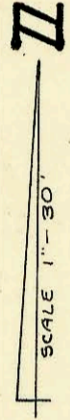


Douglas

Avenue


Street

Avenue

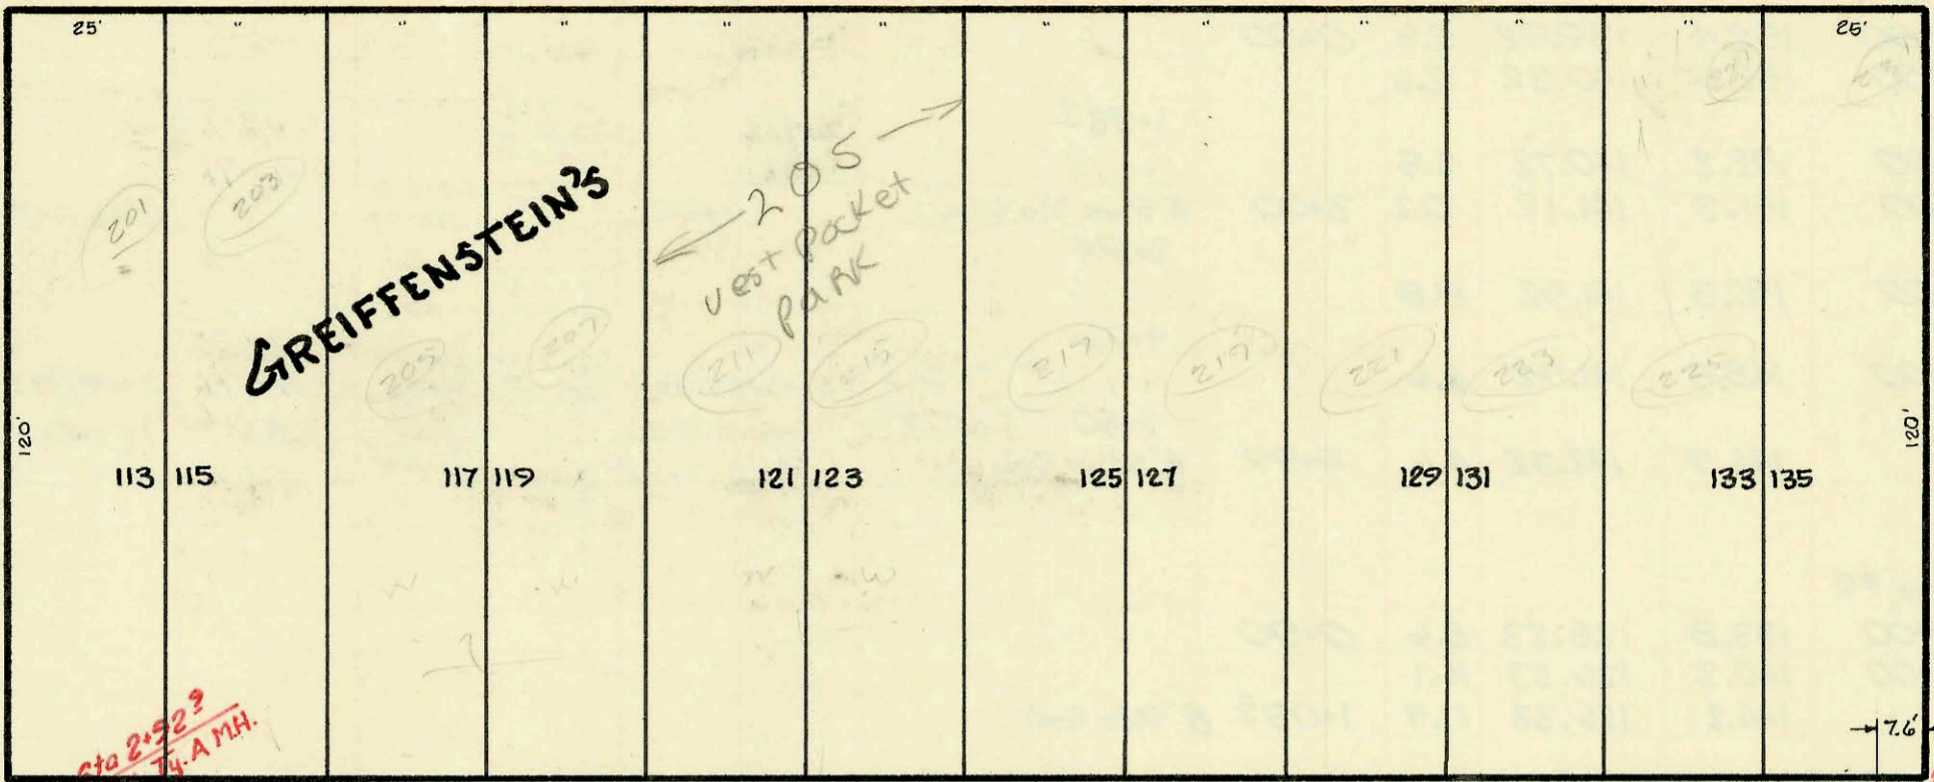

Market

Broadway

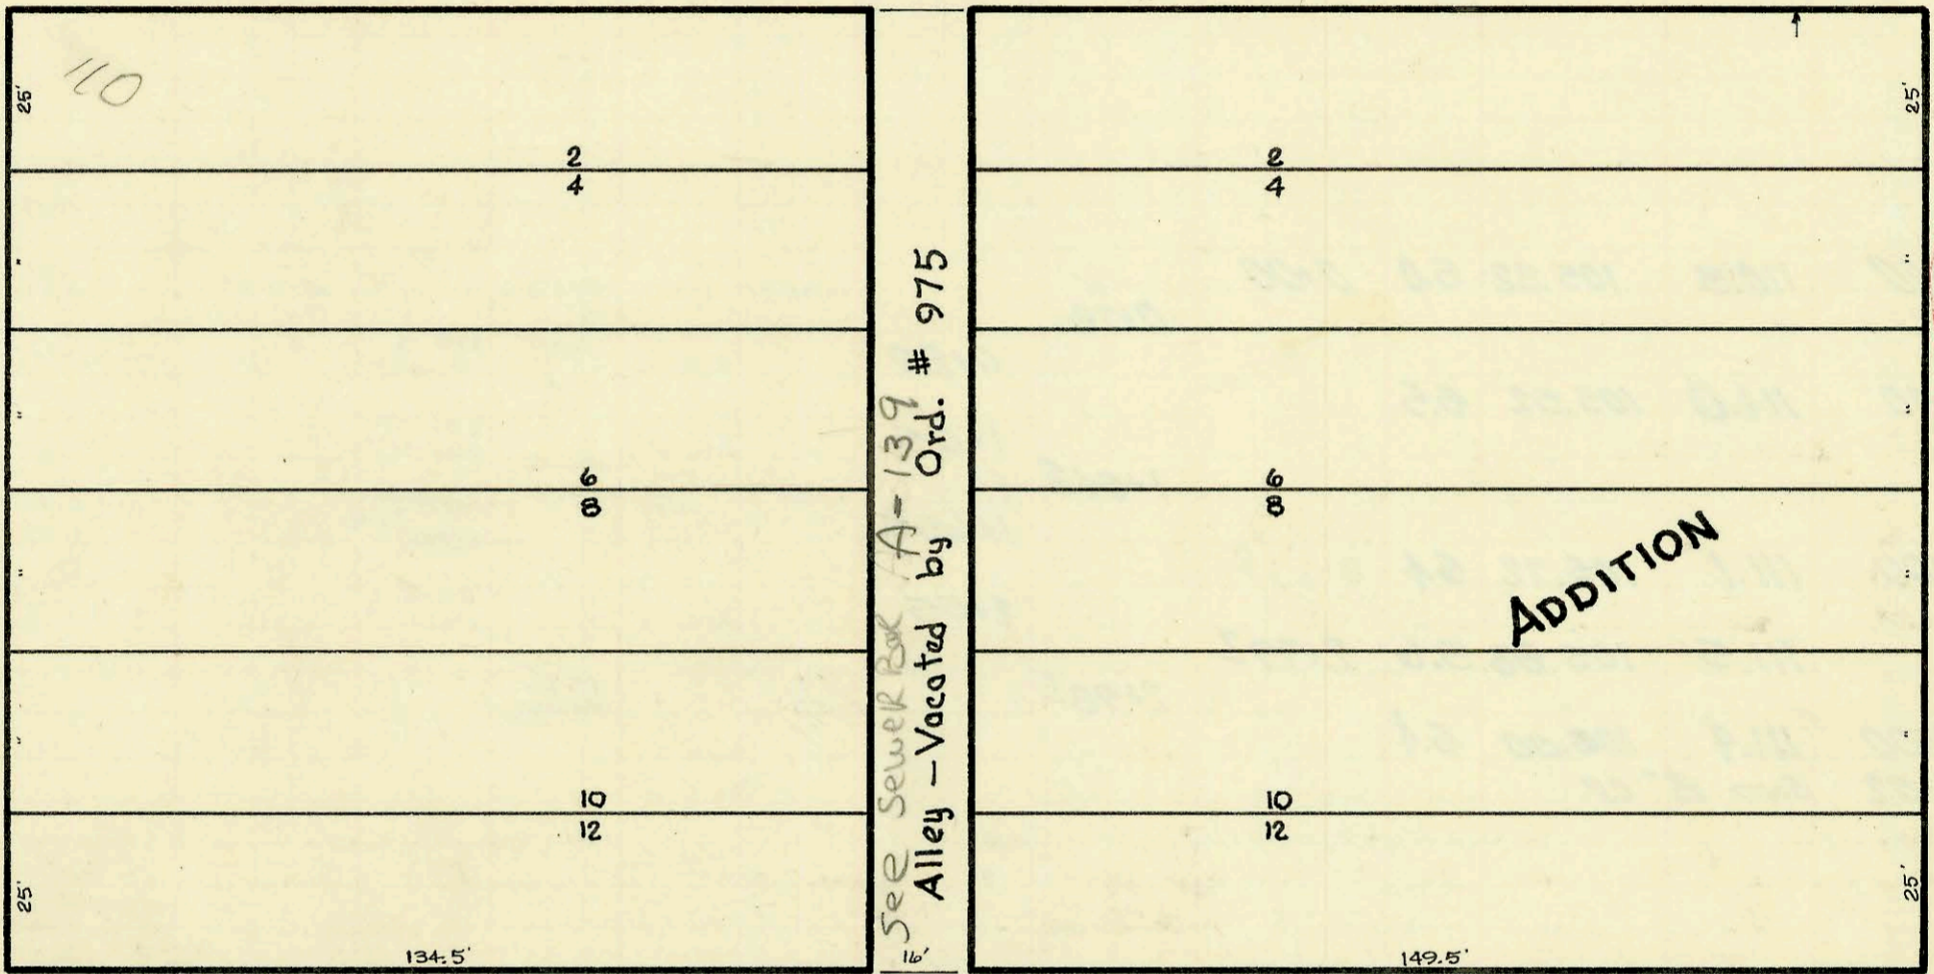

See Sewer Box A-135 and A-139


William

Street

Sunnybrook

Lane

Rebuilding & Reconstruction of Portion of West Submain B, Sanitary Sewer #1  
 Mid-States Construction Company, Inc.  
 Booked: Sept 23, 1970 from JAK 55#8  
 Project No. C29-44  
 ON MAP

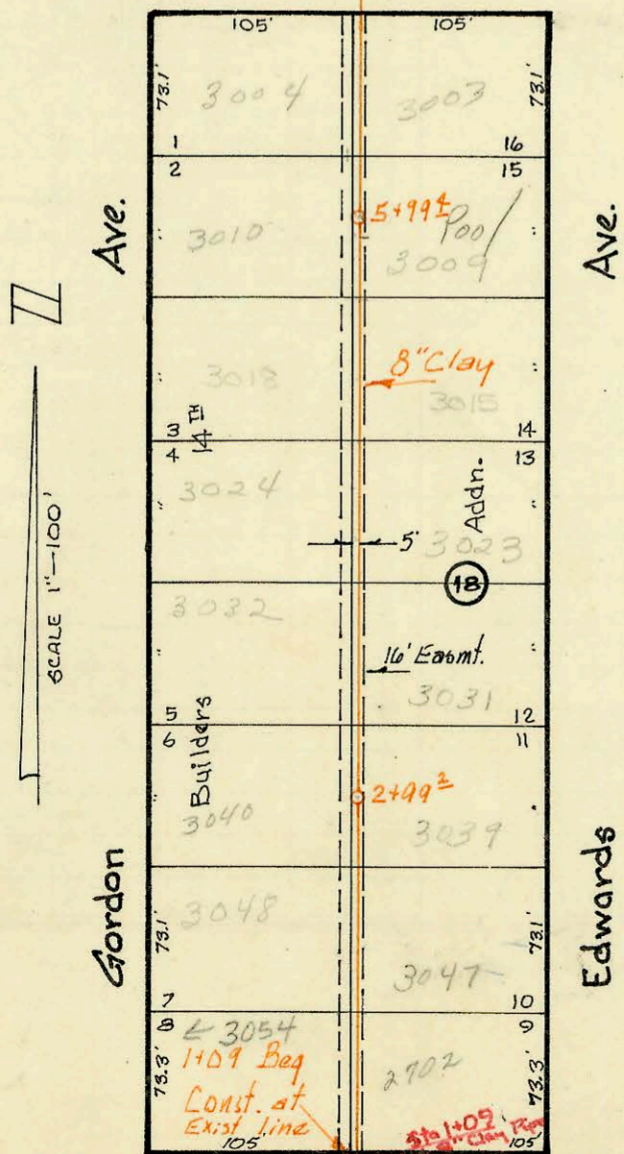

Lat 109 San. Sew. 22  
 Built by: Mid-States Const. Co.  
 Booked 2-5-74 from 55#13 Jk.  
 Proj. No. DBKL568009  
 ON MAP

0+00 Exist MH

30th St.

So. Out Box 8" Clay Pipe

Lat 109, 55#22

W.B. Carter Construction Co.  
 Booked: Sept 24, 1970 from JAK 55#11  
 Proj No. C28-9

See Sheet J-106

