


No connection to this manhole until easement has been provided. See Don Schneider.

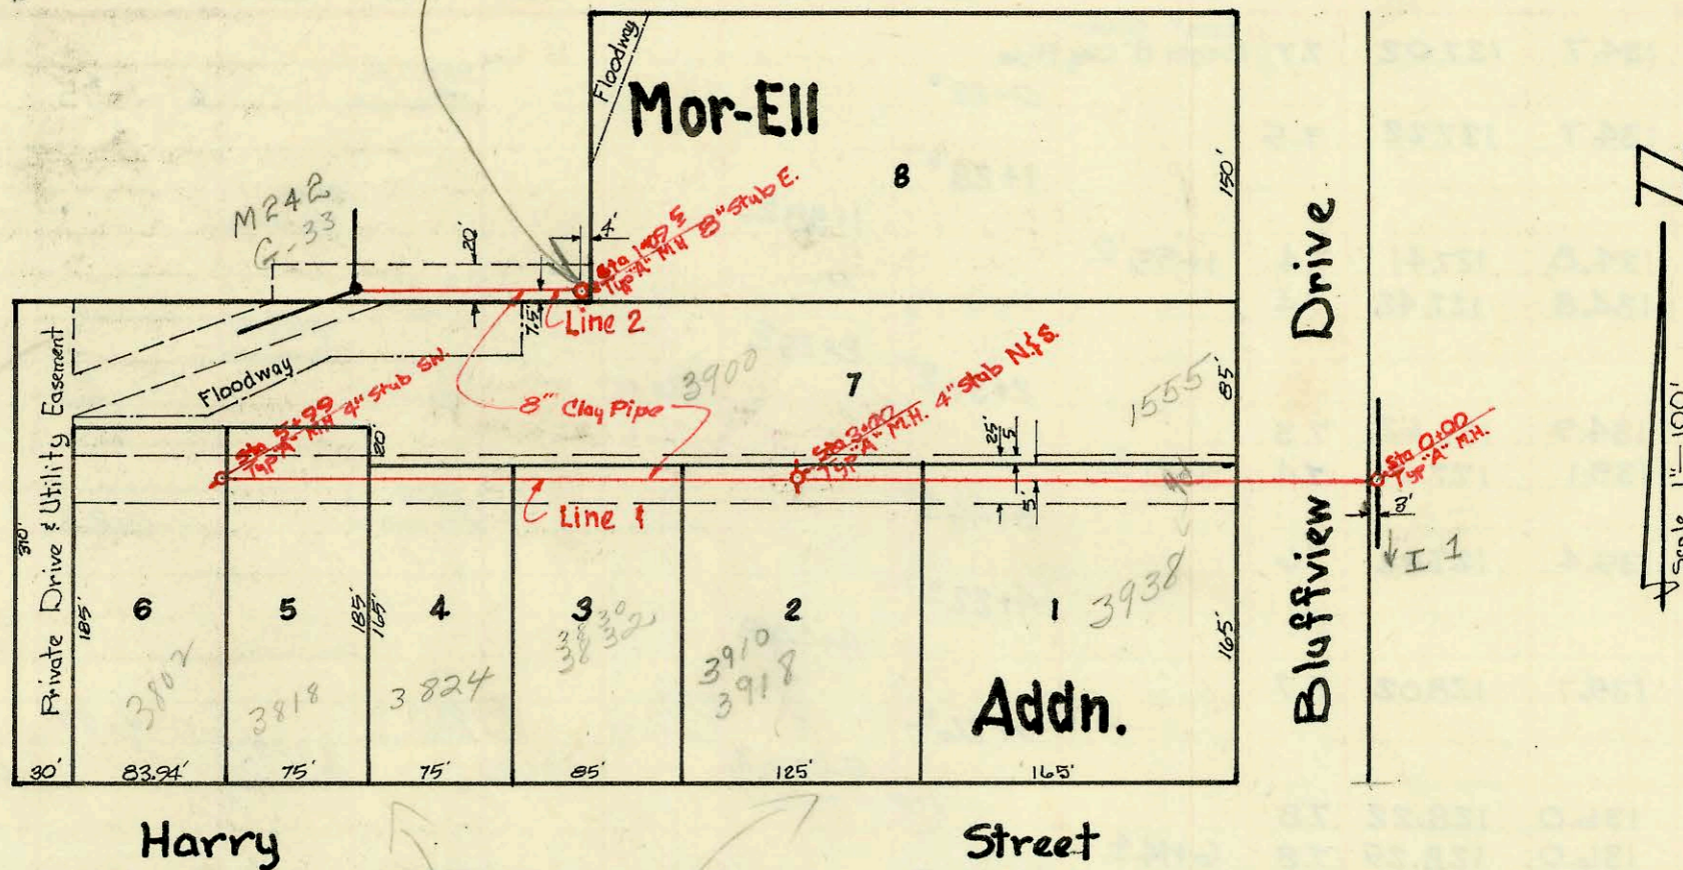


NOTE: Lots 1, 3, 4 & 5 to have "Free Tap".

Lat 17, Sub W, SS. 12

W. B. Carter Construction Company Inc.  
Booked Oct 5, 1970 from IH-72  
Proj No. C29-71

*on map*

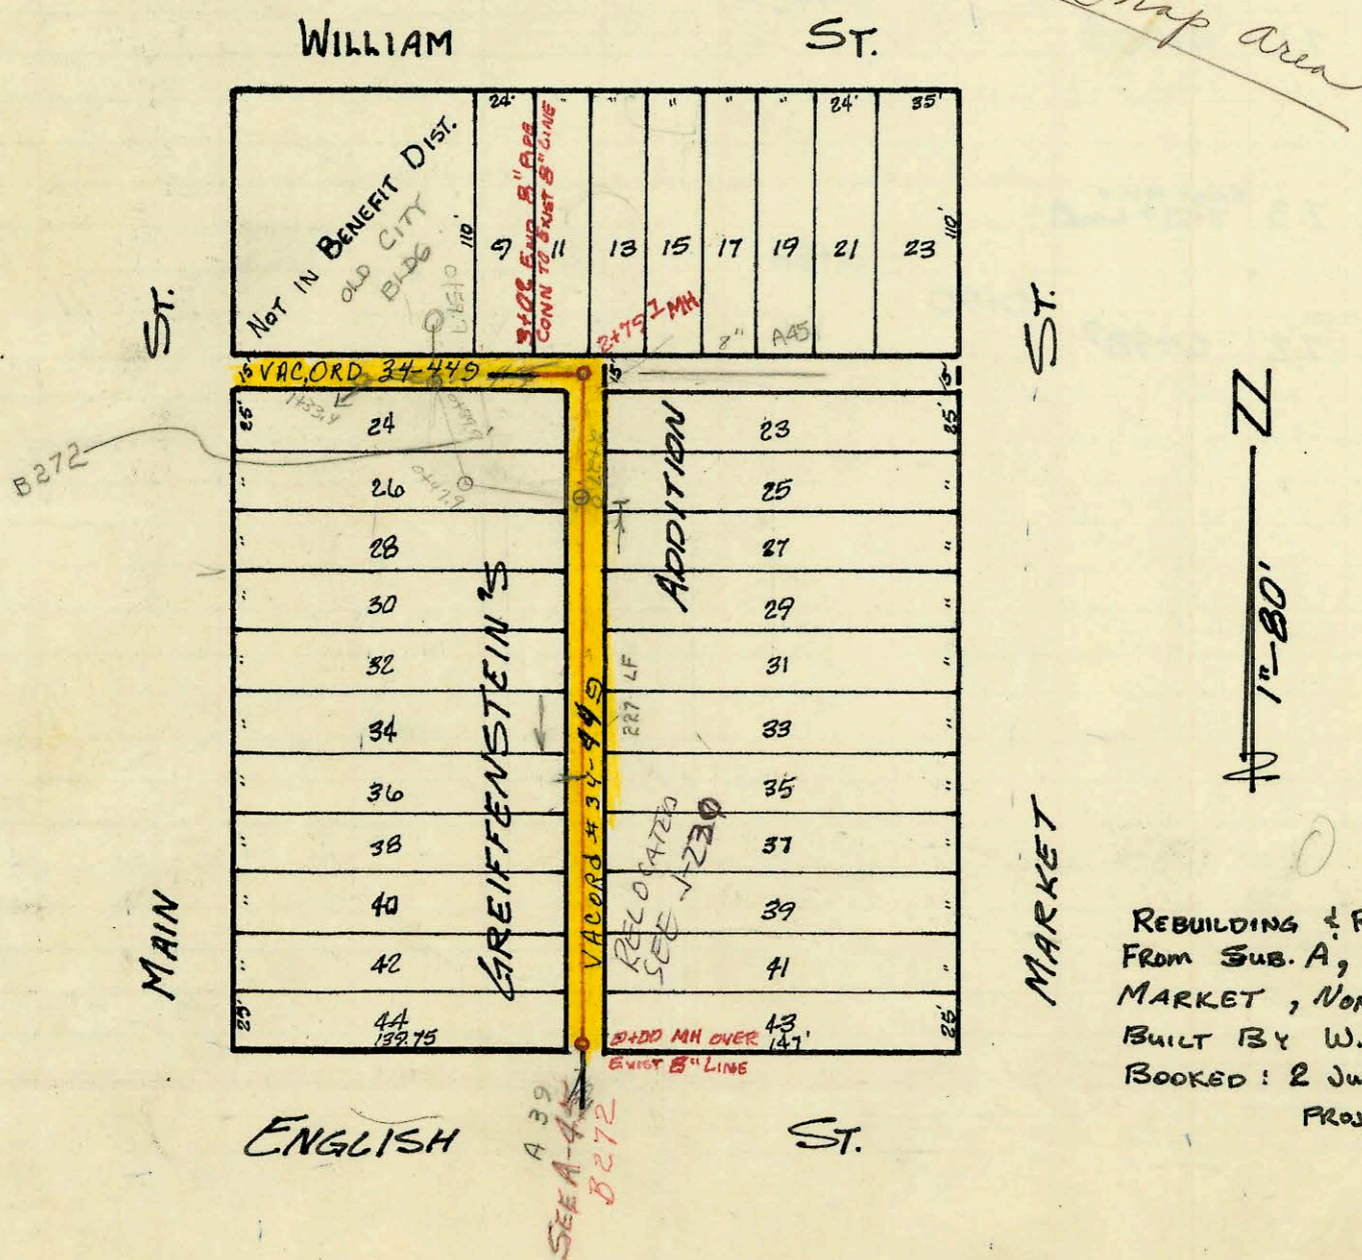

CONSTRUCTION RECORD						SERVICE RECORD						
STATION	ELEVATION		Depth	MANHOLE	4-INCH "Y" BRANCHES		No. of Permit		House Number		DATE OF PERMITS	
	Ground	Grade			North West	South East	North West	South East	North West	South East	North West	South East
Line #1												
0+00	152.4	139.92	12.5	0+00								
1+00	152.9	140.32	12.6									
2+00	152.2	140.72	11.5		1+33 I		C21473		1555 S. Bluffwood		10-23-70	
3+00	151.3	141.12	10.2	3+00	3+18 4" Stub No. 4 So. 3+94		C23962	045231	3980 E Harry	3910 S Harry	7-1-71	6-10-74
4+00	150.3	141.52	8.8		3+69		C25236		3900 E Harry		4-27-71	
5+00	148.5	141.92	6.6		4+76						7-1-71	
	146.9	142.32	4.6	5+99	4+15 5+50 4" Stub S.W.		C25233	C48409	3900 E Harry	3824 E Harry 3818 E Harry 3802 E Harry	7-1-71	2-14-75 12-6-71 8-20-70
Line #2												
0+00	133.8	125.23	8.6	0+00								
1+00	140.3	126.23	14.1									
	144.2	126.33	17.9	1+09 E	8" Stub East							
0+00	110.3	105.32	5.0	0+00	0+78		14767		230 S MAIN		10-1-85	
1+00	111.0	105.52	5.5		0+89		Records		235 S MARKET		7-1-71	
					1+05		Records		231 S MARKET		7-1-71	
					1+54 E		Records	14987	220 S MAIN	229 S MARKET	7-1-71	11-6-85
					1+65 E		Records	14980			7-1-71	Bohau
2+00	111.1	105.72	5.4	2+87 E					211 S MARKET		7-1-71	
	111.5	105.88	5.6	2+79 I			Records				7-1-71	
					2+55							
3+00	111.4	106.00	5.4		2+98 I		Records		155 E WILLIAM		7-1-71	
3+02	END 8" CP.											

1772 15622-229 S. Y. Market 12-13-86 (3724) 2-7-86 James Saltman 400 N

C 25768 - 3832 E Harry - Gene Brodie - 7/21/71 (3499)  
 C 25059 - 3938 E Harry - 7-16-71  
 C 25660 - 3938 E Harry - 7-16-71