



CONSTRUCTION RECORD

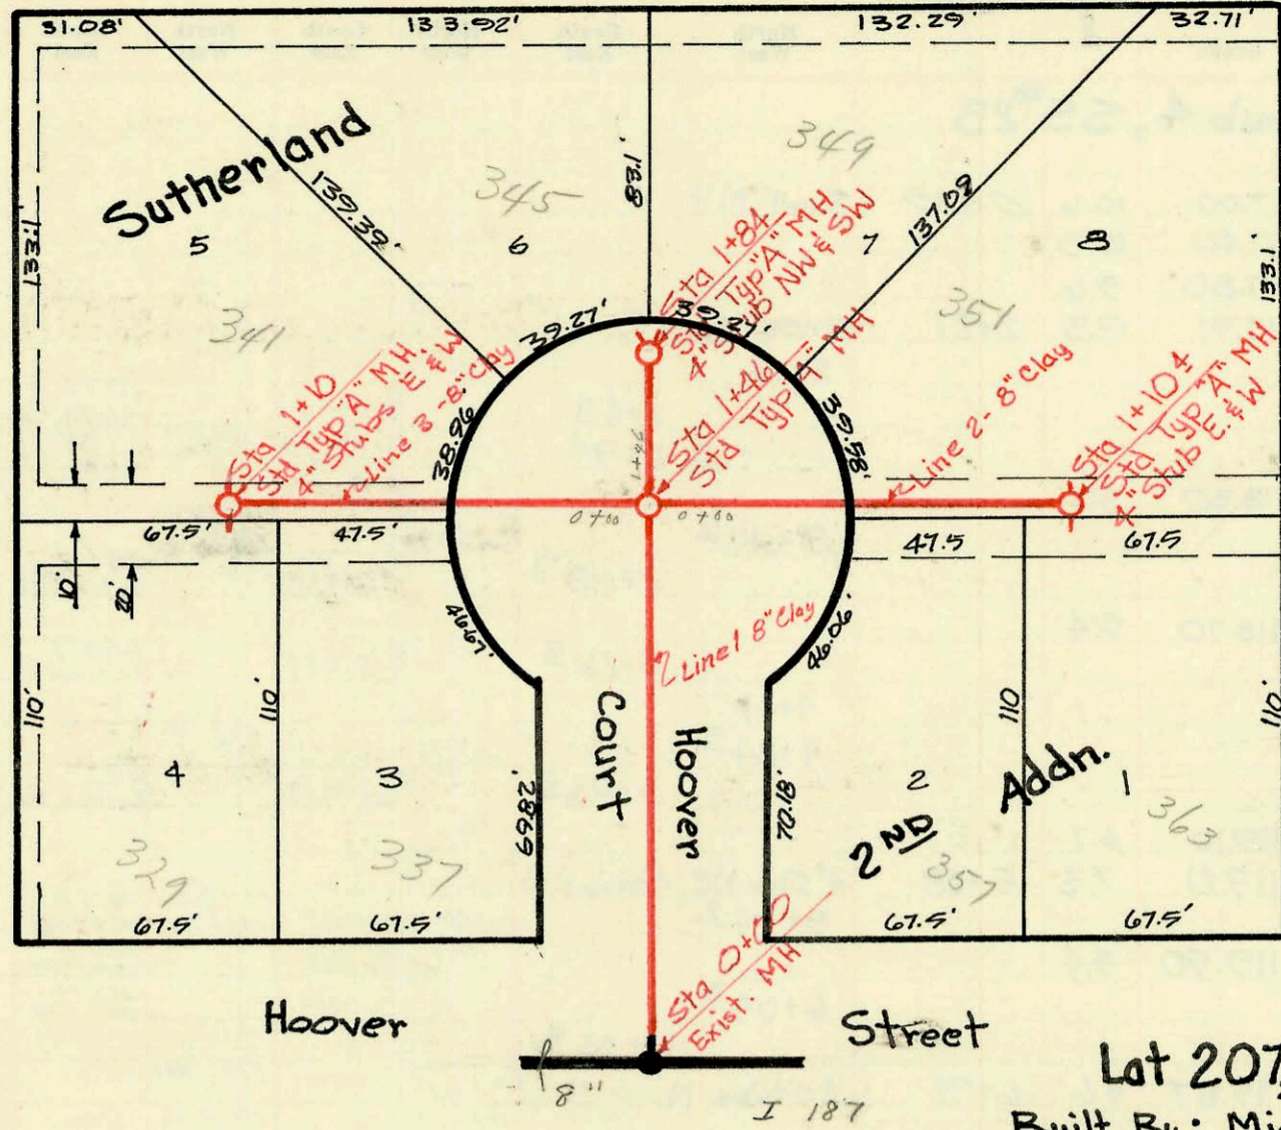

Lot 207, Sub 5, SS#22
 Built By: Mid States Const. Co. Inc.
 Booked: Nov 24, 1970 from K-100
 Proj No C20-53

on map

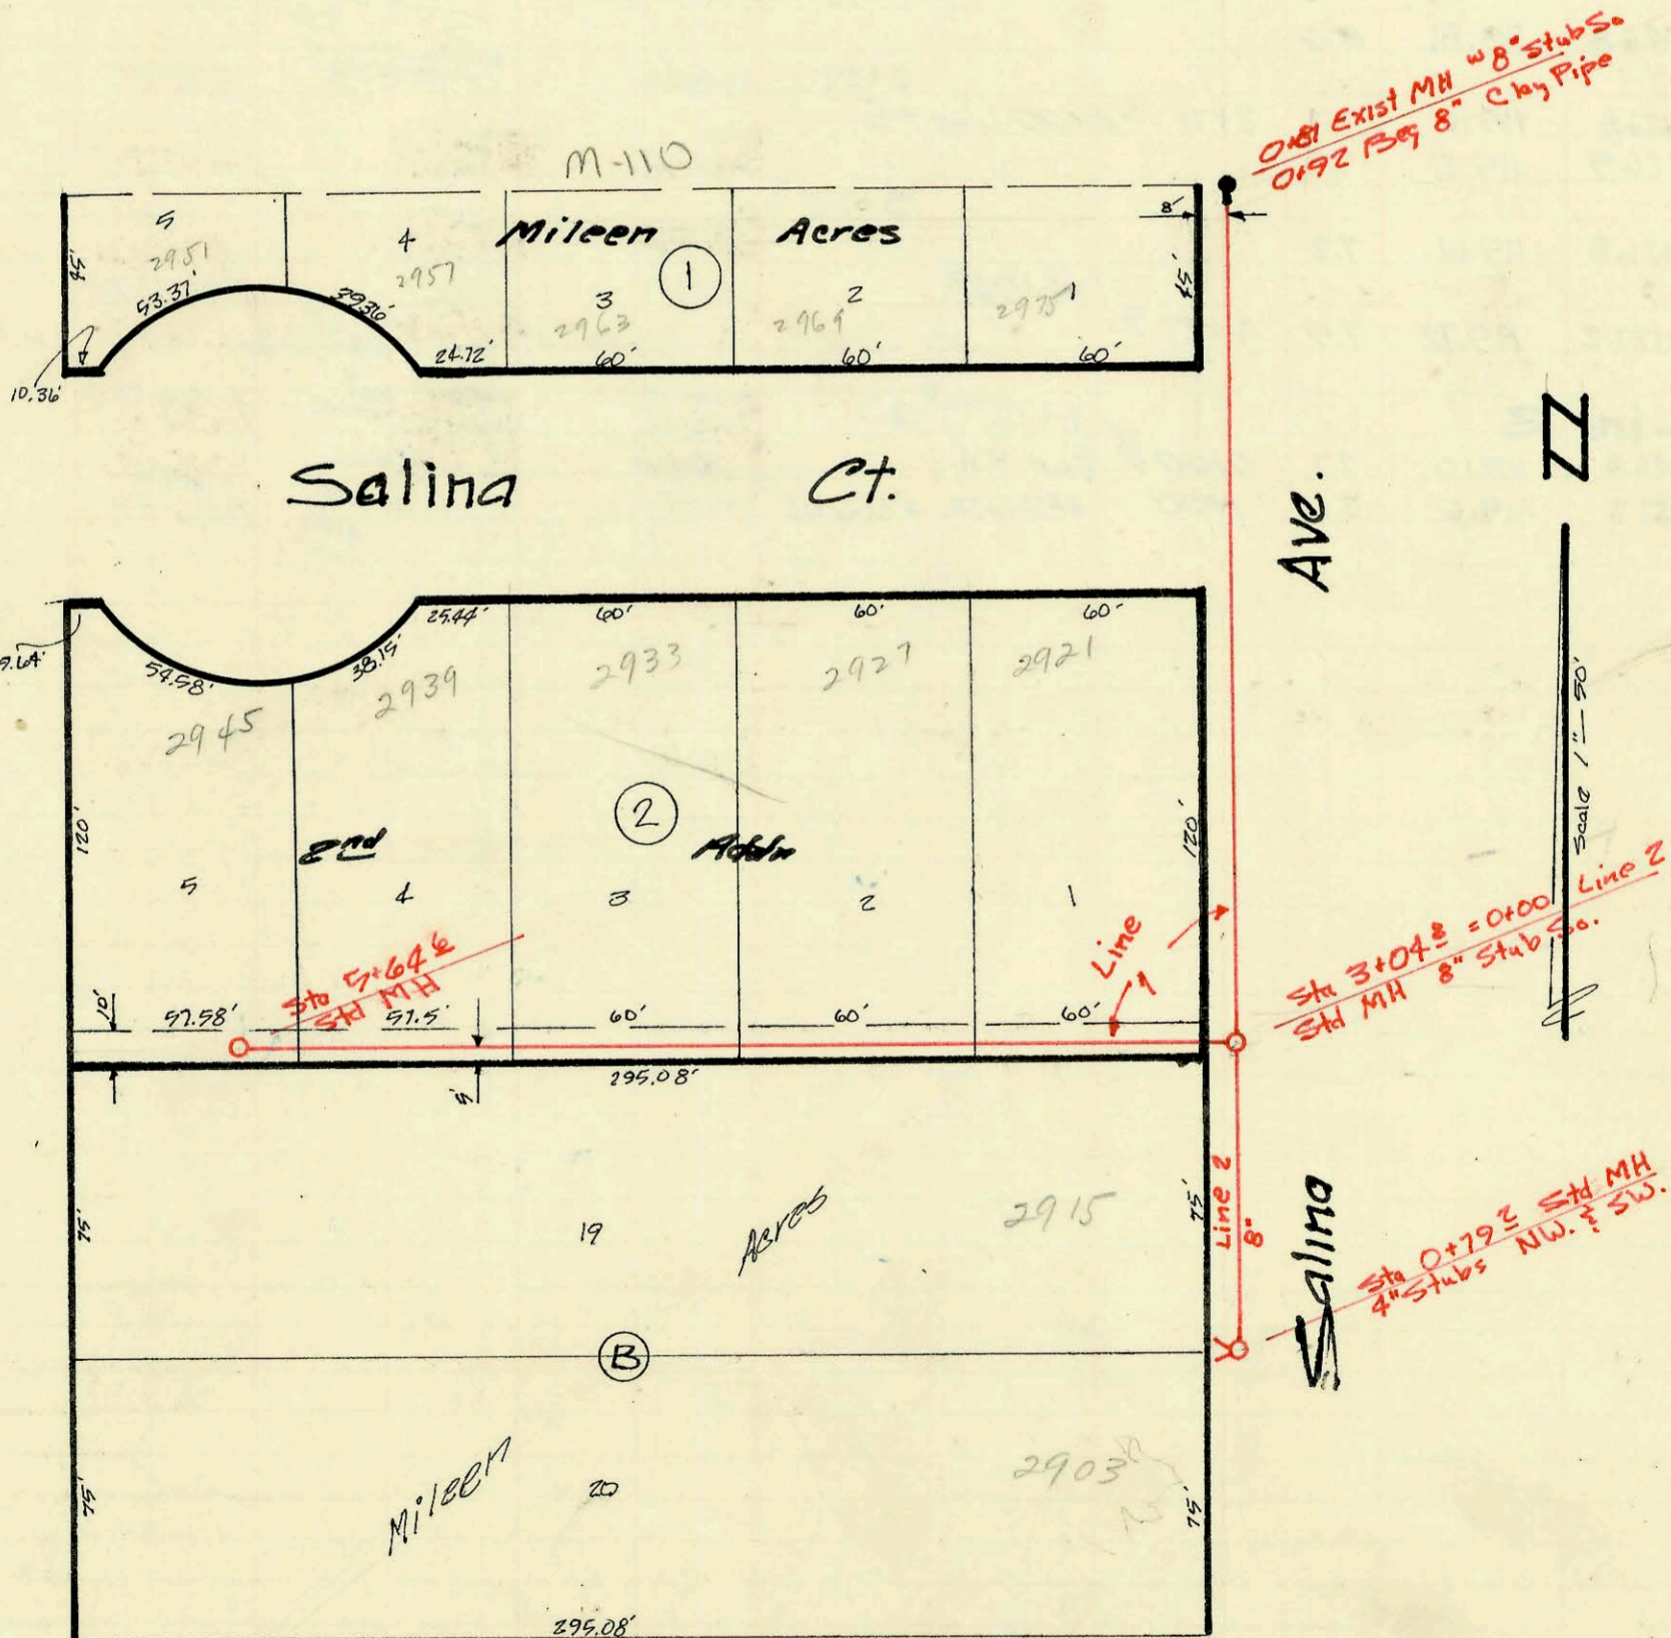

Lot 73, Sub 4, SS#23
 Built By W. B. Carter Const Co. Inc.
 Booked Jan 4, 1971 from SS JK#4
 Proj No C20-94

CONSTRUCTION RECORD

SERVICE RECORD

STATION	ELEVATION		Depth	MANHOLE	4-INCH "Y" BRANCHES		No. of Permit		House Number		DATE OF PERMITS	
	Ground	Grade			North West	South East	North West	South East	North West	South East	North West	South East
Lot 207, Sub 5, SS #22												
Line #1												
0+00	119.3	112.25	7.0	0+00	Exist. MH							
0+12.5					Begin 8" Clay Pipe							
1+00	119.9	112.83	7.1	1+46	= 0+00 Line #2 & #3							
	120.2	112.99	7.2	1+84	4" stub NW 4" stub SW	C21976	C21975	349 N. Hoover Ct.	345 N. Hoover Ct.	12-1-70	12-1-70	
Line #2												
0+00	119.9	112.83	7.1	0+00	Exist. MH							
1+00	119.7	113.35	6.4	1+10	4" stub W 4" stub E	C21977	C21978	351 N. Hoover Ct.	357 N. Hoover Ct.	12-1-70	12-1-70	
					TAP 0+68.4							
					0+78							
					0+68							
					0+78							
					0+68							
					0+78							