


Lat 14, Sub 1, S.W. Interceptor
 Built By: Mid States Const Co. Inc.
 Booked: Dec 10, 1970 from 264-Y
 Proj. No. C20-32

on map

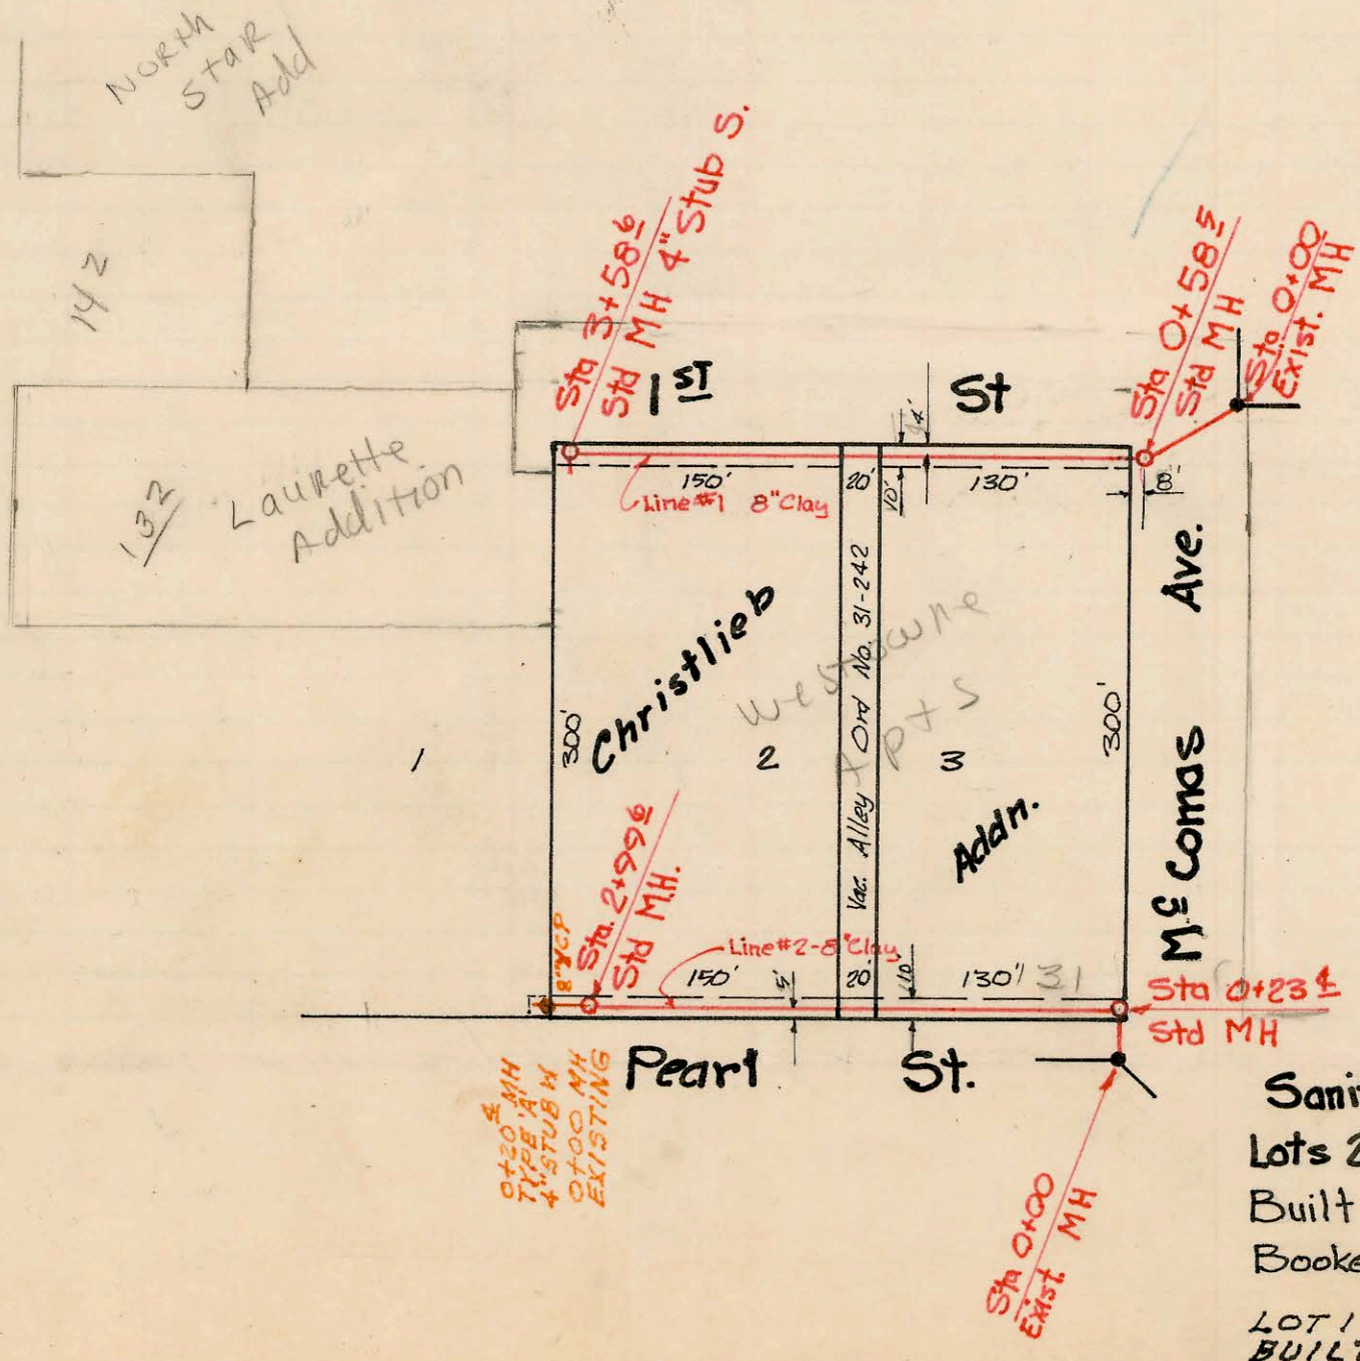

Private
 Sanitary Sewer Extension
 Lots 2 & 3 Christlieb Addn.
 Built By: Allied Utility Inc.
 Booked: Dec. 10, 1970 from S.S. JK#4
 Private Project
 LOT 1 S.S. EXT
 BUILT BY: UTILITY CONT. INC
 PROJ N# DBKN 706060
 BOOKED 11-4-77 FROM G2

on map

