



SERVICE RECORD CONSTRUCTION RECORD

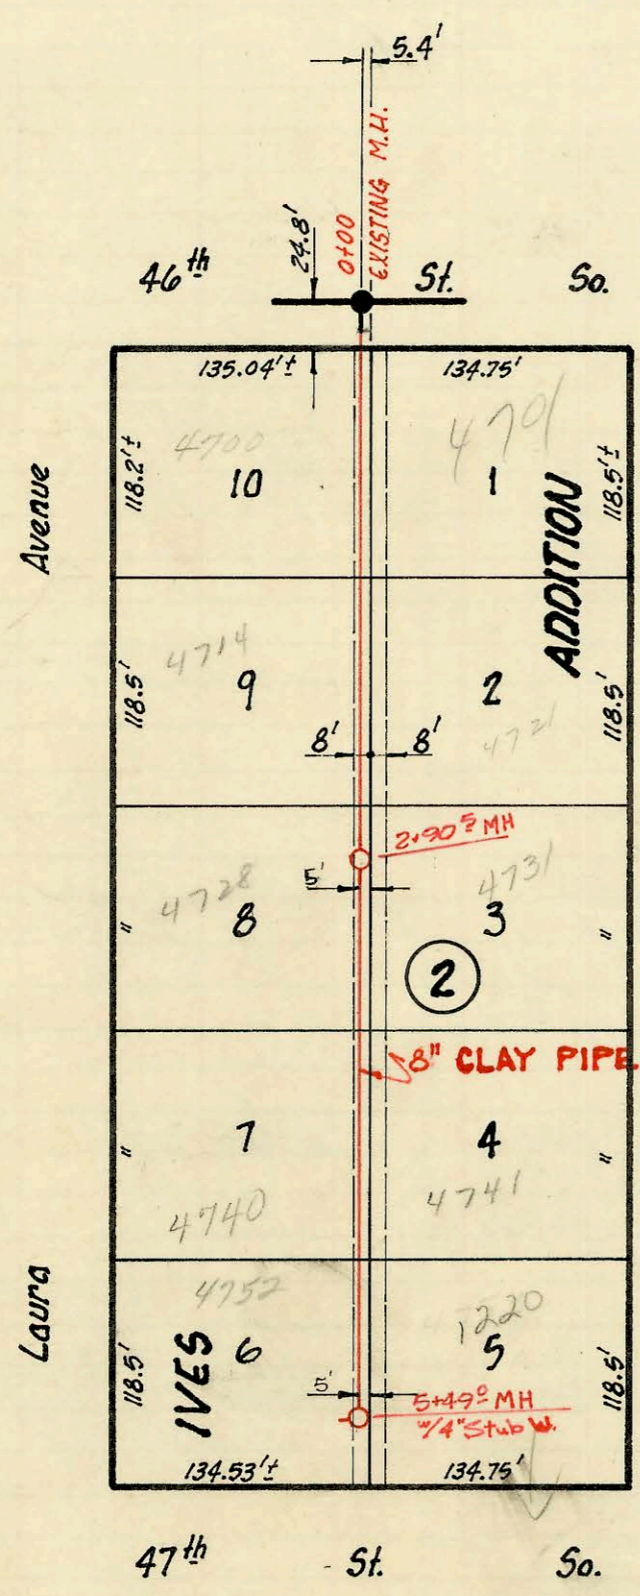

Lat. 15, Sub. 1, S.W. 1.
 MID-STATES CONSTRUCTION CO., INC.
 BOOKED March 2, 1971 from K-87
 PROJECT NO. C20-33

SCALE: 1" = 100'

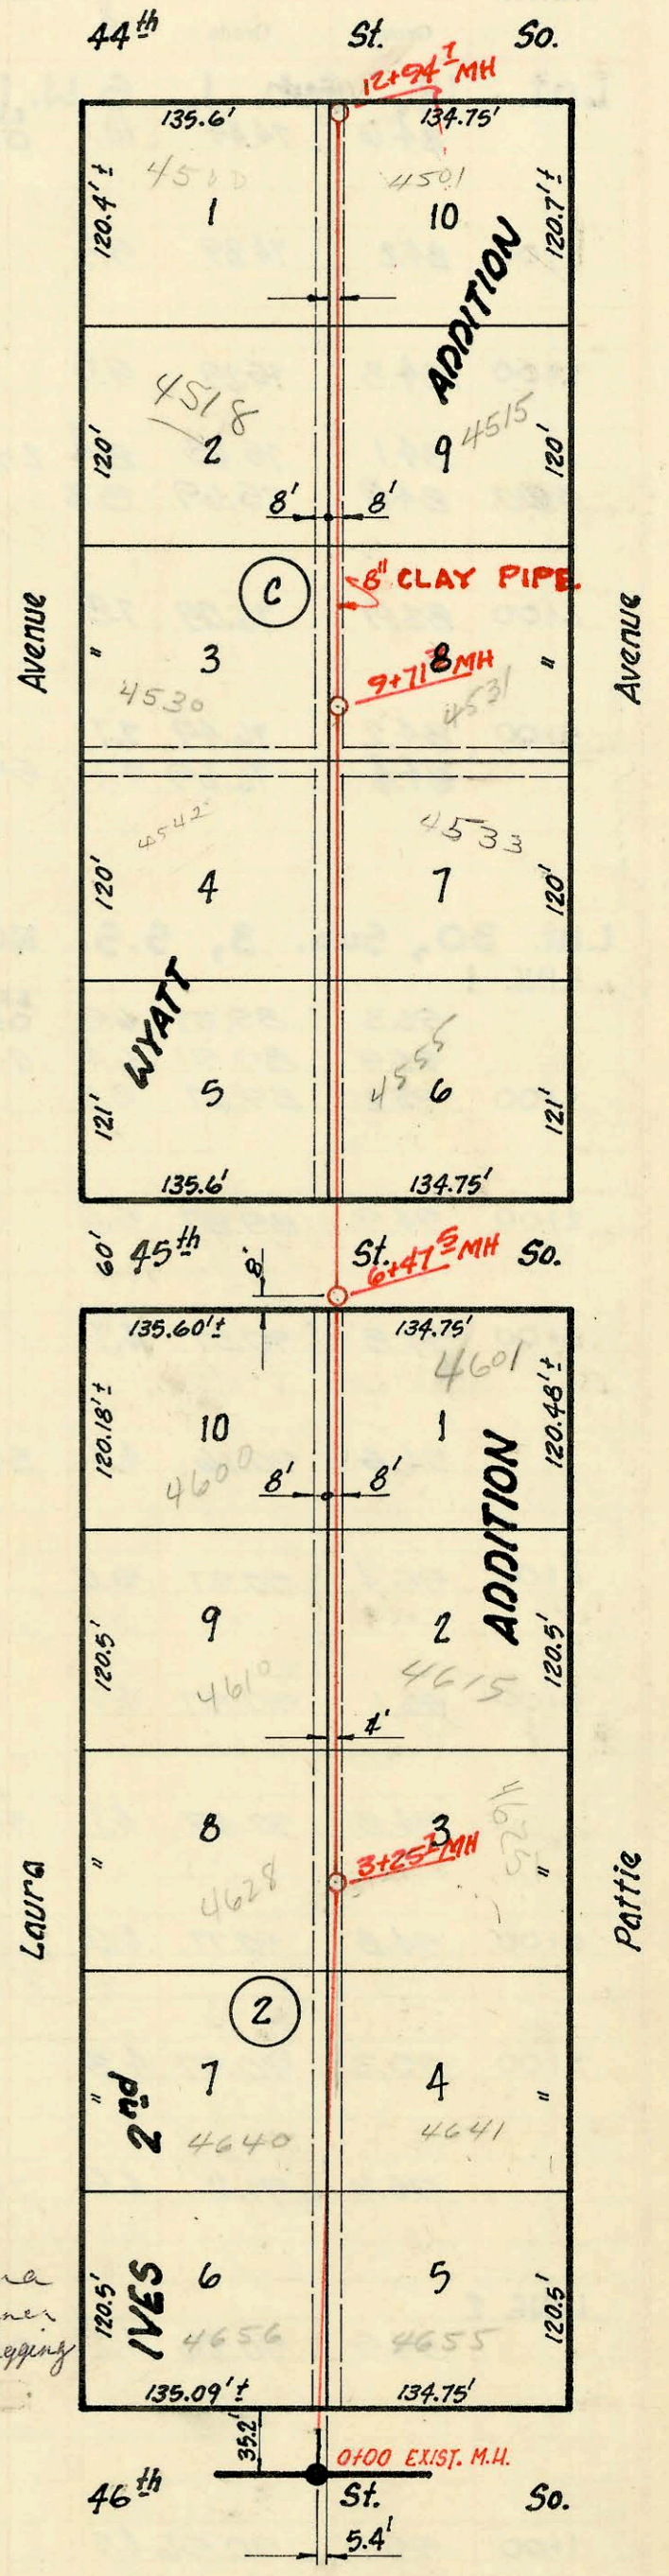

Lat. 20, Sub. 1, S.W. 1.
 MID-STATES CONSTRUCTION CO., INC.
 BOOKED APRIL 6, 1971 FROM K107
 PROJECT NO. C20-45

4656 Laura
 Contact pinner
 before digging

