
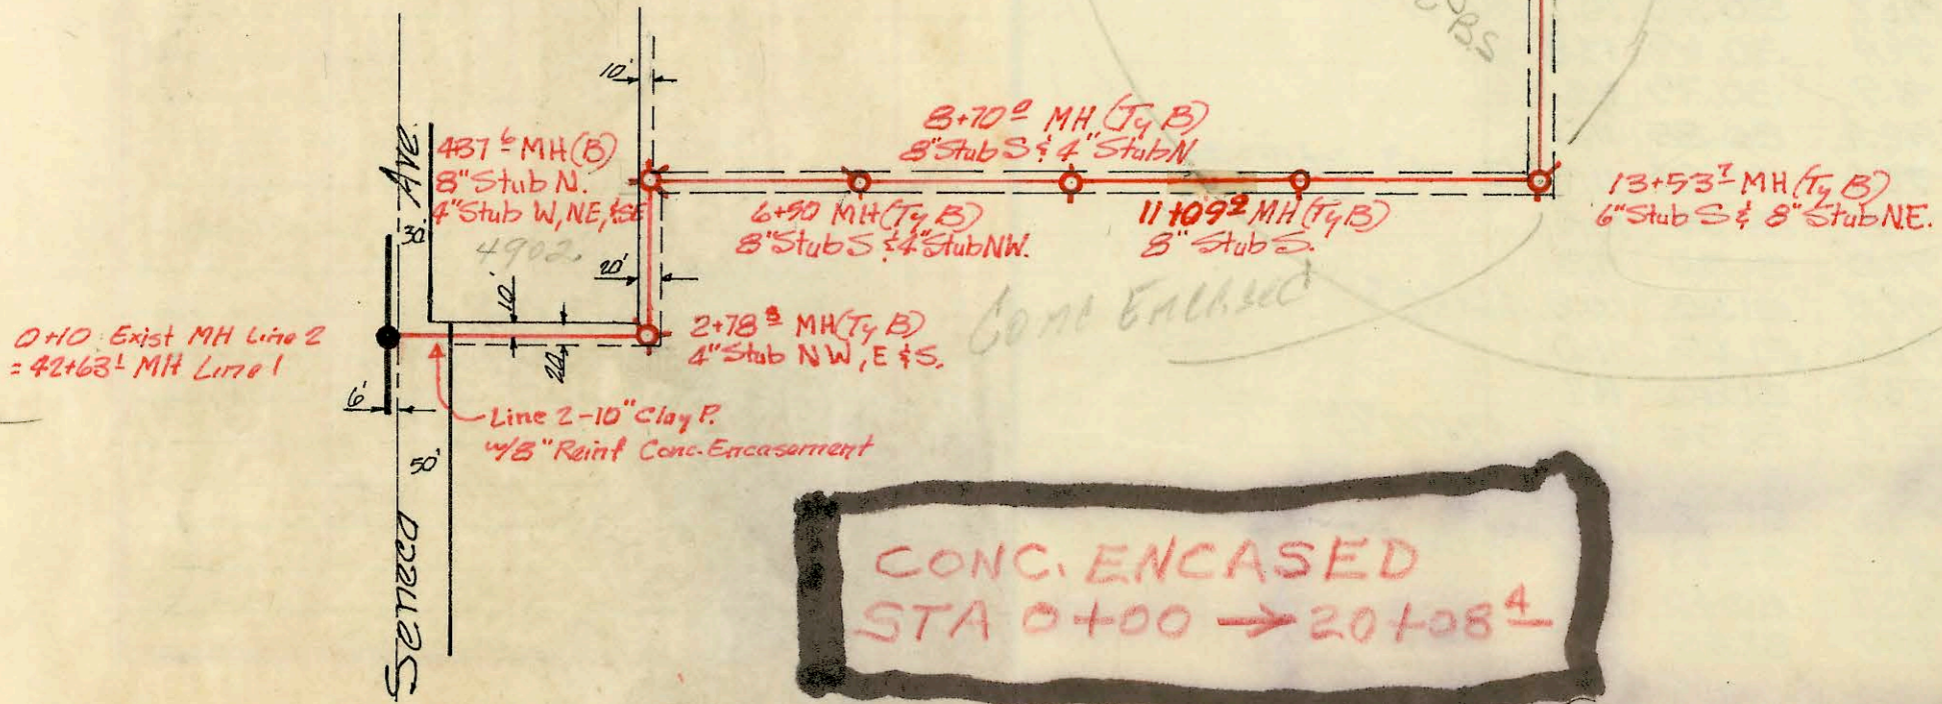
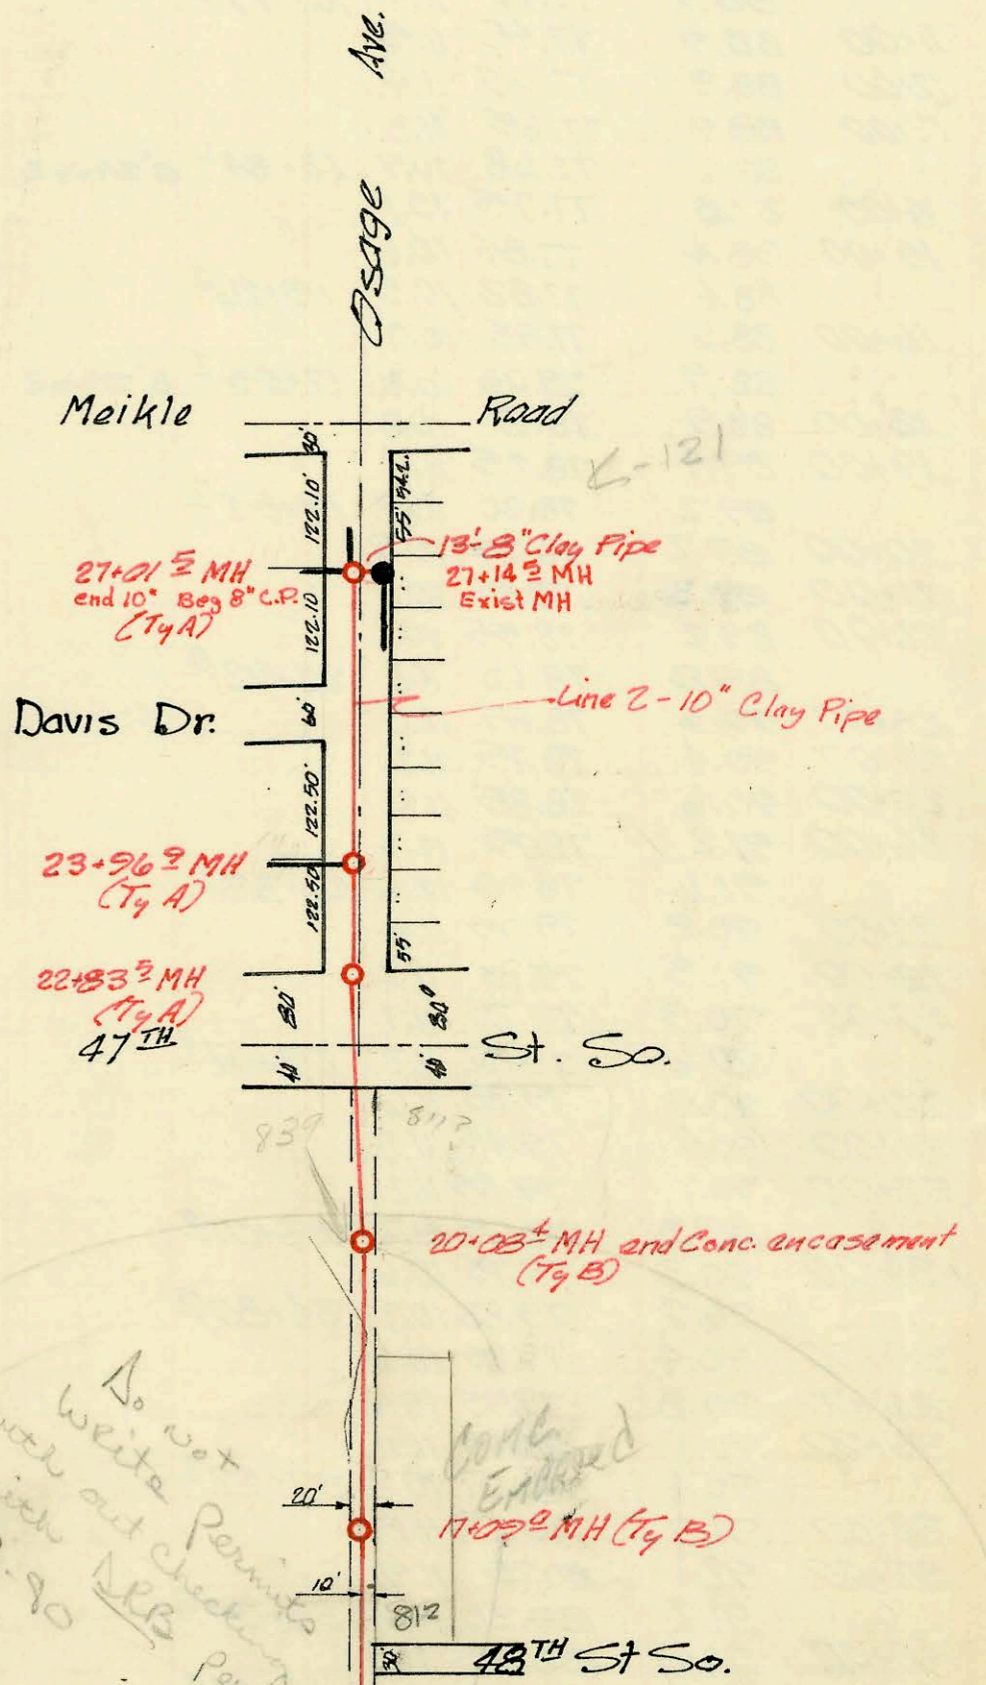


CONSTRUCTION RECORD

CONSTRUCTION RECORD

DATE OF RECORD: PROJECT NO.: SHEET NO. OF: SHEET TOTAL: DRAWN BY: CHECKED BY: APPROVED BY:

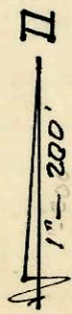

**CONC. ENCASED  
STA 0+00 → 20+08.4**

13+53  
1296  
4161  
2785  
11749  
6  
11889

CONSTRUCTION RECORD						SERVICE RECORD						
STATION	ELEVATION		Depth	MANHOLE	4-INCH "Y" BRANCHES		No. of Permit		House Number		DATE OF PERMITS	
	Ground	Grade			North West	South East	North West	South East	North West	South East	North West	South East
<b>Line #2</b>						<b>NOTE: All Y's HAVE 4" PIPE FOR RISERS, Y's &amp; RISERS ARE ENCASED 1/6" CONC.</b>						
	85.3	73.61	11.7	0+10	Line 2 = 42+63	Line 1						
1+00	84.4	73.84	10.6			0+98		C22995	Lot 1			2-18-71
2+00	84.4	74.09	10.3			1+50		C22996	Lot 2			2-18-71
3+00	84.4	74.29	10.1	2+78	4" stub NW, E & S	2+18		C22997	Lot 3			2-18-71
	84.4	74.42	10.0			2+61	C22998 C22999 C23000	Lot 4 Lot 5 Lot 20				
4+00	84.4	74.60	9.8	4+37	4" stub NW 8" stub N 4" stub W 4" stub SE 4+77	3+29		C23001	Lot 21			2-18-71
	84.5	74.66	9.8			3+77	C23002	Lot 22				
5+00	84.6	74.87	9.7					C23003	Lot 23			2-18-71
6+00	85.1	75.04	10.1					C23004 C23005	Lot 24 Lot 25			2-18-71
7+00	85.6	75.22	10.4	6+50	4" stub NW 8" stub S	6+27		C23006	Lot 26			2-18-71
						6+29		C23008	Lot 28			2-18-71
						6+72		C23007	Lot 27			2-18-71
						6+80		C23009	Lot 41			2-18-71
						6+87		C23010	Lot 42			2-18-71
8+00	85.6	75.39	10.2				C23011	Lot 43			2-18-71	
9+00	85.7	75.52	10.2	8+70	4" stub N 8" stub S	8+40		C23012	Lot 44			2-18-71
						8+94		C23013	Lot 45			2-18-71
								C23014	Lot 58			2-18-71
10+00	85.6	75.74	9.9			9+17		C23015	Lot 59			2-18-71
						9+19		C23016	Lot 60			2-18-71
11+00	85.6	75.91	9.7	11+09	8" stubs	10+82		C23017	Lot 61			2-18-71
	85.5	75.93	9.6			11+00	C23018	Lot 62			2-18-71	
12+00	85.8	76.09	9.7			11+35						
13+00	85.9	76.26	9.6			11+54						
14+00	86.0	76.36	9.6	13+53	6" stub S 8" stub NE	14+32						
	86.2	76.54	9.7			14+34						
15+00	86.7	76.71	10.0			14+96						
						14+94						
						15+14						
16+00	87.2	76.88	10.3			15+16						
17+00	88.4	77.06	11.3					C23019	Lot 16+70			1-4-80
18+00	88.5	77.08	11.4	17+09								
19+00	88.4	77.23	11.2									
20+00	87.8	77.41	10.4									
21+00	87.5	77.58	9.9	20+08	END ENCASEMENT			11019	839 W. 47th St			5-25-84
	87.5	77.60	9.9									
22+00	88.4	77.75	10.7									
23+00	88.5	77.93	10.6	22+83								
	87.3	78.06	9.2									
24+00	87.4	78.10	9.3	23+96								
	87.5	78.26	9.2									
25+00	87.5	78.28	9.2									
26+00	87.6	78.45	9.2									
27+00	87.8	78.62	9.2									
28+00	88.0	78.79	9.2	27+01	End 10" Beg 8"							
	88.4	79.00	9.4			27+14	Exist M.N End 8"					

(Letter on file in  
utility office granting  
encasement)