


Note - There is a underground Water Problem, 8" sewer at M.H. Sta - 4+49.5 is about 3' under Water. J.L.P. 8-18-72



No FREE TAPS AS PER UNION - 5/31/74

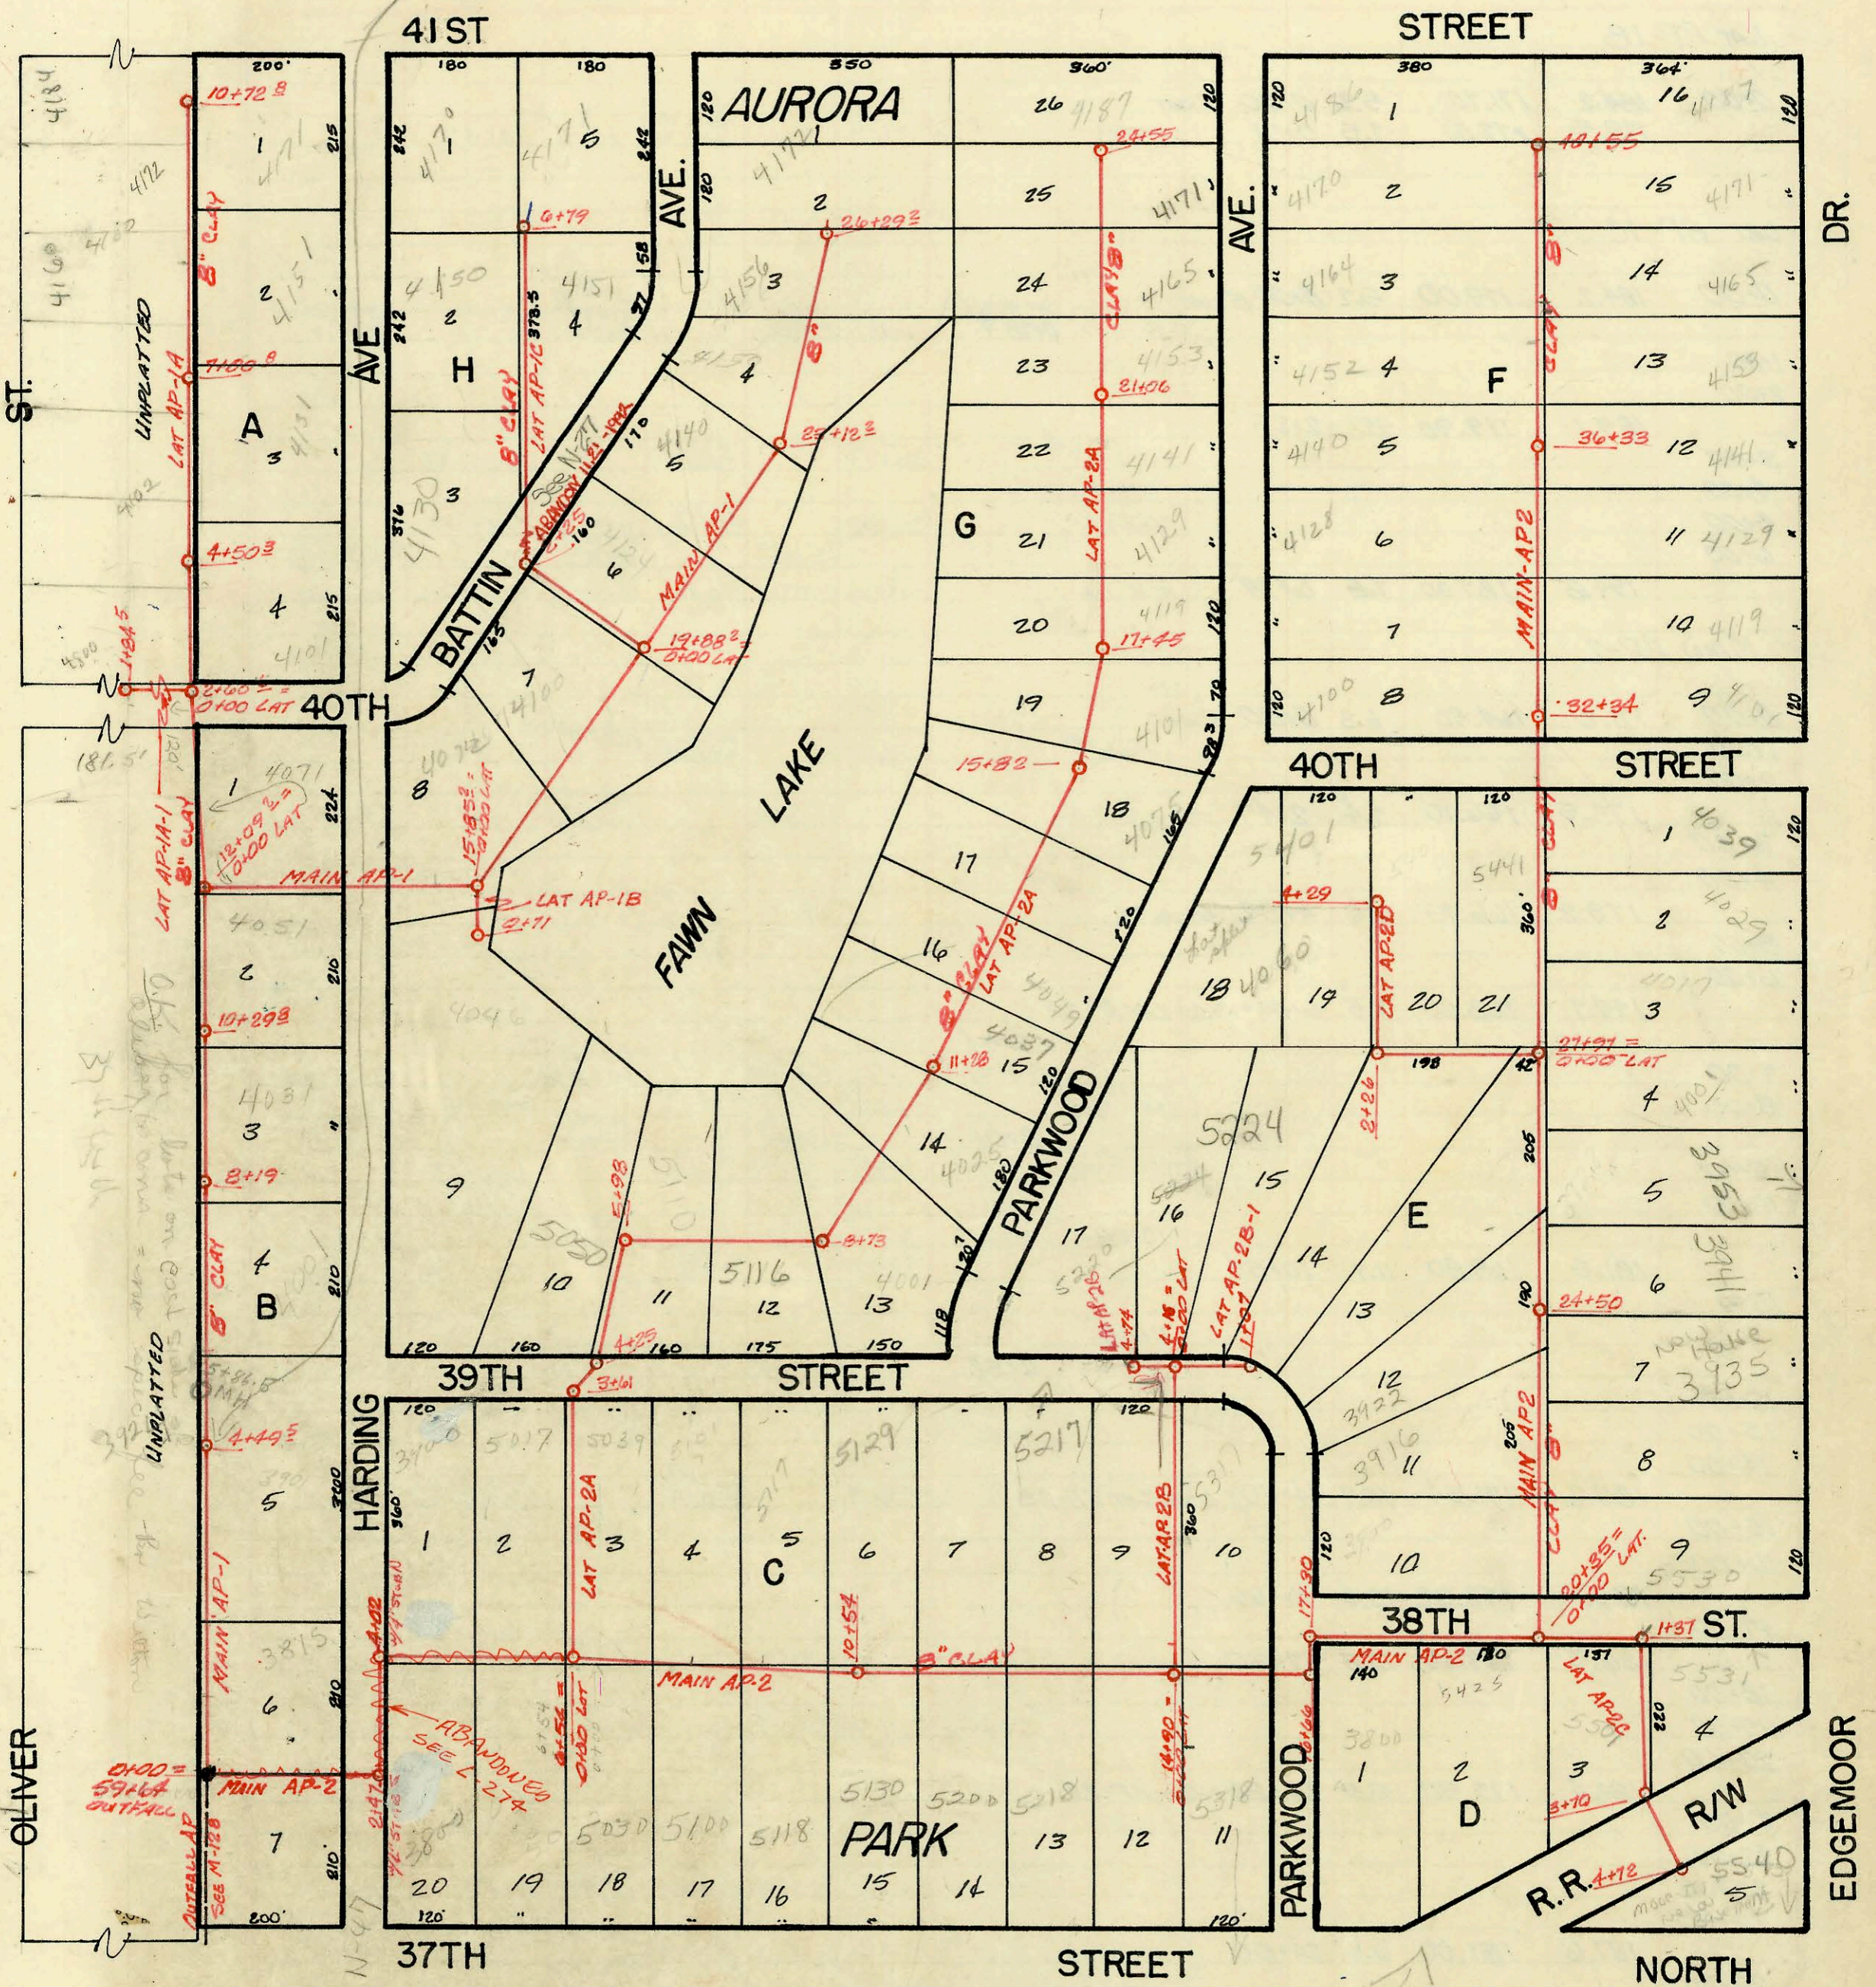

1" = 200'

map # 124

PRIVATE SEWER FOR
AURORA PARK ADDITION
 BUILT BY: W. B. CARTER CONST. CO.
 BOOKED: MAY 14, 1971 FROM AS BUILT PLANS
 PROJECT NO. PRIVATE

SERVICE RECORD

CONSTRUCTION RECORD

SEE—M-129