


245 = 42M  
Note TH = PROP 6"  
LINE FOR HOME  
TO DEPT FOR MUST 90  
Refer to case notes  
on Bldg permit  
1-22-07  
BR

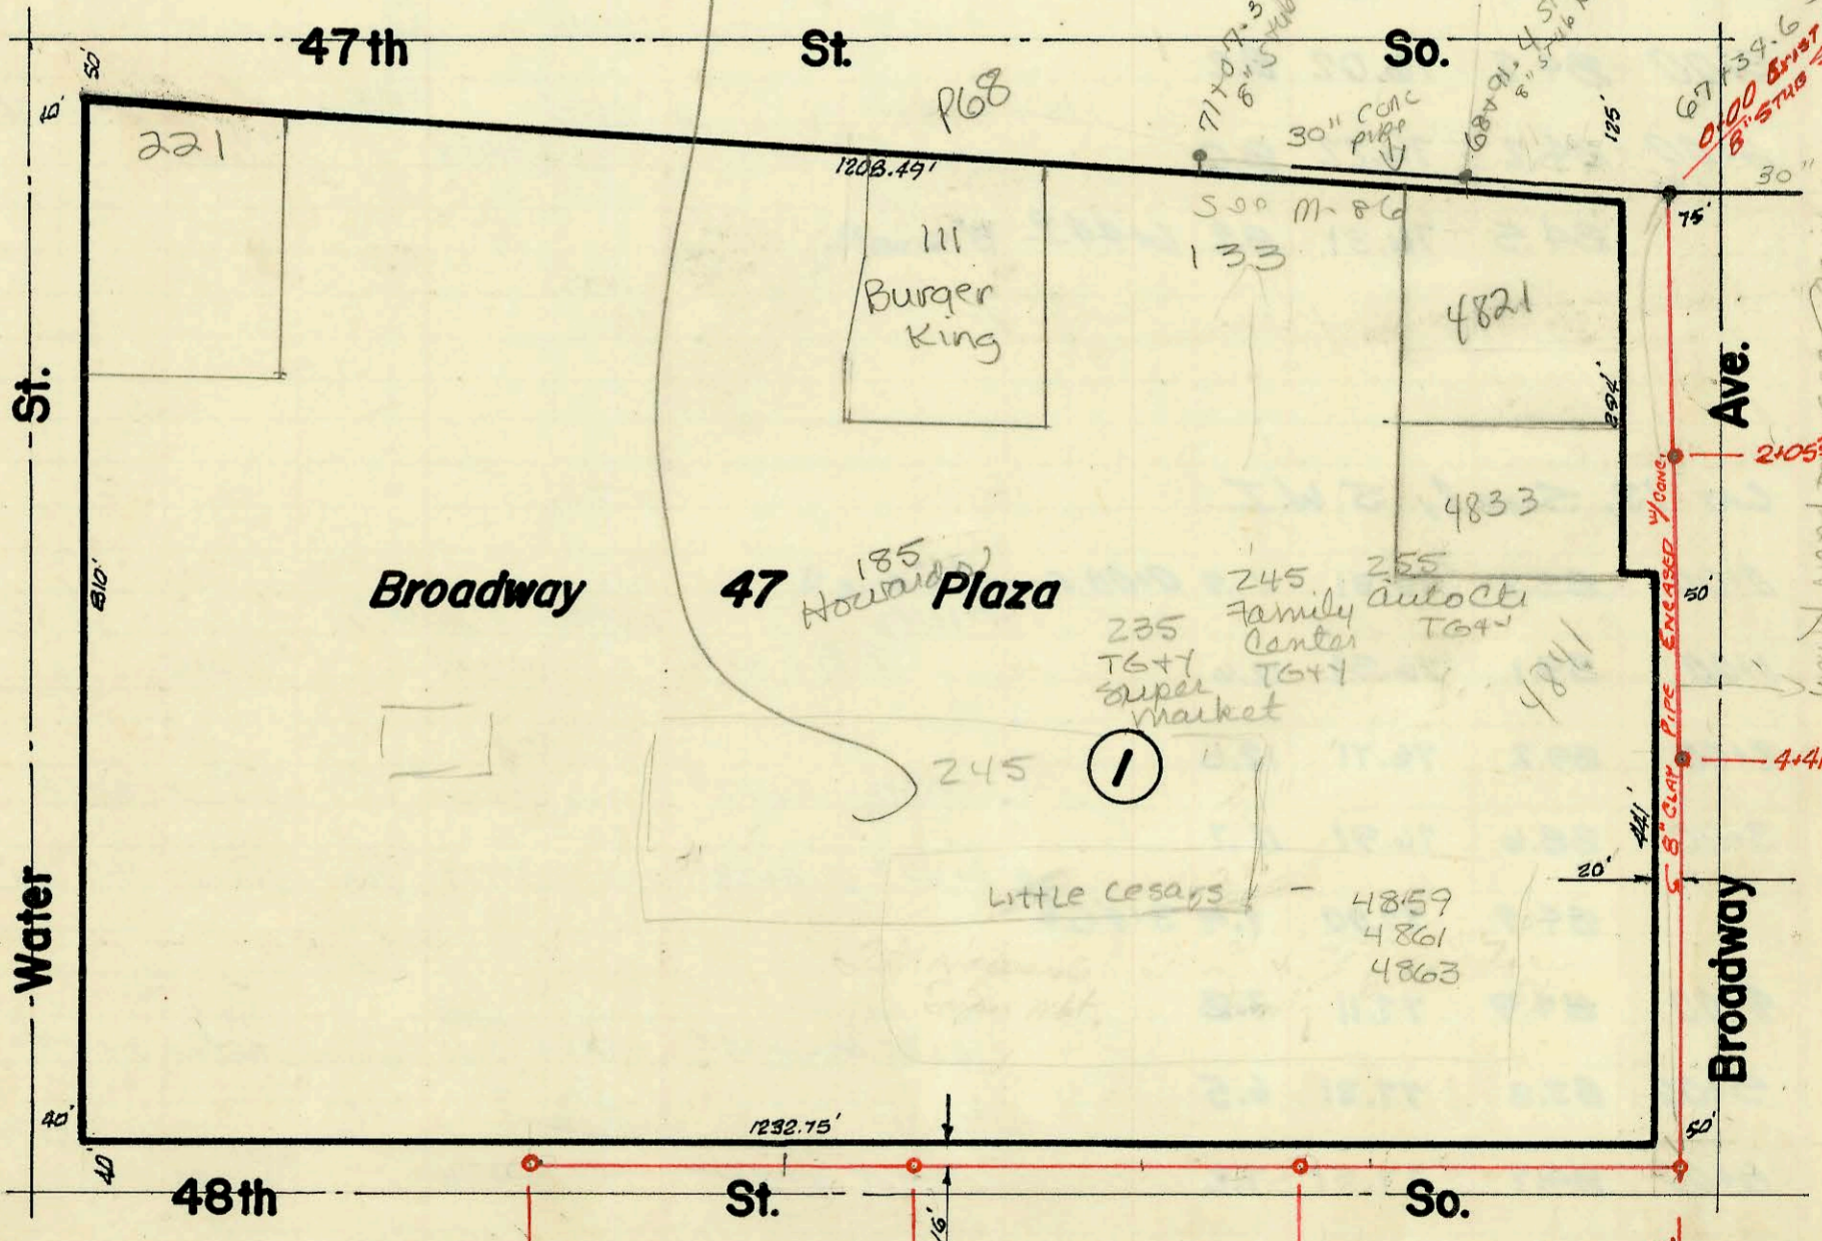

No TAPS TO eny Main  
concrete eny  
sewer main set saddle  
plus O.C.I. INS  
would need to core drill  
then concrete have  
sewer main set saddle  
no prior approval from  
senior maint. div

**Lot 1, Sub 2, S.W.I.**

BUILT BY: MID STATES CONST. CO. INC.  
BOOKED: 11 JUN 71 FROM SS #12 J.K.  
PROJ. NO. DBKLS68092

C68523  
C68524  
100 W 48th St  
9/25/76

CONSTRUCTION RECORD						SERVICE RECORD						
STATION	ELEVATION		Depth	MANHOLE	4-INCH "Y" BRANCHES		No. of Permit		House Number		DATE OF PERMITS	
	Ground	Grade			North West	South East	North West	South East	North West	South East	North West	South East
LAT 4, SUB 3, S.W.I.												
0+00	83.5	75.65	7.9	0+00 EXIST.	1/25' stub W							
1+00	84.2	75.80	8.4		4" SDR 35 2+16.0 top	1+20.5	21749	11463	5159 S. Seneca	5201 S. Seneca	10-24-86	7-13-84
2+00	83.9	75.95	8.0									
	84.0	76.17	7.8	2+82	1/8" stub N & W		64123	242038	118 W 51st St 730 W 1st St So.		11-21-77	11-2-73
LAT 1, SUB 2, S.W.I.												
0+00	86.6	73.75	12.9	0+00 EXIST	1/8" stub S.							
1+00	85.8	73.95	11.8									
2+00	85.8	74.15	11.7									
3+00	86.9	74.35	12.6		2+05 2" B"		22319		4833 S. Broadway		12-30-88	
4+00	86.5	74.55	12.0				9516357		4841 Broadway		10-16-95	
	86.7	74.63	12.4		4+41 1/2" B"							
5+00	86.9	74.75	12.2									
6+00	86.3	74.95	11.4									
7+00	86.3	75.15	11.2									
	85.4	75.27	10.1		7+59 2" B 8" stubs.							
					7+59 2" END ENCASEMENT							
8+00	84.6	78.85	5.8									
9+00	84.0	79.05	5.0									
10+00	84.7	79.25	5.5				21355					
	84.7	79.37	5.3	10+58 ±					245 47th St	add 1 conn for Remodeled stage 11-8-57	8-24-88	
11+00	84.6	79.45	5.2									
12+00	84.6	79.65	5.0									
13+00	84.9	79.85	5.0									
	85.0	79.97	5.0	13+59 2"								
14+00	85.0	80.05	5.0				29722		335 47th St		12-28-71	
15+00	86.5	80.25	6.2									
16+00	87.5	80.45	7.0									
	87.4	80.57	6.8	16+57 ±			29723		185 47th St		11-5-57	12-28-71

10+00.4 TP  
11+81 2  
THIS MANHOLE  
EXISTS BUT  
TV LIST  
11/15/87  
C. FULL

NO checkers  
stop for Remodeled  
stage  
8-24-88

185  
47th St

107-30  
1-22-0