


29<sup>TH</sup> St. No.

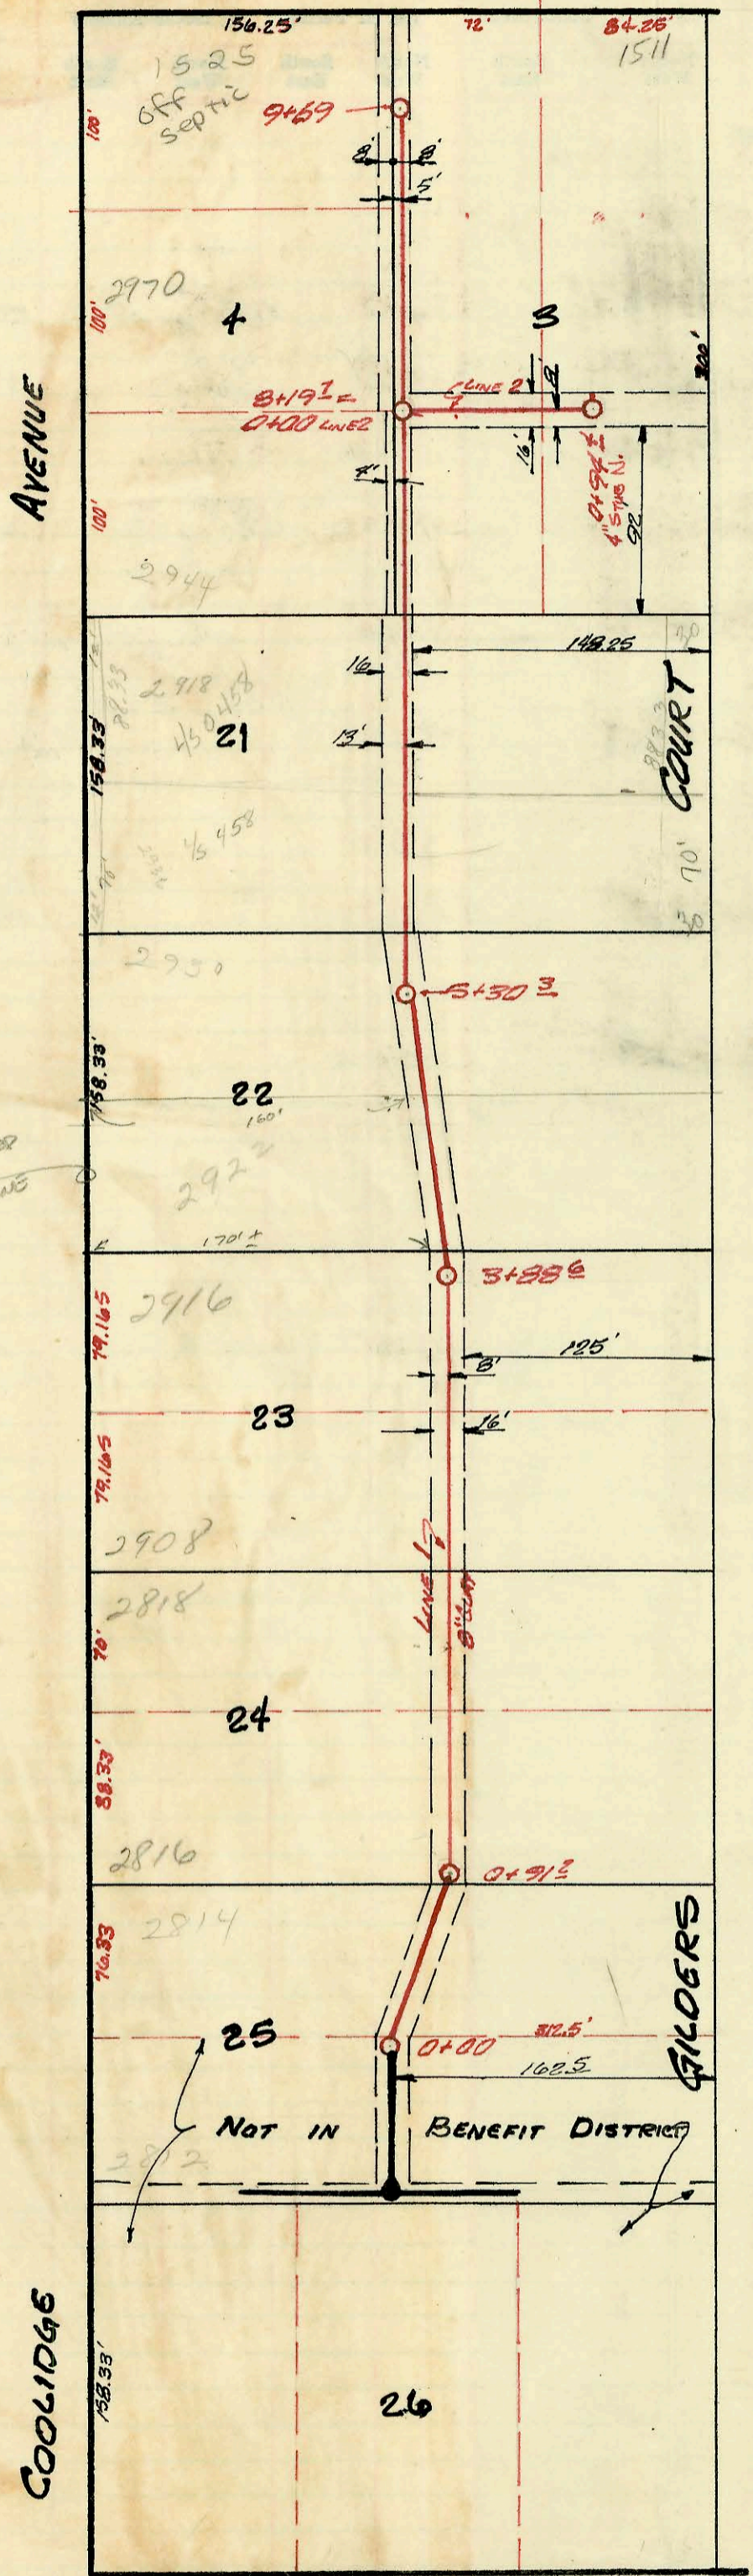

LAT 50, SUB 17, SS # 22  
 BUILT BY: MID STATES CONST. CO.  
 BOOKED 1 July 71 from K-106  
 PROJ. NO. DBKLE561064

*21 map*

27<sup>TH</sup> St. No.

CONSTRUCTION RECORD						SERVICE RECORD						
STATION	ELEVATION		Depth	MANHOLE	4-INCH "Y" BRANCHES		No. of Permit		House Number		DATE OF PERMITS	
	Ground	Grade			North West	South East	North West	South East	North West	South East	North West	South East
LAT 50, SUB 17, SS# 22												
	126.6	117.48	9.1	0+00	NEW MH BUILT OVER EXIST 8" CLAY PIPE							
1+00	126.6	117.84	8.8	0+91 <sup>2</sup>	1+21 <sup>2</sup> top 2+00.8		C3538		2816 Coolidge			7-7-71
2+00	126.6	118.38	8.2		top 2+79 <sup>6</sup>		C36099		2818 Coolidge			11-27-72
3+00	126.4	118.78	7.6		top 3+65 <sup>6</sup>		C29075		2908 Coolidge			11-18-71
	126.6	119.14	7.5	3+89 <sup>6</sup>	top 4+08 <sup>3</sup> 4+50.35 4+20.3 top		C32472		2916 Coolidge			5-25-72
4+00	126.6	119.18	7.4		top 4+20.3 top		C49452		2918 Coolidge			5-12-75
5+00	126.6	119.58	7.0		top 5+12.47		14459		2920 Coolidge			9-15-85
	126.5	119.71	6.8	5+30 <sup>3</sup>	top 5+77.28		C75273		2930 Coolidge			11-7-79
6+00	126.7	119.98	7.6				5761		2936 Coolidge			4-29-82
7+00	127.0	120.38	6.6									
8+00	126.9	120.78	6.1		top 7+69 <sup>3</sup>		C65735		2944 Coolidge			6-15-76
	127.3	120.86	6.4	8+19 <sup>1</sup>	= 0+00 LINE 2							
9+00	127.4	121.18	6.2		top 8+88 <sup>2</sup>		C49648		2970 Coolidge			5-27-75
	127.6	121.46	6.1	9+69	top 9+41.77 4+50.35		200702446 2003 62947 17802		1525 1525 1525 Coolidge			11-13-83 11-13-83 2-25-87
LINE 2												
	127.3	121.02	6.3	0+00	EXIST MH							
	127.0	121.91	5.1	0+94 <sup>4</sup>	4" STUB No.		98-208917 125399		1511 W SID Coolidge			12-12-95 7-7-71