

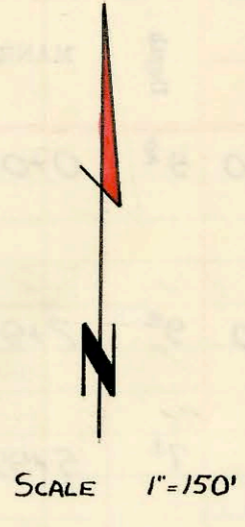


SERVICE RECORD CONSTRUCTION RECORD

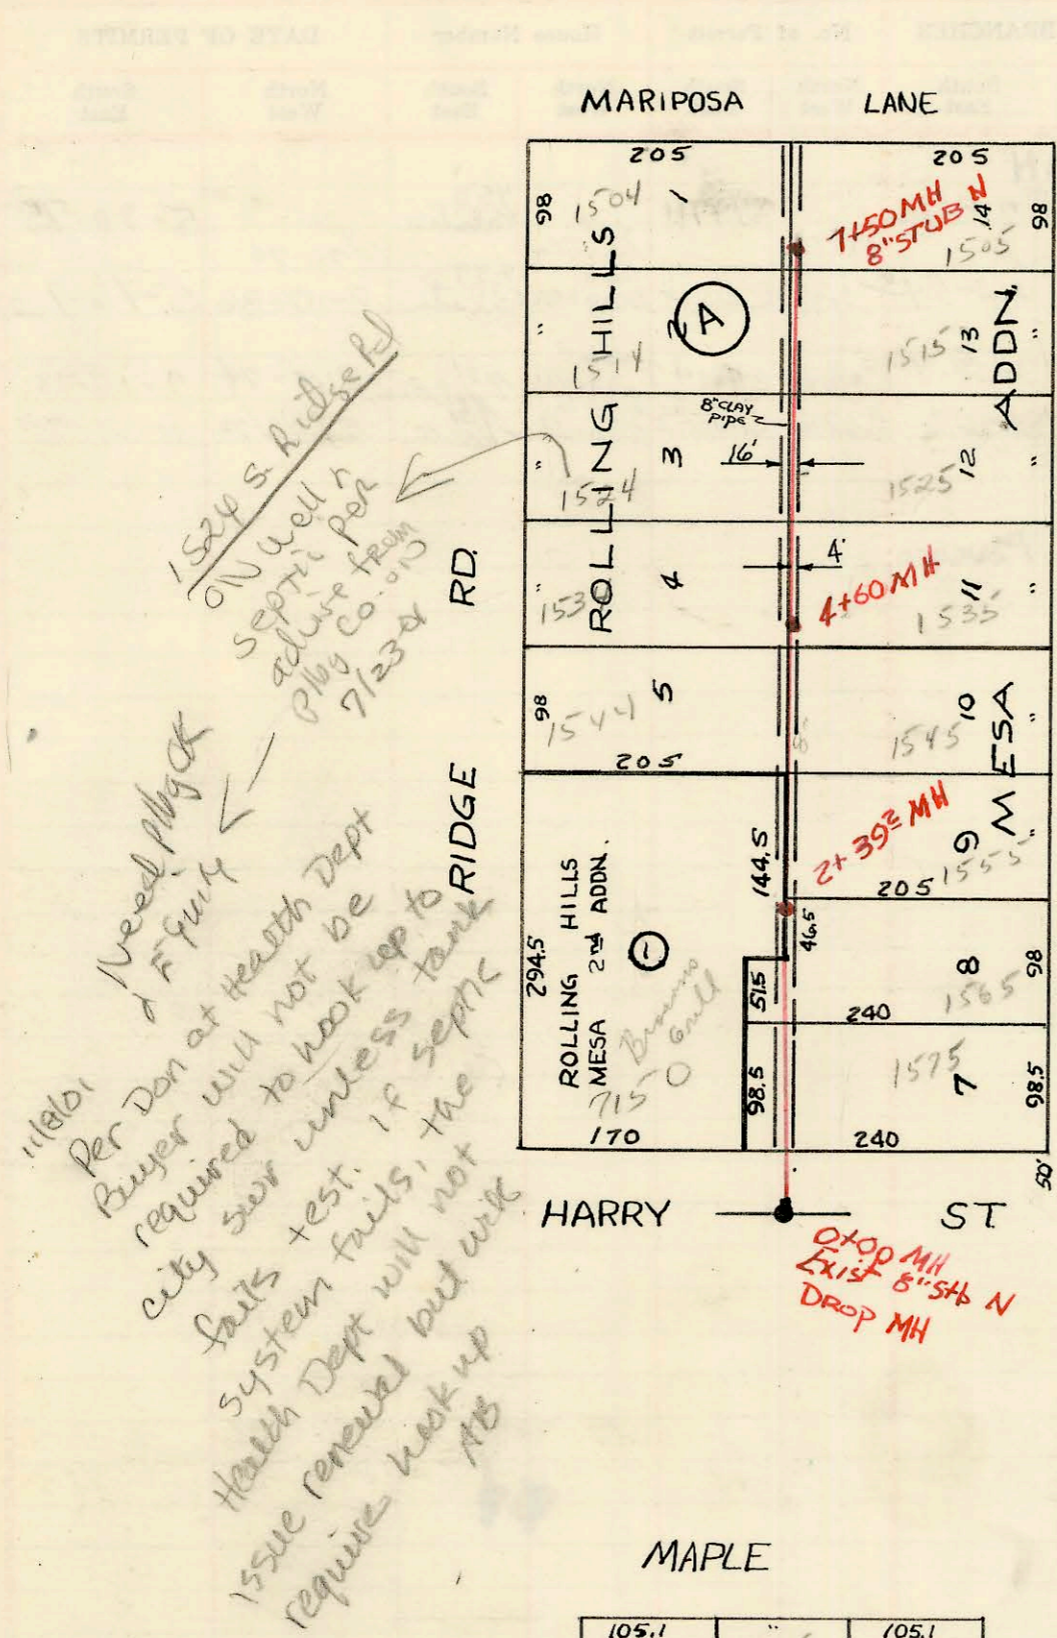

LAT 41, SWI
 MIDSTATES CONST. CO
 BOOKED 4-12-72 K-105
 DBKL 571012

ON MAP

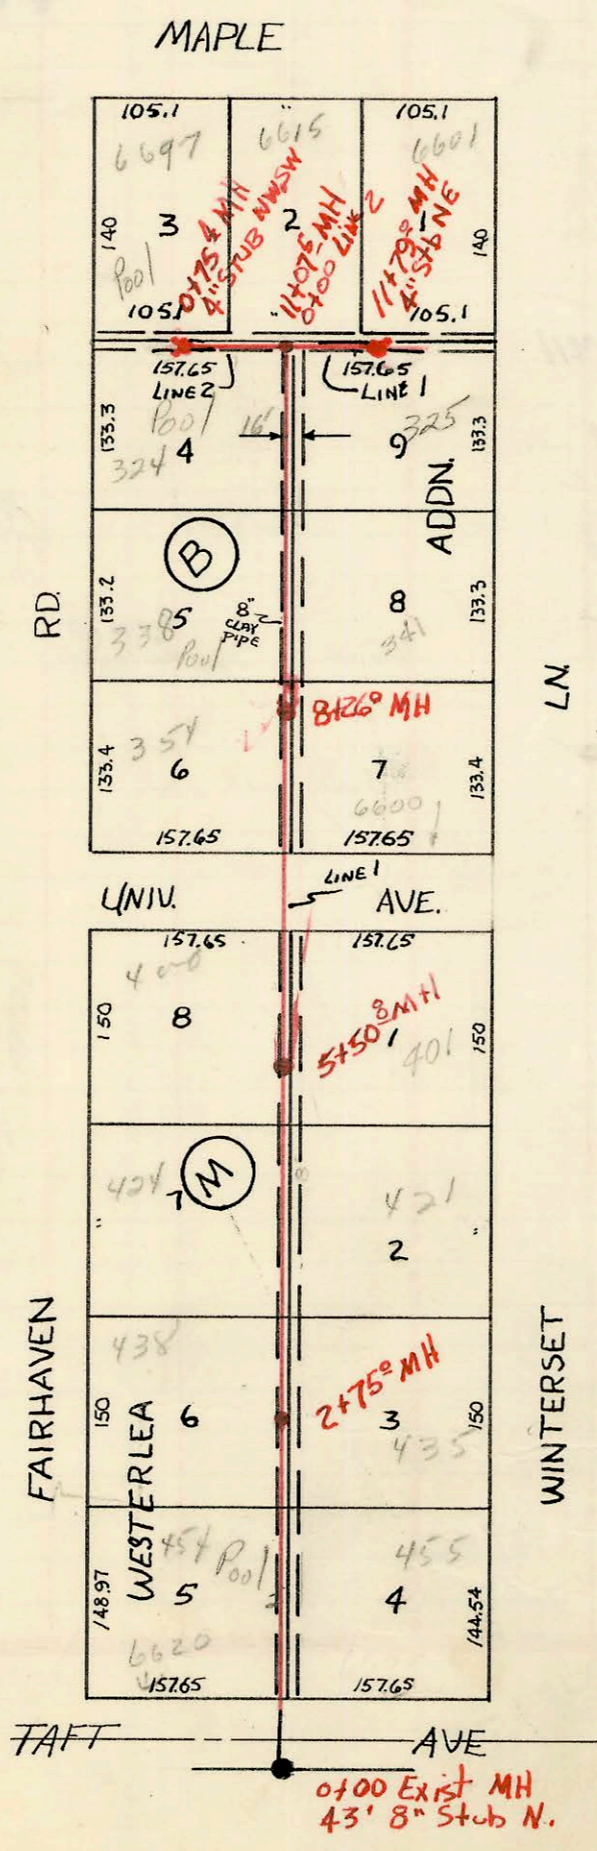

LAT 13-4 SWI.
 W.B. CARTER CONST. CO
 BOOKED 4-12-72 K-107
 DBKL 572010

ON MAP

CONSTRUCTION RECORD

SERVICE RECORD

| STATION | ELEVATION | | Depth | MANHOLE | 4-INCH "Y" BRANCHES | | No. of Permit | | House Number | | DATE OF PERMITS | |
|--------------------------------|-----------|--------|-------|---------|---------------------|------------|---------------|------------|--------------|------------|-----------------|------------|
| | Ground | Grade | | | North West | South East | North West | South East | North West | South East | North West | South East |
| | 131.7 | 122.00 | 9.7 | 0+00 | Exist MH # Stub N. | | | | | | | |
| 1+00 | 131.0 | 122.20 | 8.8 | | | | | | | | | |
| 2+00 | 131.4 | 122.40 | 9.0 | | | | | | | | | |
| | 131.8 | 122.48 | 9.3 | 2+32.9 | | | | | | | | |
| 3+00 | 131.8 | 122.60 | 9.2 | | | | | | | | | |
| 4+00 | 130.9 | 122.80 | 8.1 | | | | | | | | | |
| | 131.0 | 122.90 | 8.1 | 4+60.0 | | HP | | | | | | |
| 5+00 | 131.3 | 123.00 | 8.3 | | | | | | | | | |
| 6+00 | 130.9 | 123.20 | 7.9 | | | | | | | | | |
| 7+00 | 130.9 | 123.40 | 7.5 | | | | | | | | | |
| | 131.3 | 123.50 | 7.8 | 7+50.0 | 8" Stb. N. | | | | | | | |
| <p>TRANSFERRED TO M-2 Book</p> | | | | | | | | | | | | |
| | | | | 0+00 | Exist M.H. Begin | | | | | | | |
| 0+43.0 | 120.4 | 111.44 | 8.9 | | | | | | | | | |
| 1+00 | 120.6 | 111.54 | 9.1 | | | | | | | | | |
| 2+00 | 120.7 | 111.74 | 8.9 | | | | | | | | | |
| | 120.8 | 111.90 | 8.9 | 2+75 | | | | | | | | |
| 3+00 | 120.7 | 112.00 | 8.7 | | | | | | | | | |
| 4+00 | 121.1 | 112.20 | 8.9 | | | | | | | | | |
| 5+00 | 120.9 | 112.40 | 8.5 | | | | | | | | | |
| | 121.1 | 112.50 | 8.6 | 5+50.0 | | | | | | | | |
| 6+00 | 121.1 | 112.60 | 8.5 | | | | | | | | | |
| 7+00 | 121.8 | 112.80 | 9.0 | | | | | | | | | |
| 8+00 | 122.2 | 113.00 | 9.2 | | | | | | | | | |
| | 122.1 | 113.10 | 9.0 | 8+26.0 | | | | | | | | |
| 9+00 | 122.2 | 113.20 | 9.0 | | | | | | | | | |
| 10+00 | 122.8 | 113.40 | 9.4 | | | | | | | | | |
| 11+00 | 122.7 | 113.74 | 8.9 | | | | | | | | | |
| | | | | 11+07.5 | | | | | | | | |
| | | | | 11+79.0 | 4" Stb NE | | | | | | | |
| LINE 2 | | | | 0+00 | = 11+07.5 LINE #1 | | | | | | | |
| | | | | 0+75.4 | 4" Stb NW & SW | | | | | | | |

| CONSTRUCTION RECORD | | | | | | SERVICE RECORD | | | | | | | | |
|---------------------|-----------|--------|-------|-------------------------------|---------------------------|-------------------|----------------------|------------------|------------------|--------------------|-------------------------------------|--------------------|------------------------------|--------|
| STATION | ELEVATION | | Depth | MANHOLE | 4-INCH "Y" BRANCHES | | No. of Permit | | House Number | | DATE OF PERMITS | | | |
| | Ground | Grade | | | North West | South East | North West | South East | North West | South East | North West | South East | | |
| 0+00 | 131.7 | 122.00 | 9.7 | 0+00 EXISTING MH & STUB N. | | 0+91.0 | | C44844 | | 1575 yuca | | 5-10-74 | | |
| 1+00 | | | | | 1+71 | 1+86 | | C31372 | 16490 | 7150 W Namy | 1565 yuca | 4-5-72 | 6-17-86 | |
| 2+00 | | | | | | | | | | | | | | |
| 3+00 | 131.8 | 122.48 | 9.3 | 2+39 ² | | 3 ² | | | | | | | | |
| 4+00 | | | | | 3+94.4 | 3+80 | | C48930 C32651 | 265164 | 1544 B Ridge Rd | 1555 yuca 1545 P yuca | 2-28-78 | 4-9-75 10-22-70 6-5-72 | |
| 5+00 | 131.0 | 122.90 | 8.1 | 4+60 ² | TAP 4+54 | MH tap | | 13589 | C31410 | 1538 Ridge Rd | 1535 yuca | 1-29-75 | 4-6-72 | |
| 6+00 | | | | | 6+20 ² | 5+75 ² | | | C31393 | 1514 S Ridge Rd | 1525 yuca | | 4-6-72 | |
| 7+00 | | | | | 7+45.56 | 6+89.2 | | C31721 | | 1504 Ridge Rd | 1515 yuca | 4-19-72 | | |
| 8+00 | 131.3 | 123.50 | 7.8 | 7-50 | 8" STUB N. | MH tap | | 11268 | C55845 C38462 | 1504 Ridge Rd | 1505 yuca | 6-21-84 | 6-10-76 4-23-73 | |
| 0+00 | | | | 0+00 EXISTING MH & STUB | | | | | | | | | | |
| 0+43 ² | 120.4 | 111.44 | 8.9 | BEGIN | 1+35 | 1+27 | | C48792 | C40550 | 454 Fairhaven | 455 Winterset | 3-25-75 | 8-10-73 | |
| 1+00 | | | | | 2+86 | 2+71 | | C31729 | C40036 | 438 Fairhaven | 435 Winterset | 4-19-72 | 7-13-73 | |
| 2+00 | 120.8 | 111.90 | 8.9 | 2+75 | | | | | | | | | | |
| 3+00 | | | | | | 3+96 | | | C31656 | 421 Winterset | | | 4-17-72 | |
| 4+00 | | | | | 4+14 | | | | C31511 | 424 Fairhaven | | | 4-11-72 | |
| 5+00 | 121.1 | 112.50 | 8.6 | 5+50 ² | TAP 5+57 | MH TAP 5+50 | | C31730 | C31874 | 400 Fairhaven | 401 Winterset | 4-19-72 | 4-6-72 | |
| 6+00 | | | | | 7+80 | 7+90 | | | C31512 | C31417 | 354 Fairhaven | 6000 UNIVERSITY | 4-11-72 | 4-6-72 |
| 7+00 | | | | | | | | | | | | | | |
| 8+00 | 122.1 | 113.10 | 9.0 | 8+26 ² | | | | | | | | | | |
| 9+00 | | | | | 9+00 | 9+41 | | C33254 | C31418 | 338 Fairhaven | 341 Winterset | 6-29-72 | 4-6-72 | |
| 10+00 | | | | | | 10+11 | | | C31426 | | 325 Winterset | | 4-6-72 | |
| 11+00 | | | | | 11+07 ⁵ | | | | | | | | | |
| | | | | | 11+79 ² | 4" STUB NE | | | | | | | | |
| LINE 2 | | | | | 0+00 = 11+07 ⁵ | LINE #1 | | C31425 | | 6615 W maple | | 4-6-72 | | |
| | | | | | 0+75 ⁴ | 4" STUB NW & SW | MH tap 4" stub NW | | C31994 C39264 | | 324 Fairhaven 6615 W maple | | 5-2-72 5-29-73 | |