


Lat 12 - 4 - SW.I.  
 W.B. Carter Const. Co.  
 Booked 4-12-72 K 107  
 DBKL572009

ON MAP

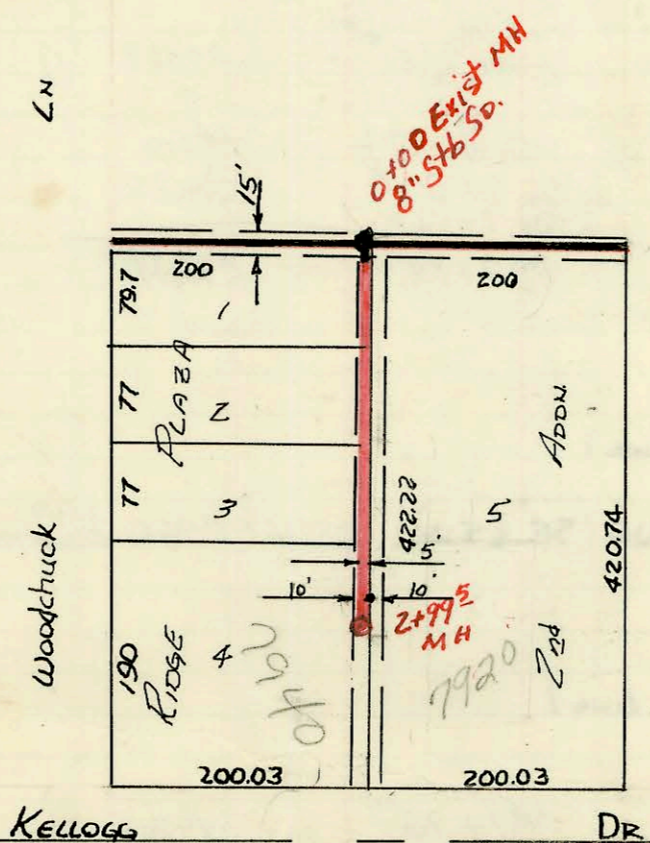

Lat 27, S.W.I.  
 W.B. Carter Const. Co.  
 Booked 4-12-72 K-102  
 DBKL569046

ON MAP

**CAUTION**  
**UNDERGROUND UTILITIES**  
 Please check with K G & E or  
 Southwestern Bell  
 Telephone Co. for Location

U.S. 54 West

CONSTRUCTION RECORD						SERVICE RECORD							
STATION	ELEVATION		Depth	MANHOLE	4-INCH "Y" BRANCHES		No. of Permit		House Number		DATE OF PERMITS		
	Ground	Grade			North West	South East	North West	South East	North West	South East	North West	South East	
0+40 <sup>e</sup>	131.9	122.00	9 <sup>g</sup>	0+00	Exist MH								
1+00					BEGIN	0+51.6		C49711		453 Palatin		5-30-75	
2+00					1+08.0 TAP		58272		400 Sculler	439 Palatin	10-20-76		
					2+35.3 TAP	2+54.6		10947 C32264	436 Sculler	439 Palatin	9-10-86	5-16-72	
4+00	131.6	122.60	9 <sup>e</sup>	2+99 <sup>z</sup>	4+05.2 TAP	3+58.9		C4843	C40147	422 S Sculler	421 Palatin	5-10-74	7-17-73
5+00					5+50.9 TAP	5+56.4		C32483	C52552	400 S Sculler	401 Palatin	5/26/72	11-21-75
6+00	130.3	123.20	7 <sup>l</sup>	5+99 <sup>4</sup>									
6+50	FLOW LINE ELEV. 123.30				Ero line PLUGGED								
LAT. 27 S.W.I.													
0+05 <sup>e</sup>	141.0	129.15	11.9	0+00	Exist MH.								
1+00					BEGIN								
2+00						1+55.6		C54267		7920 W. Kellogg		3-17-76	
	139.3	130.95	8.4	2+99 <sup>z</sup>	2+91.0 <sup>z</sup>		6692		7940 W. Kellogg			10-8-82	