


Lat 7-4-SWI
W.B. Carter Const Co.
Booked 4-12-72 K-106
DBKL 571041

ON MAP

or L9
522
B-2-71
W. 36th N.

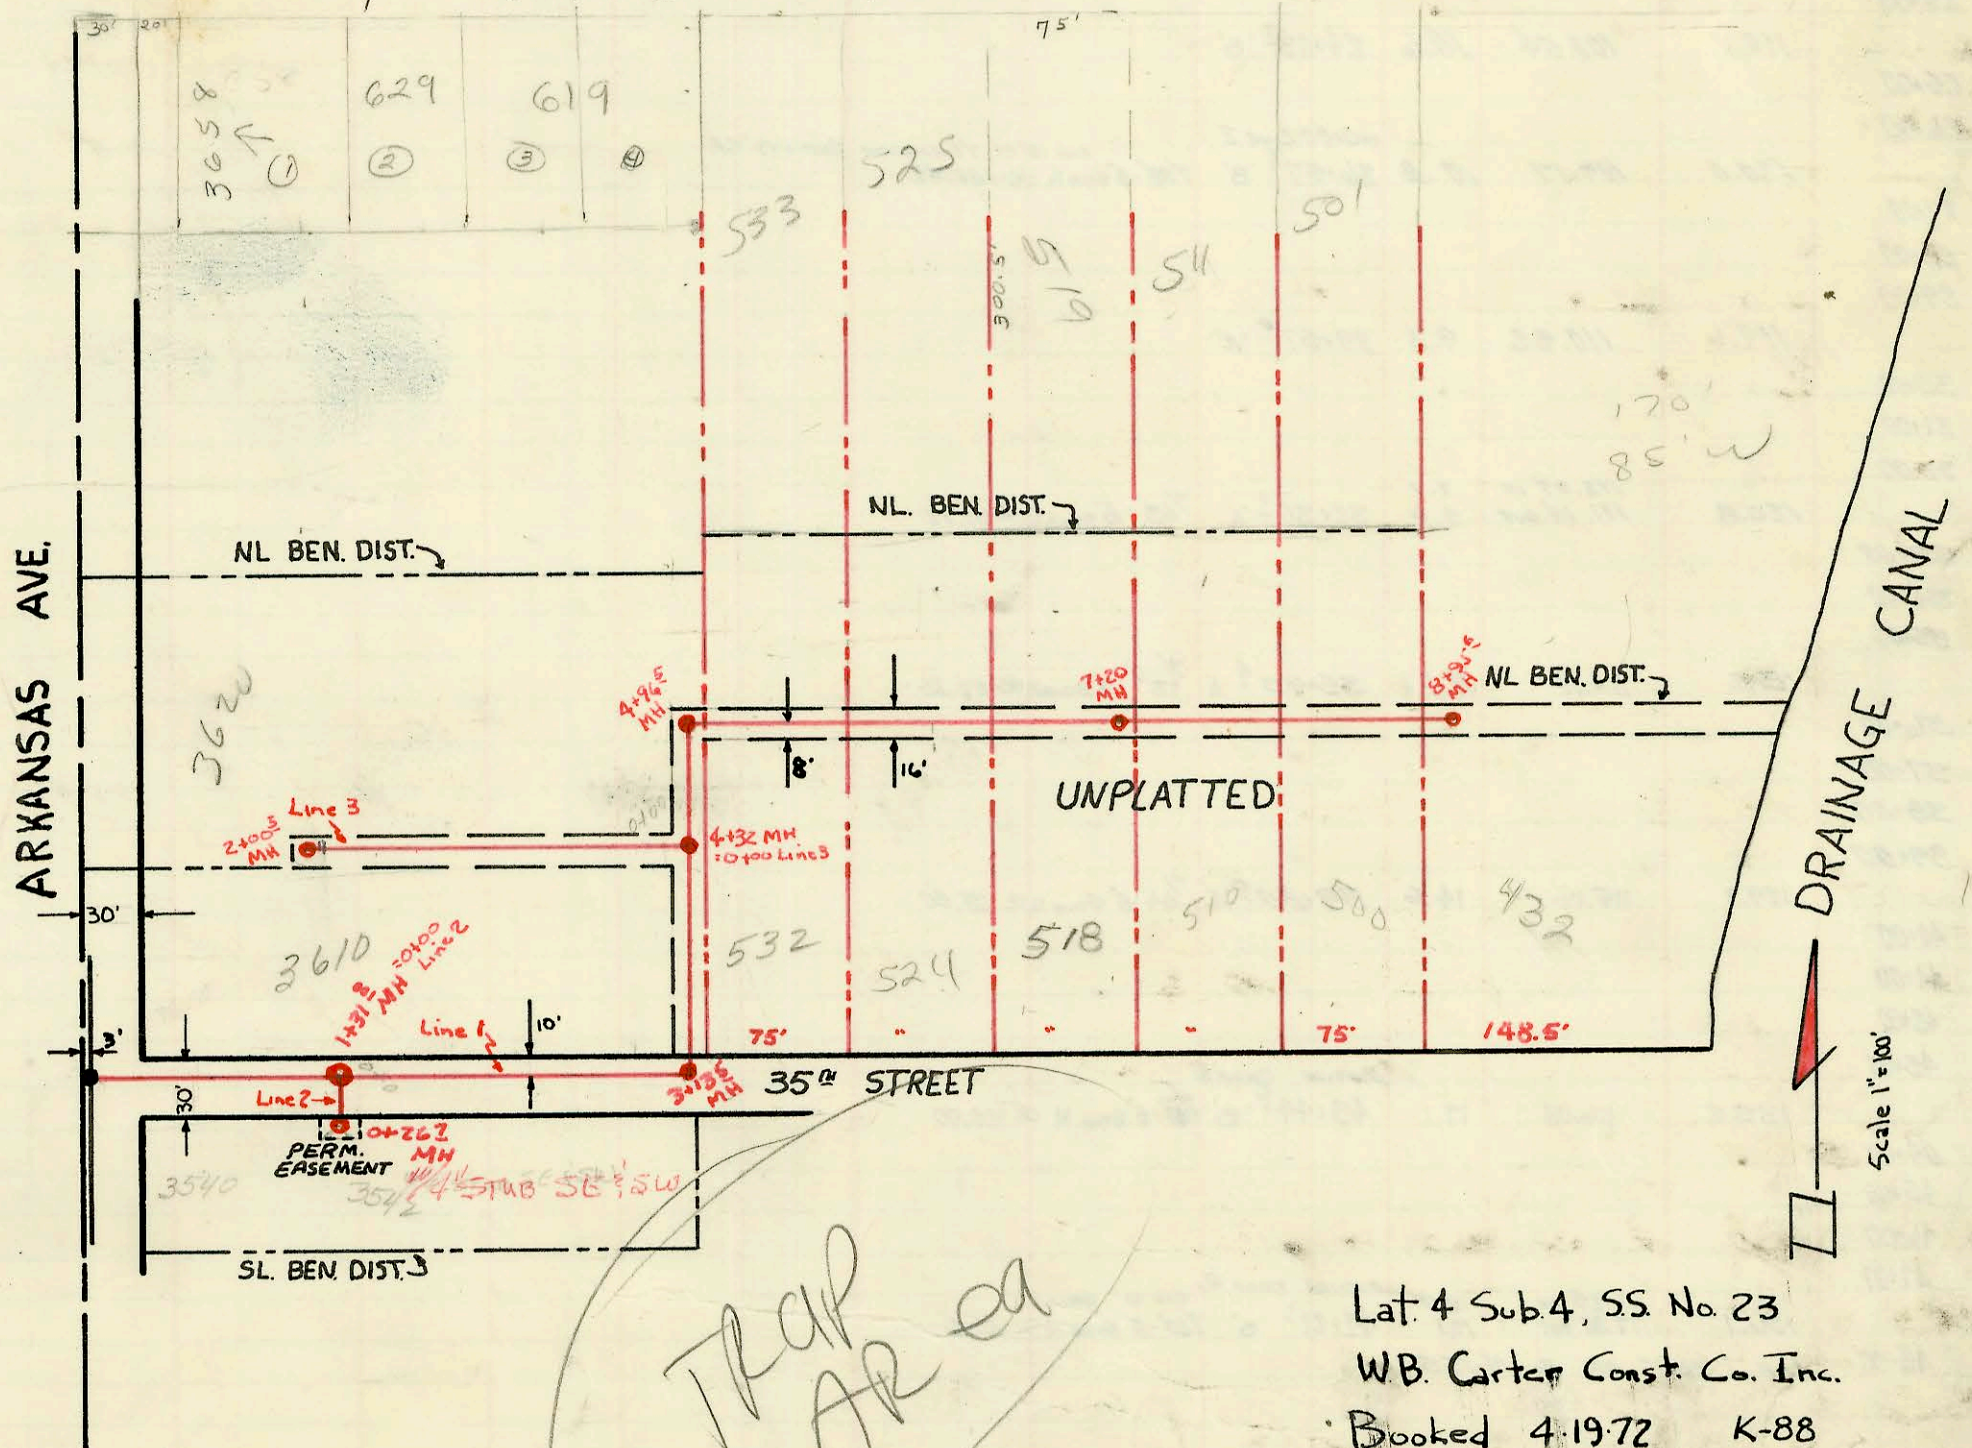

Lat 4 Sub 4, SS No 23
W.B. Carter Const. Co. Inc.
Booked 4-19-72 K-88
DBKL 570048

TRAP AREA

ON MAP

CONSTRUCTION RECORD						SERVICE RECORD						
STATION	ELEVATION		Depth	MANHOLE	4-INCH "Y" BRANCHES		No. of Permit		House Number		DATE OF PERMITS	
	Ground	Grade			North West	South East	North West	South East	North West	South East	North West	South East
0+05 ^e		123.40		0+00	Exist M.H. Begin							
1+00												
2+00												
3+00	133.7	124.36	9 ³	2+43 ^e	M.H. 50		C76423		7140 W Kelloff		2-5-80	
4+00	134.8	125.10	9 ¹	4+00 ^e	M.H. 50 4+34.6		C76419 C35606		7150 W Kelloff 7170 W Kelloff		2-5-80 5-7-80 10-26-72	
5+00												
6+00	134.1	126.10	8 ⁰	6+67 ^s	End 4" stub N.							
Lat 4, Sub. 4, SS #23												
LINE 1												
0+00	129.6	121.55	8.1	0+00	EXIST. M.H. 8" STUB E.							
1+00												
2+00	129.4	121.81	7.6	1+31 ^e	0+00 Ln. 2							
3+00												
4+00	129.6	122.18	7.4	3+13 ^e								
5+00	128.9	122.51	6.4	4+32 ^e	0+00 Ln. 3							
6+00	129.9	123.74	7.1	4+96 ^e								
7+00						top 5+34.1	C50123		532 W. 35 th St. N.		7-1-75	
8+00						6+24.5 ^{top}	20568		524 W. 35 th N.		4-28-77	
9+00	130.7	123.2	7.5	7+20 ^e		top 6+99 ⁰	C4215		518 W. 35 th N.		4-1-74	
10+00						top 7+69 ⁶	C44085		510 W. 35 th N.		3-22-74	
11+00	131.3	123.9	7.4	8+95 ^e		top 8+43.6	C42354		354 W. 35 th N.		11-16-73	
12+00						top 8+89.4	C61099		432 W. 35 th N.		2-27-76 5-12-77	
LINE 2												
0+00				0+00	= 1+31 ^e LINE 1							
1+00	130.5	122.02	8.5	0+26 ¹	4" STUB SE & SW		C34167	C34168	3540 Arkansas	3542 Arkansas	8-9-72	8-9-72
LINE 3												
0+00	128.9	122.62	6.3	0+00	= 4+32 LINE 1							
1+00												
2+00	129.9	123.41	6.5	2+00 ^e		top 1+96 ²	C44740		3610 Arkansas		5-3-74	
						top 1+95.1	C60005		3620 Arkansas		2-18-77	

4+00 C76423 70 7140 W Kelloff 2-5-80
 4+00 C76419 70 7150 W Kelloff 2-5-80