
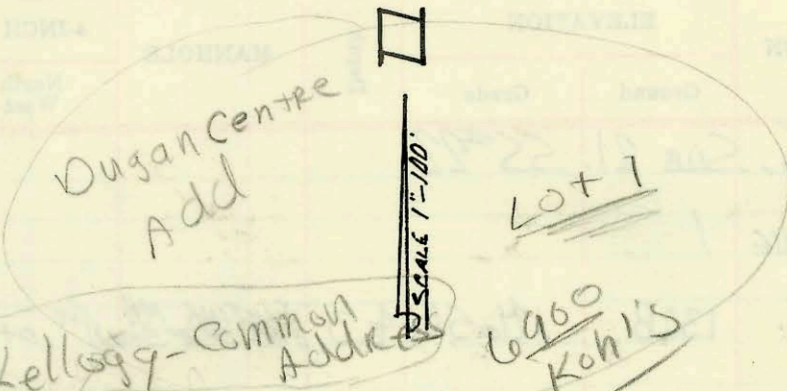


M-163A

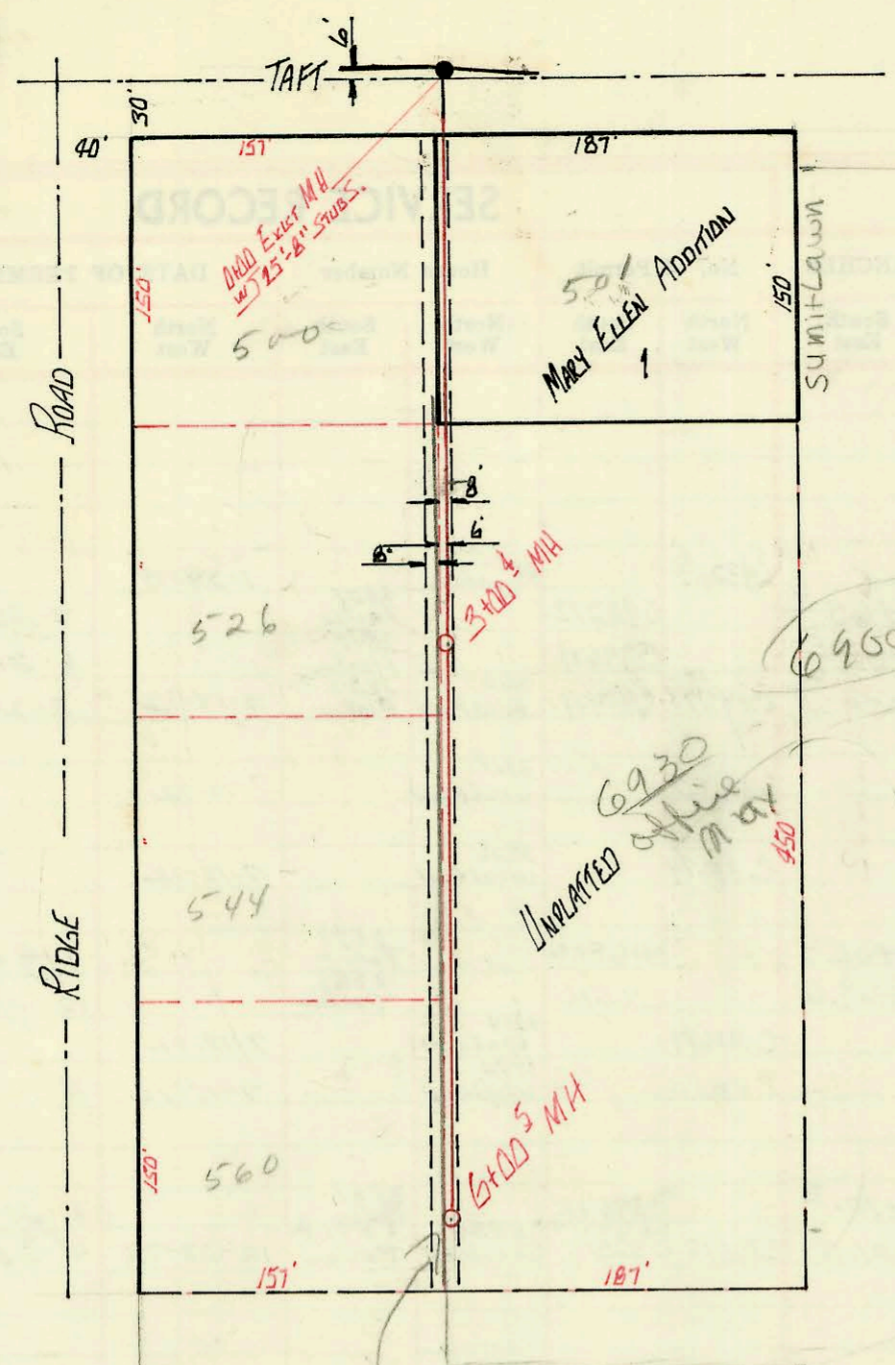


6900 W Kellogg - Common Address
 6920 Circuit City
 LAT 14, MAIN 4, S.W.I.
 BUILT BY: MID-STATES CONST. CO.
 BOOKED 19 JULY 72 FROM K-100
 PROJECT No DBKL 512011

Refer to N-119

Lot 1 served on map with sewer unless lot split no fee in City per Ord. 12-694

Main EXT
 666 Gordon Canal

LOT 2 - Dugan Centre add require main EXT to serve this lot if Bdy on this lot

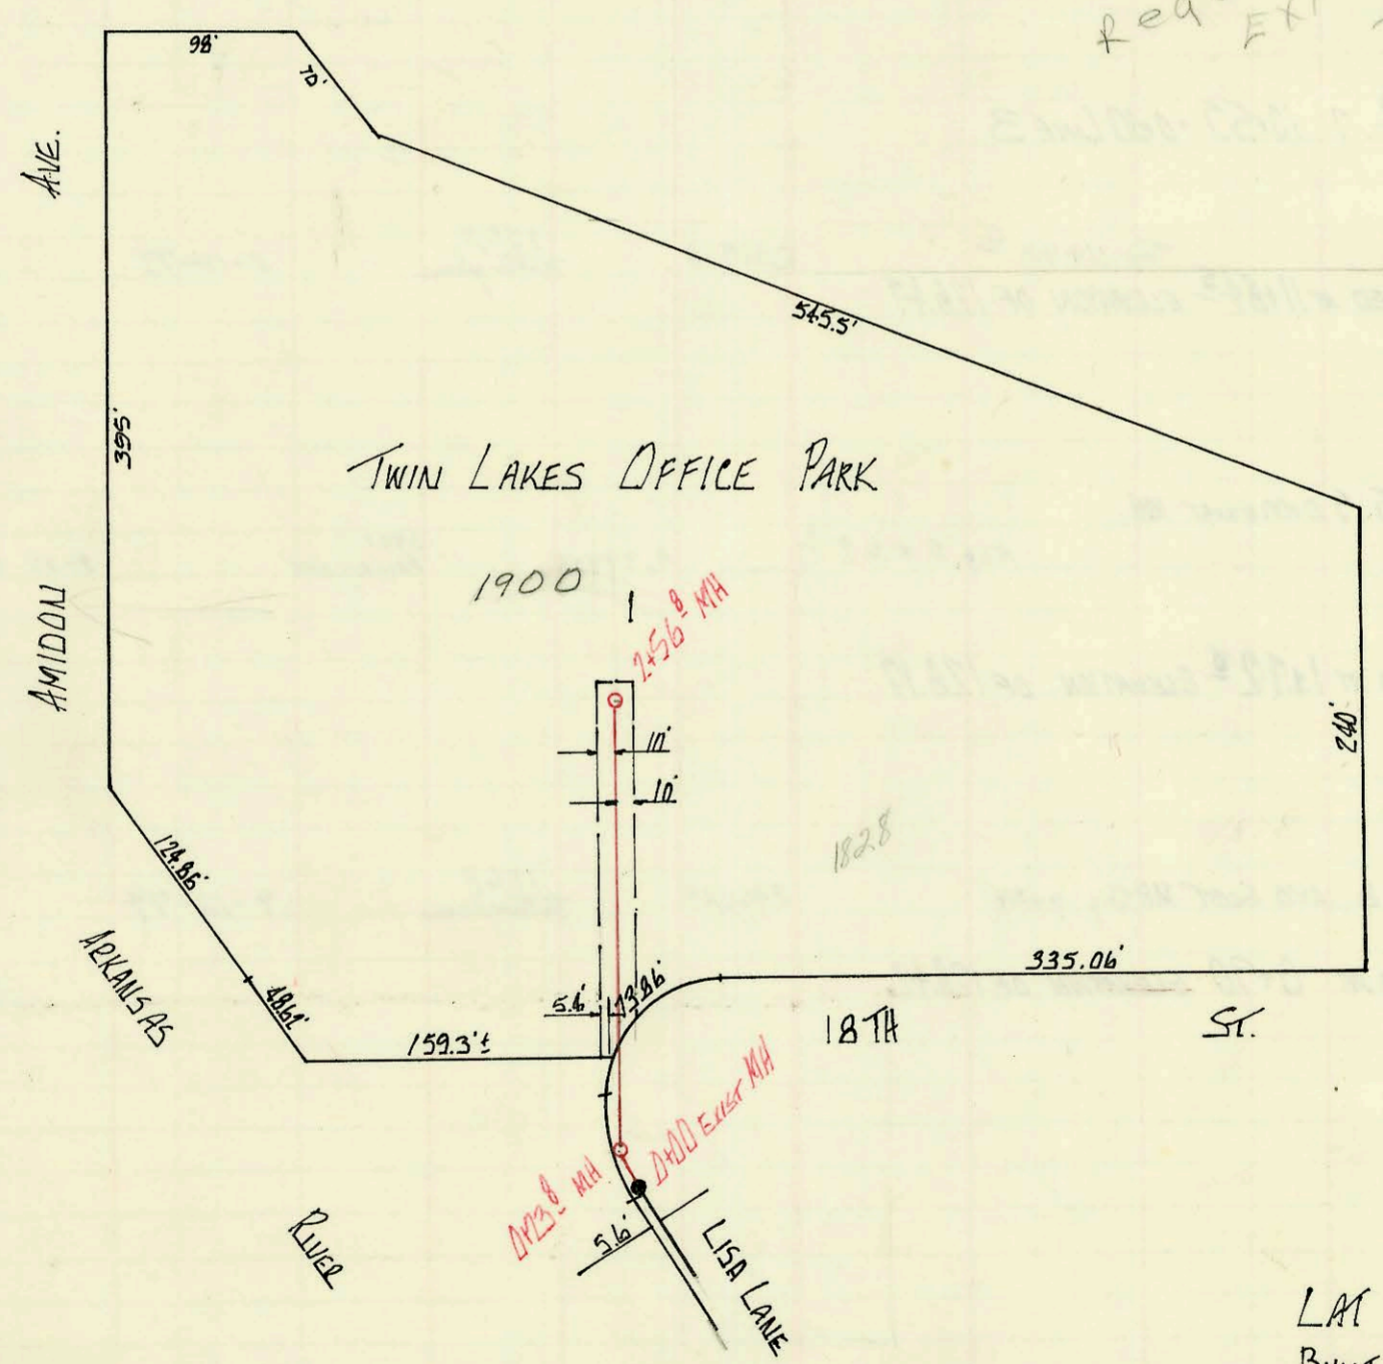

LAT 13, DIST. R, SS #20
 BUILT BY MID-STATES CONST CO INC
 BOOKED 19 JULY 72 FROM K-107
 PROJECT No DBKL 512001

on map

M-163

Form 42-020

CONSTRUCTION RECORD						SERVICE RECORD						
STATION	ELEVATION		Depth	MANHOLE	4-INCH "Y" BRANCHES		No. of Permit		House Number		DATE OF PERMITS	
	Ground	Grade			North West	South East	North West	South East	North West	South East	North West	South East
LAT 14, MAIN 4, S.W.I.												
0+00	131.4	126.07	11.4	EXISTING MH 0+00 25'-8" S. S.								
1+00					top 1+39 ⁵	top 1+36 ⁵	C33481	C33480	500 S Ridge Rd	501 Summit lawn	7-10-72	7-10-72
2+00	135.4	126.67	8.7	3+00 ⁴	top 2+54 ⁸							
4+00					top 4+36 ¹		C46938		544 S. Ridge Rd.		10-7-74	
5+00	133.5	127.27	6.2	6+00 ⁵	top 5+76 ⁵		C48842		560 S. Ridge Rd.		3-31-75	
LAT 13, DIST R, SS# 20												
0+00	123.1	115.17	7.9	EXISTING MH 0+00								
	123.0	115.27	7.7	0+23 ⁸	top 0+87 ⁸		C51144		1928 W. 18th		9-3-75	
1+00					top 1+84 ⁸		C48191		1828 W. 18th		1-27-75	
2+00					Wye 2+14		C33392		1900 W. London (Club house)		7-6-72	
	123.4	116.31	7.1	2+56 ⁸	6" M.H. Steel		C33321		1900 W. London (office bldg.)		6-30-72	

NK
9675527 5-21-96 6900 w Kellogg (and add 6920 office May) 4" PVC 40 TAP 2+14.8