


SERVICE RECORD



CONSTRUCTION RECORD

LAT 8, SUB 3, S.W.I.
BUILT BY MID STATES CONST. CO.
BOOKED 31 JULY 72 FROM SS #12 J.K.
PROJ. NO DBKL 570058

on map

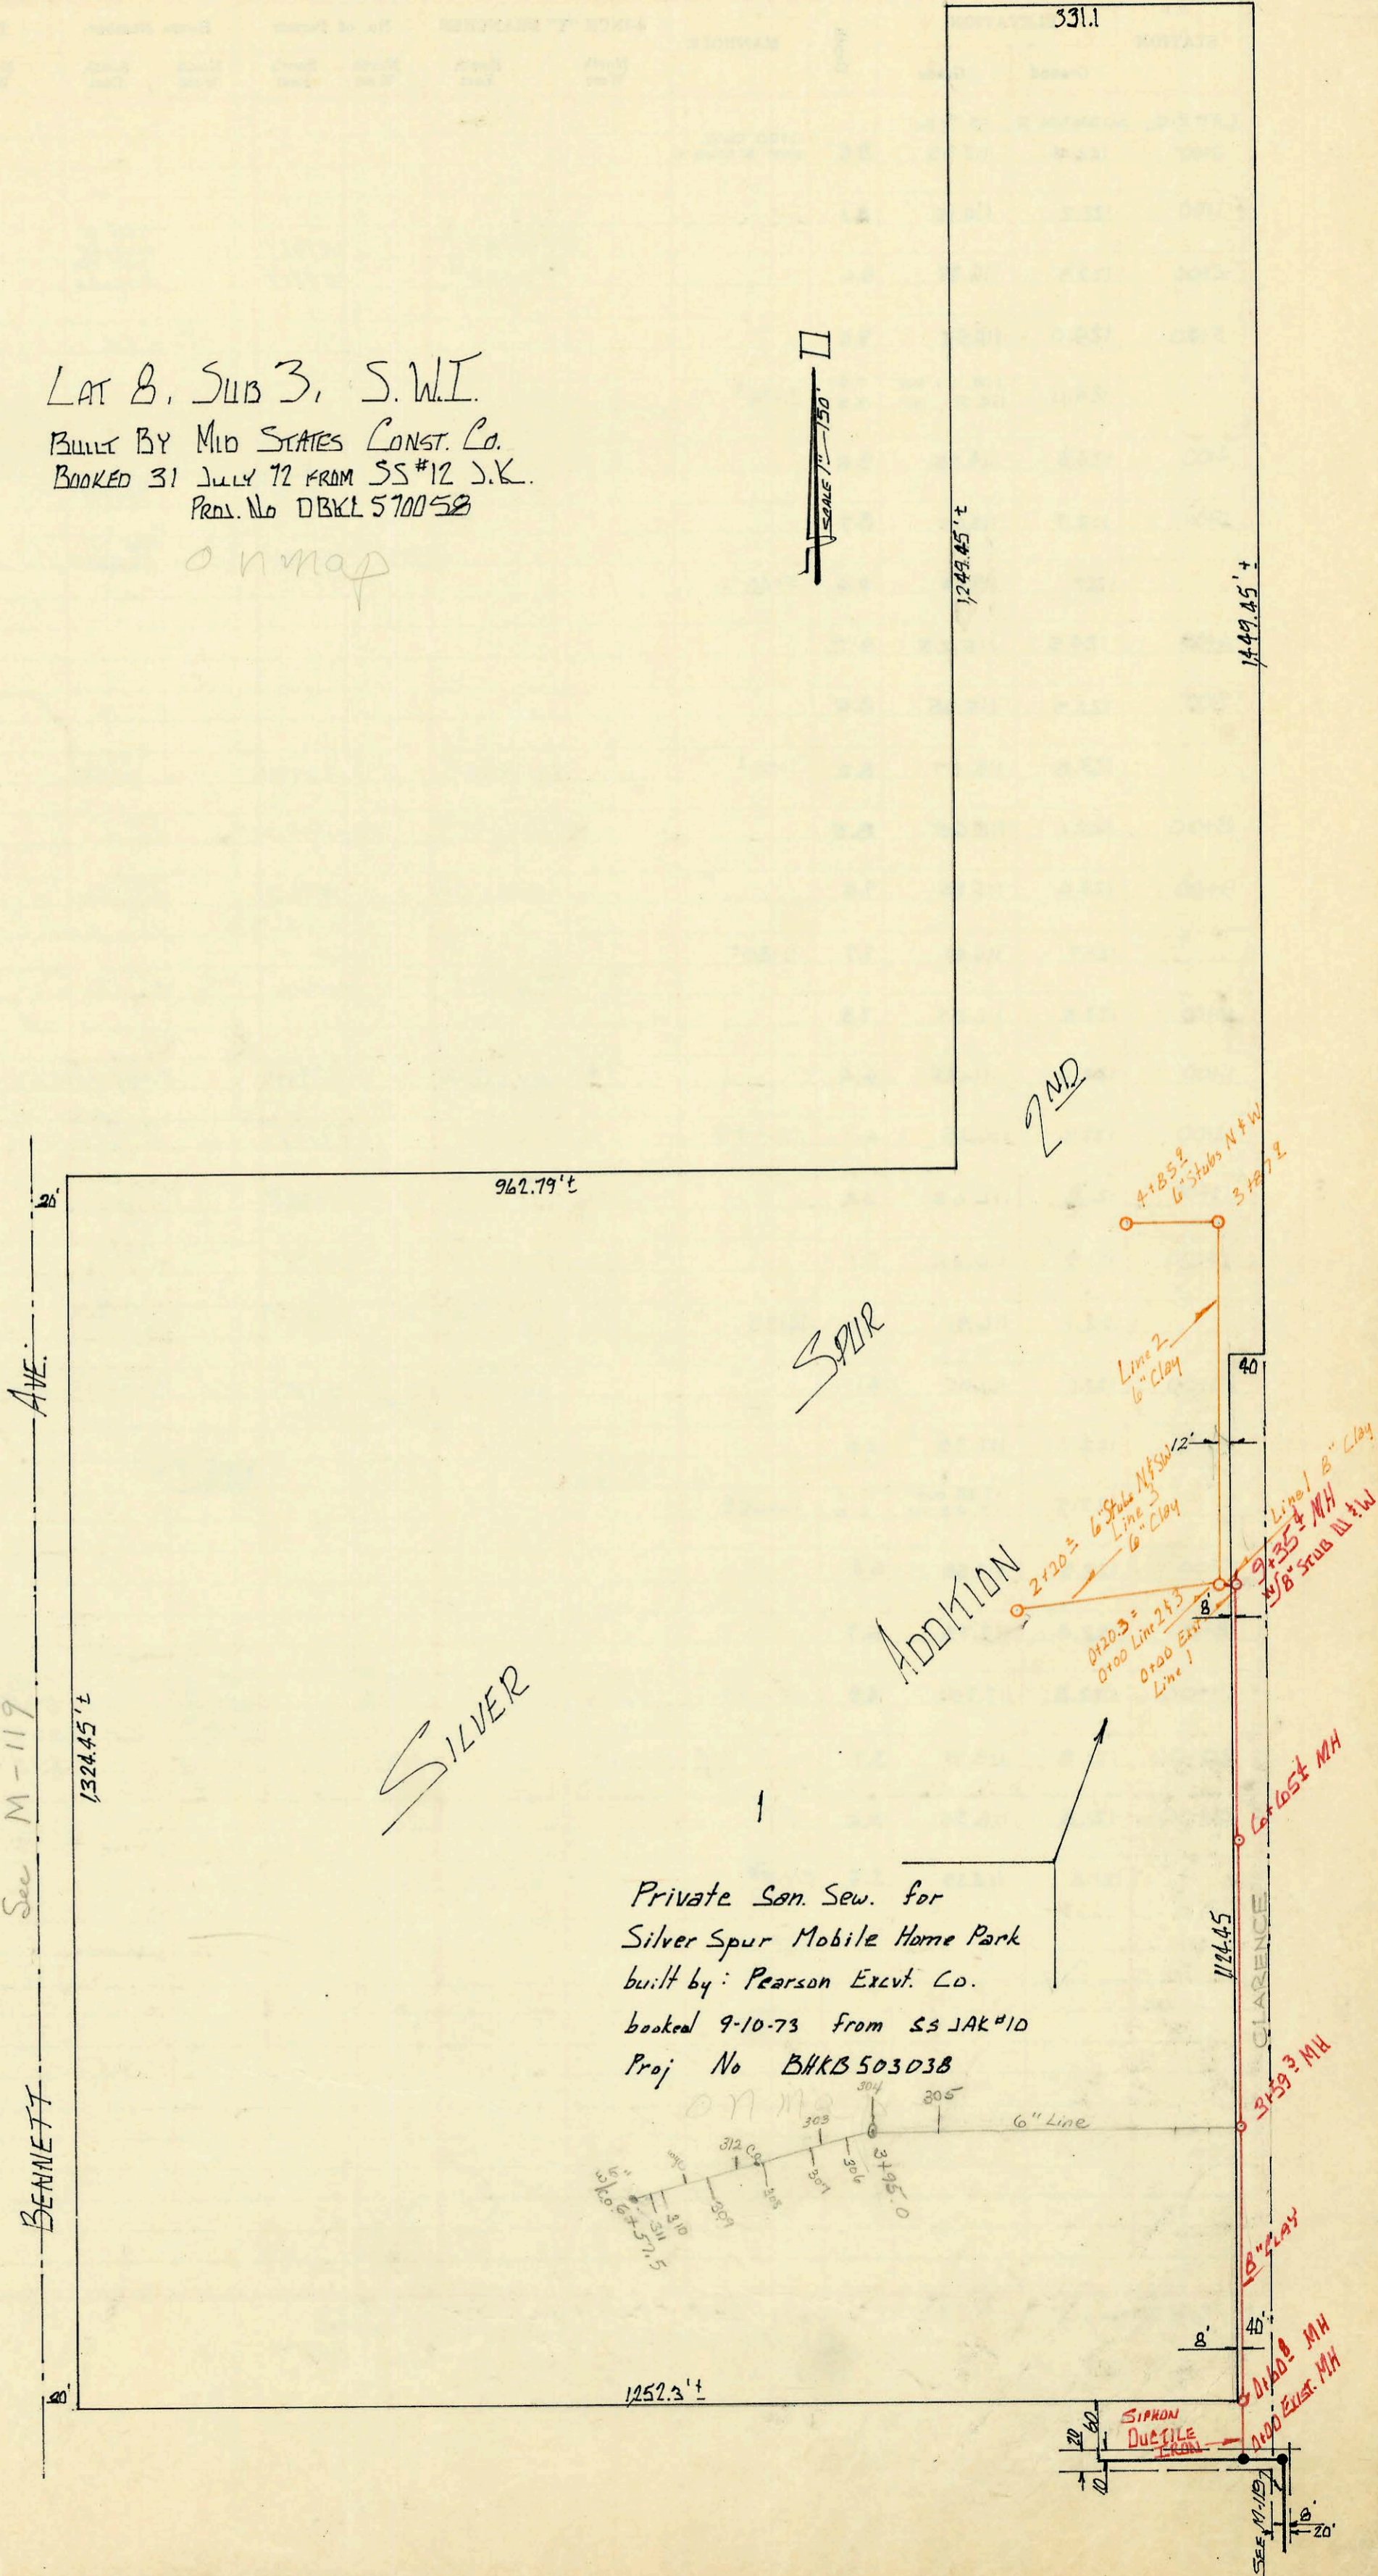

Private San. Sew. for
Silver Spur Mobile Home Park
built by: Pearson Excut. Co.
booked 9-10-73 from SS JAK #10
Proj No BHK 503038

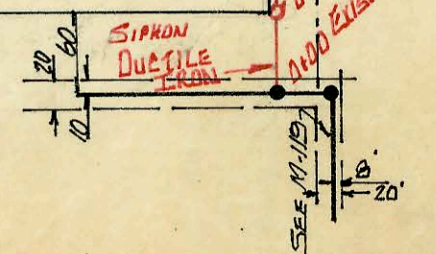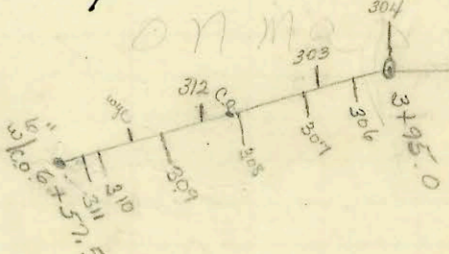

CONSTRUCTION RECORD						SERVICE RECORD						
STATION	ELEVATION		Depth	MANHOLE	4-INCH "Y" BRANCHES		No. of Permit		House Number		DATE OF PERMITS	
	Ground	Grade			North West	South East	North West	South East	North West	South East	North West	South East
LAT B, SUB 3, S.W.I.												
0+00	87.2	81.02	6.2	0+00 EXIST MH	BEGIN DUCTILE IRON SIPHON							
0+60	END DUCTILE IRON SIPHON			BEGIN 8" CLAY PIPE								
	87.3	81.60	6.3	0+60								
1+00												
2+00												
3+00												
	86.6	82.20	4.4	3+59								
4+00												
5+00												
6+00												
	87.5	82.66	4.8	6+54	MNT Taper		9917		1915 W. MacArthur		1-4-84	
7+00												
8+00												
9+00												
	88.2	83.35	4.9	9+35	6" STUBS N & W		240859		1915 W. MacArthur		8-23-73	
Priv. San. Sew. for Silver Spur Mobile Home Park												
Line #1												
0+00	88.3	83.29	5.0	0+00 EXIST								
	88.8	83.49	5.3	0+20.3								
Line #2												
0+00	88.8	84.33	4.5	0+00-0+20.3 Line 1								
1+00	88.9	85.19	3.7									
2+00	89.3	86.04	3.3									
3+00	89.1	86.88	2.2									
	89.4	87.62	1.8	3+87.9								
4+00	89.5	87.74	1.8				98-10857		1915 MacArthur Lot #21		6-14-98	
	90.6	88.44	2.2	4+85.9	6" STUBS N & W							
Line #3												
0+00	88.8	85.23	3.6	0+00-0+20.3 Line 1								
1+00	88.5	86.04	2.5									
2+00	88.6	86.87	1.7									
	89.7	87.05	2.9	2+20.2	6" STUBS N & W							

SWR 2000-02284-10/18/00-1915 MacArthur - ASAP PLUG - Private main ext to serve lots 1-6 / Trap @ MH / 1-6" FERNCO
 10308-303-1915 W MacArthur - 2-23-84 Roger Mendenhall - 0+00 W (4+56.5) tap 61.5 SW of 3+95.0
 10309-304 - (MH stub) 3+95.0 MH
 10310-305 (3+25.0) tap 325' W of 0+00
 10311-306 (4+28.5) tap 33.5 SW of 3+95.0
 10312-307 (4+66.0) tap 71.5 SW of 3+95.0
 10313-308 (5+21.5) tap 126.5 SW of 3+95.0
 10314-309 (5+79.0) tap 184.0 SW of 3+95.0
 10315-310 (6+31.0) tap 231.0 " " "
 10316-311 (6+44.0) tap 249.0 " " "
 10317-312 (5+46.0) tap 145.0 " " "
 10318-313 (6+05.0) tap 210.0 " " "

2001-01023-4/27/01-1915 W MacArthur # 80-ASAP Plug - 4" SCH 40 - MH Inlet - Replace upper 3' of line

C 54180 - 1915 W. MacArthur - Ext. of 6" line for mobile home park - 3/15/76 - Jerry Pearson, Jr.
 97-311-7 3597 1915 MAC ARTHUR Recreation Bldg - Seneca Const Co
 98-57377 4-14-98 1915 W MacArthur. Pool House - 98-10616-7 6-14-98 1915 W MacArthur Lots 121