



SERVICE RECORD

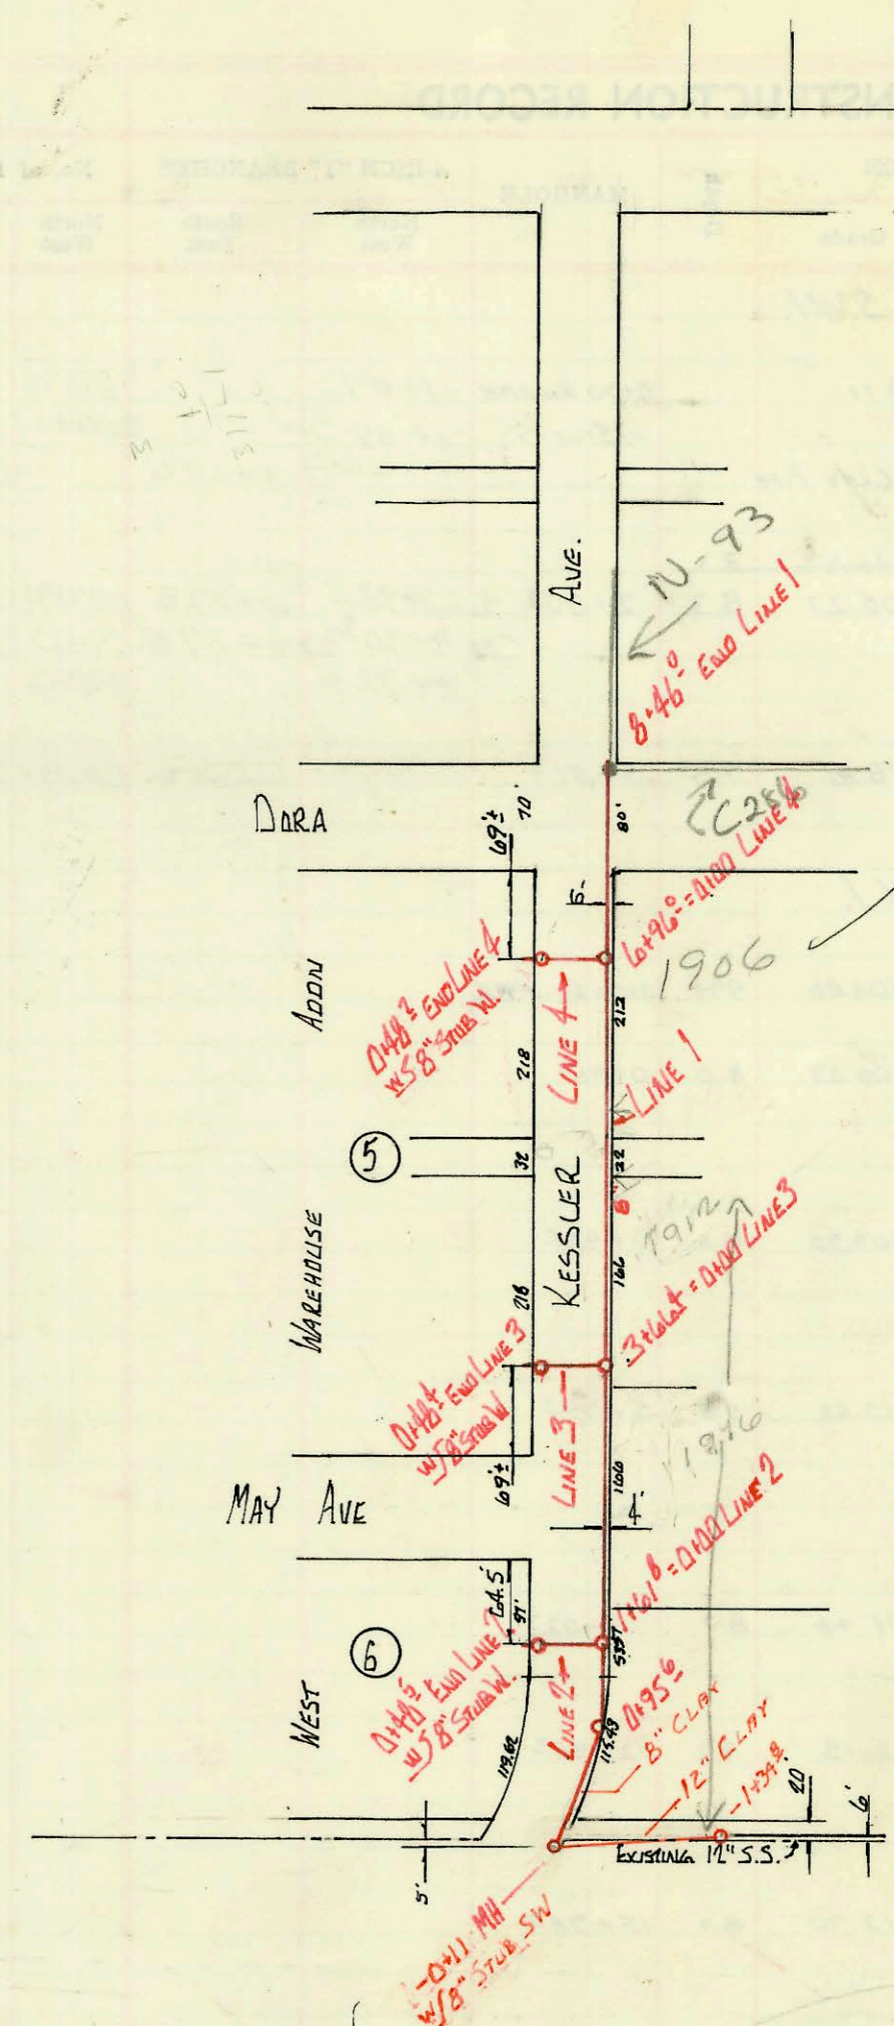

WEST WAREHOUSE ADON
PRIVATE S.S. FOR BLK 5 & 6
BUILT BY: UTILITY CONTRACTORS INC.
BOOKED 25 SEPT 71 FROM SS JK #1
PROJECT No AAKB502009

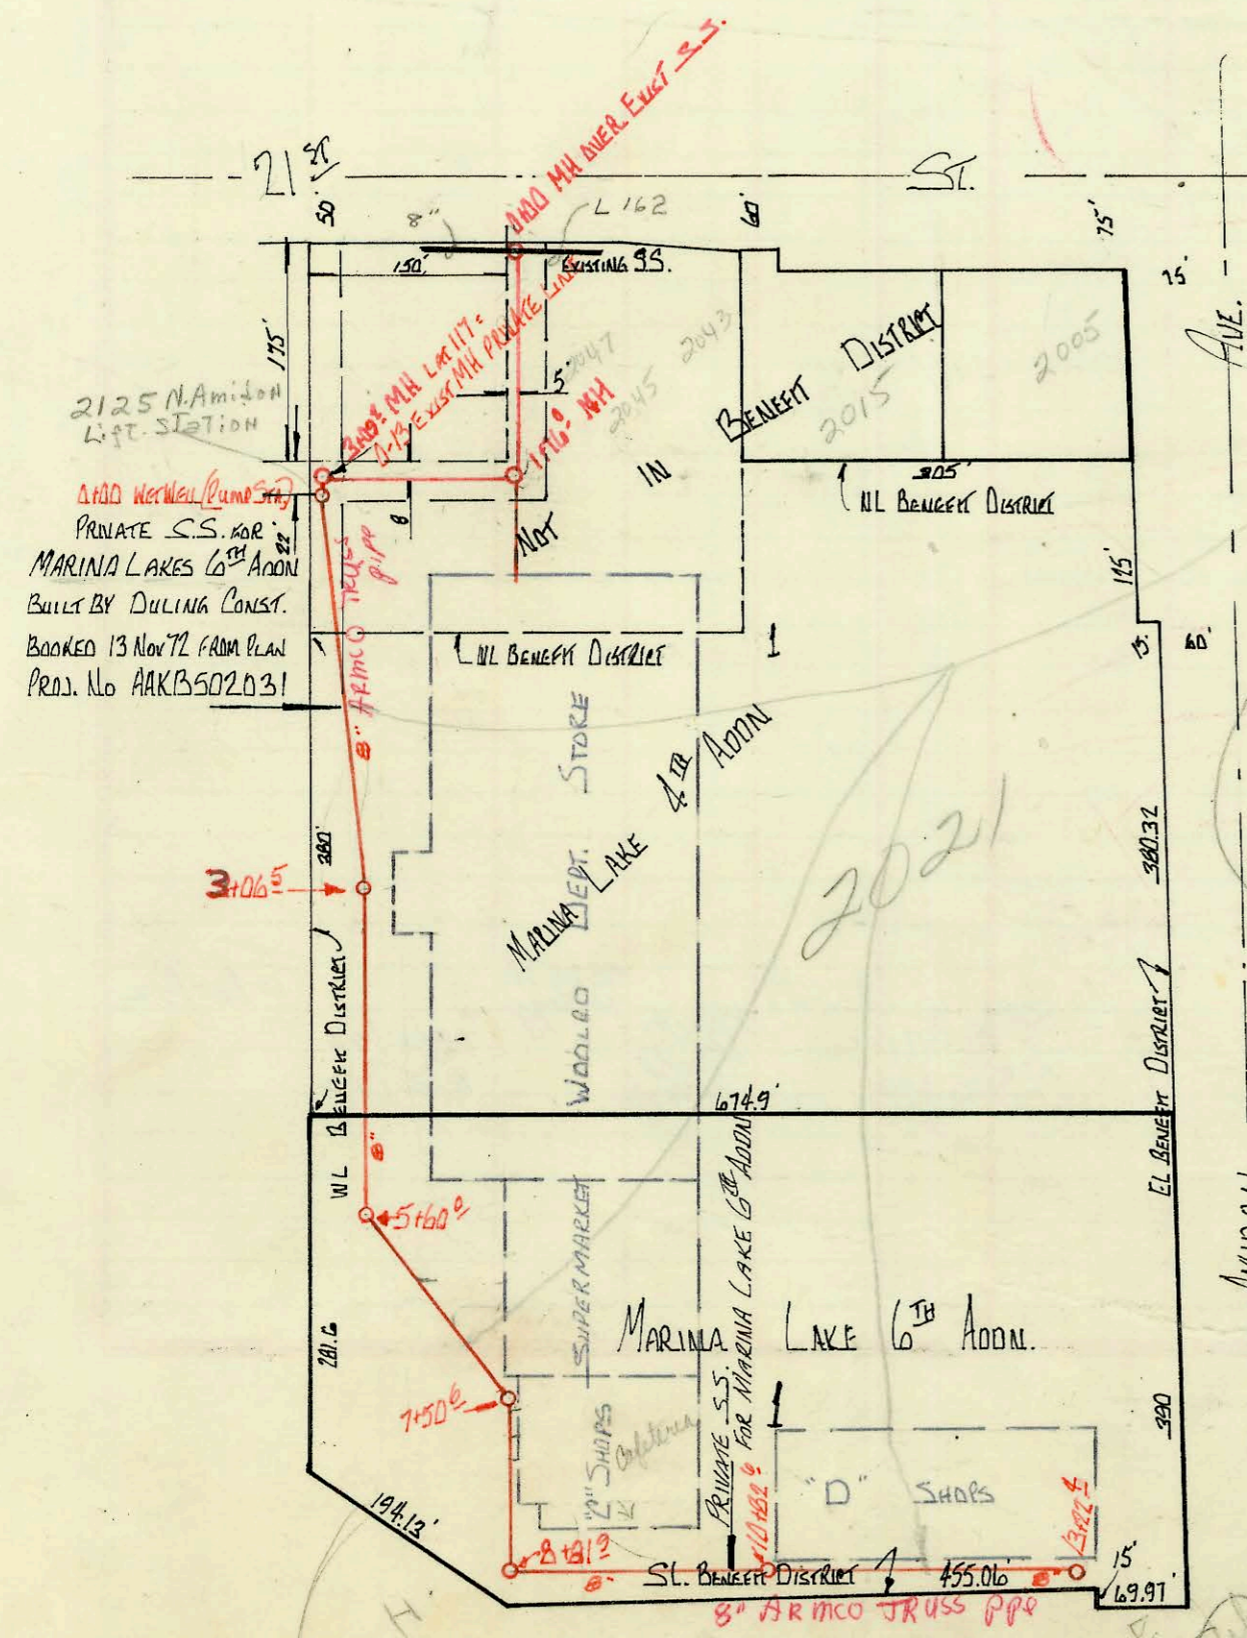

NOTE
This is 8" Armo
TRUSS
See Mr Brewer
Ret. All conn.
3/7/73

LAT 117 SS # 22
BUILT BY MID STATES CONST. CO.
BOOKED 25 SEPT 72 FROM K-89
PROJ. No DBKL571029

ON MAP
Note: line going S. from
Lift station serving Marina Lakes
is privately maint. - Not City
Sewer. Lift station belongs to
City. 5/7/02

no permits for 1900 Bl
Amidon. See DBB

CONSTRUCTION RECORD						SERVICE RECORD						
STATION	ELEVATION		Depth	MANHOLE	4-INCH "Y" BRANCHES		No. of Permit		House Number		DATE OF PERMITS	
	Ground	Grade			North West	South East	North West	South East	North West	South East	North West	South East
WEST WAREHOUSE ADDITION (PRIVATE S.S.)												
LINE 1												
0+00	110.44	97.61	12.8	-1+34.8								
	108.8	98.03	10.8	0+00 EXIST. MH "S" STUB N.								
	109.78	98.00	11.8	-0+11.0								
	108.1	98.23	9.9	0+95.0								
1+00	108.4	98.35	10.0	1+61.8 = 0+100 LINE 2								
2+00					1+71.4		C61216		1960 S. Kessler		5-10-77	
3+00	108.2	98.76	9.4	3+66.4 = 0+100 LINE 3								
4+00												
5+00					5+17.9		13754		1912 S. Kessler		5-13-85	
6+00	109.2	99.42	9.8	6+96.0 = 0+100 LINE 4								
7+00					6+72.7		C61083		1960 S. Kessler		5-20-77	
8+00					7+34.0		5295		1906 S. Kessler		3-5-82	
8+46.0 END LINE WITH FLD ELEV OF 99.72												
LINE 2												
0+00	108.4	102.20	6.2	0+00 = 1+61.8 LINE 1								
	109.1	102.70	6.4	0+48.5 "S" STUB W.			C34935		1902 S. West		9-19-72	
LINE 3												
0+00	108.2	102.6	5.6	0+00 = 3+66.4 LINE 1								
	109.2	103.1	6.1	0+48.4 "S" STUB W.								
LINE 4												
0+00	109.2	103.00	6.2	0+00 = 6+96.0 LINE 1								
	109.5	103.5	6.0	0+48.2 "S" STUB W.								
LAT 117 S.S. #22												
0+00	127.5	118.50	9.0	0+00 OVER EXIST. S.S.								
				Jap (0+98)			C37017		2043-4547 W. 21st		2-2-73	
1+00	127.4	119.32	8.1	1+76.0	M.H. Jap		C37741		2021 Amidon (Wales Store)		3-16-73	
2+00												
3+00	127.5	119.82	7.7	3+09.2								
PRIVATE S.S. FOR MARINA LAKE ADDITION												
0+13	127.5	119.59	7.9	0+13 = 3+09.2 LAT 117								
0+00	127.3	111.83	10.3	0+00 WELLS (PUMP STATION)								
1+00												
2+00					M.H. tap		16812		2021 Amidon		8-7-86	
3+00	122.0	112.25	9.8	3+06.5	M.H. tap		C37739		2021 Amidon (Wales Store)		3-16-73	
4+00												
5+00	119.1	113.35	5.8	5+60.2								
6+00					wire tap		C41893		2021 Amidon (Barnery Store)		10-26-73	
7+00	119.6	114.12	5.5	7+50.6			C44510		2021 Amidon (C. Ship)		4-17-74	
8+00	119.0	114.74	4.3	8+81.2			10442		2021 Amidon		3-9-84	
9+00												
10+00	119.4	115.64	3.8	10+82.2			8672		2021 #126 Amidon		7-8-83	
11+00					10+99.6	12+00.96	20807	5852		1999 Amidon	5-11-82	
12+00												
13+00	119.4	116.60	2.8	13+22.4	M.H. tap		C37740		2021 #118 Amidon (Bldg. D)		3-16-73	

C 37585 - C 37589 - 2021 N. Amidon - Bldg. D - 3-6-73 - Paul Johnson (Central W. Land. Co.)
 Jap C 44507 - 2021 N. Amidon - June Caperton - 4-17-74 - (7+80.6)
 Jap C 44508 " " " " (7+54.6)
 Jap C 44504 " " " " (7+93.6)