



LAT 15, MAIN 4, S.W.1.
 BUILT BY W.B. CARTER CONST. CO.
 BOOKED 14 NOV 72 FROM K-88
 PROJ. NO. DBKL 572025
 PRIVATE
 BUILT BY: PEARSON EXCAVATION CO.
 PROJ. NO. 468-76-245-80584-000-000-008
 BOOKED 1-23-79 FROM PLAN

(W KELLOGG) U.S. HIGHWAY 54

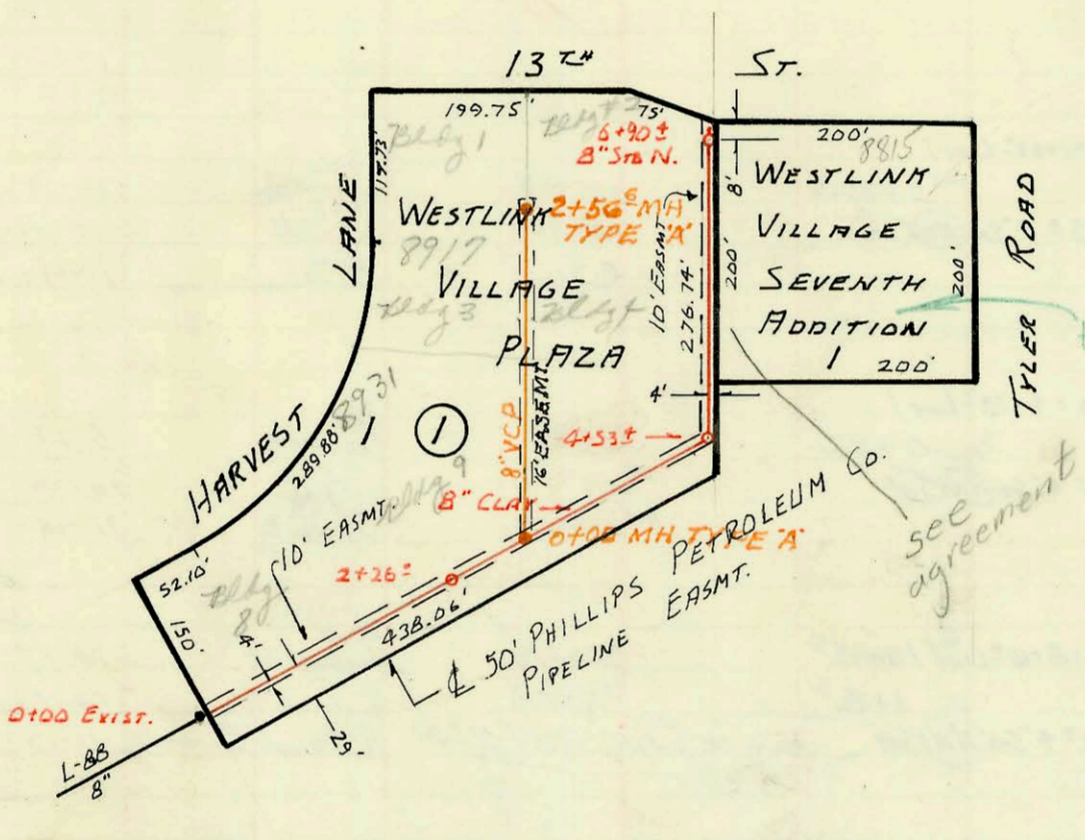

LAT 51 WESTLINK SEWER
 BUILT BY W.B. CARTER CONST. CO.
 BOOKED 14 DEC 72 FROM K-102
 PROJ. NO. DBKL 568087

7169
 4170
 299

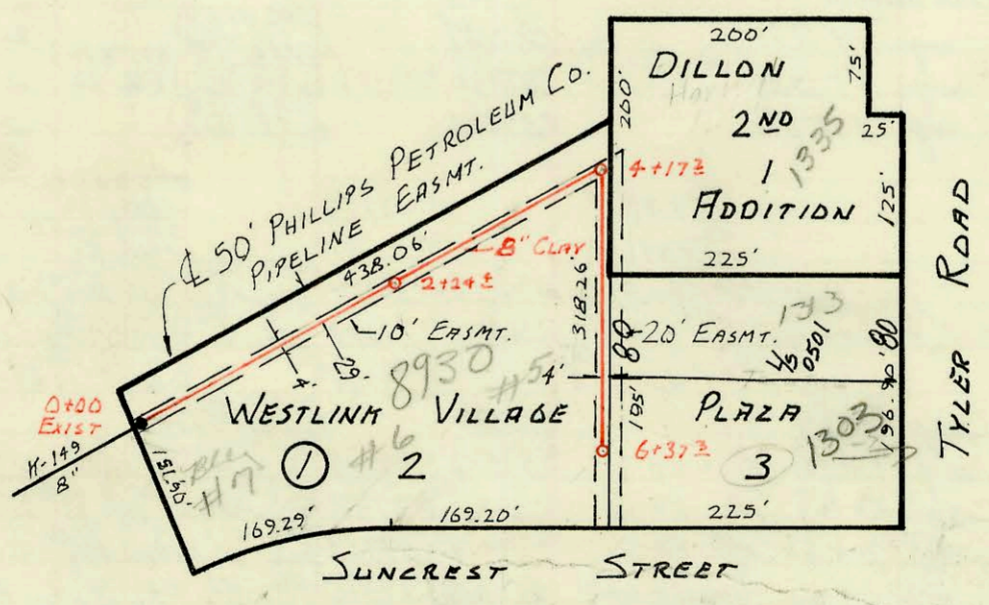

LAT 52, WESTLINK SEWER
 BUILT BY W.B. CARTER CONST. CO.
 BOOKED 14 DEC. 72 FROM K-102
 PROJ. NO. DBKL 569069

SCALE 1"=150'

