



SERVICE RECORD CONSTRUCTION RECORD


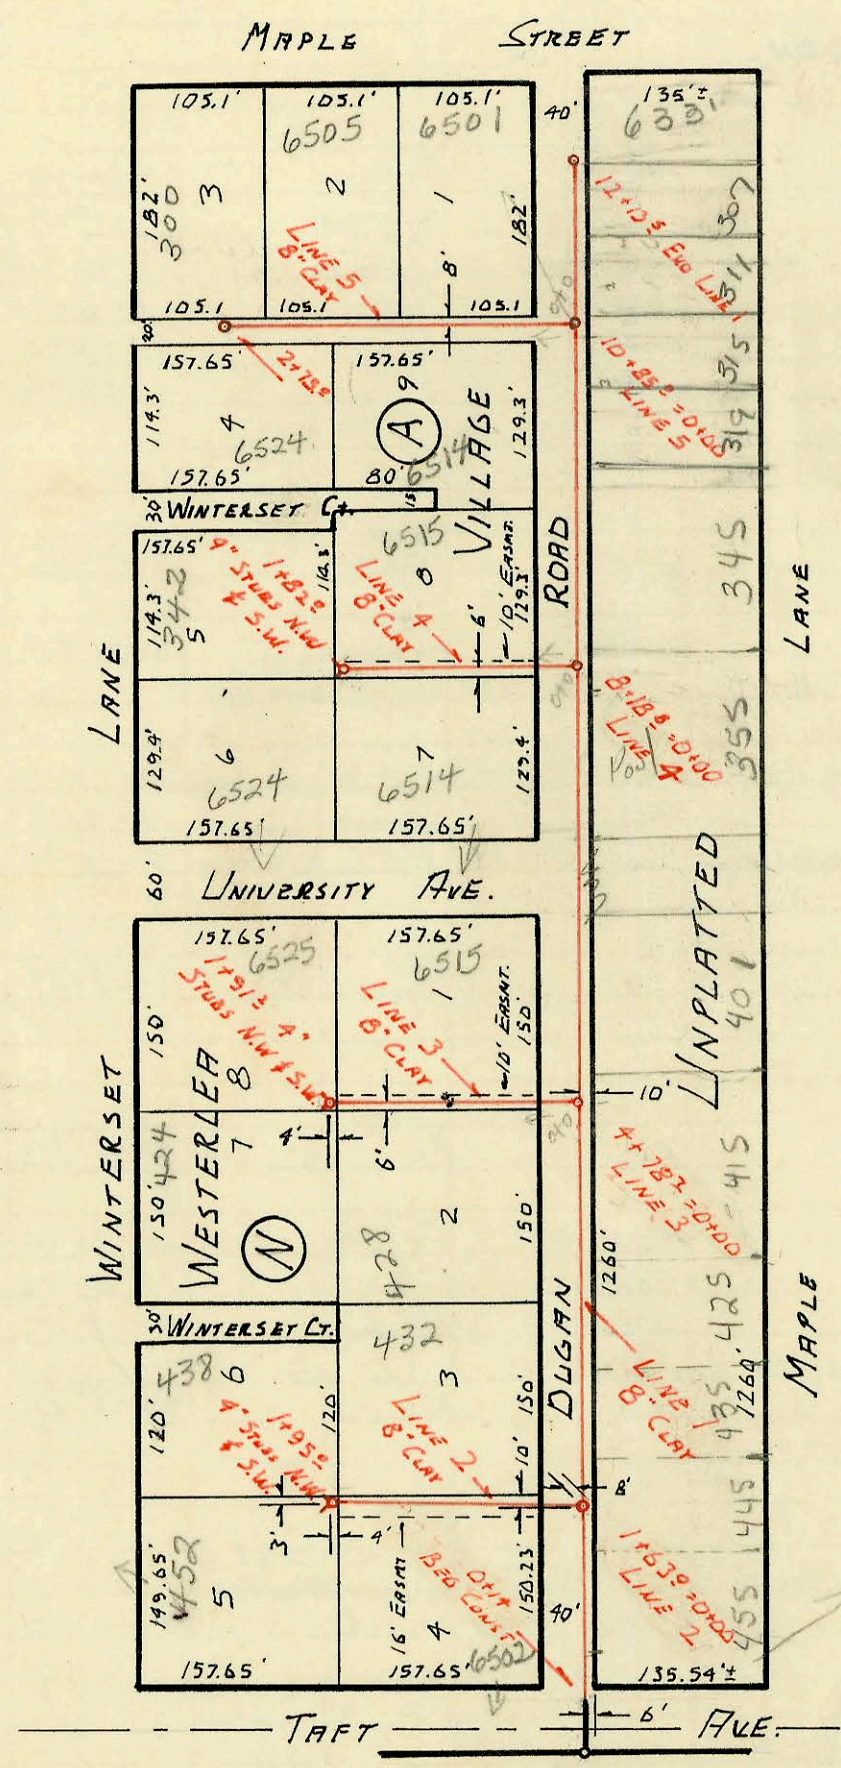


LAT 24 S.W.I.
 BUILT BY UTILITY CONTRACTORS
 BOOKED 1 DEC 72 FROM K-106
 PROD. NO. DBKL569027

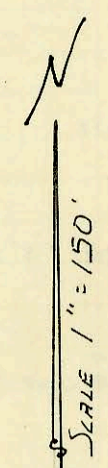

NO CONNECTION
 TO CITY SEWER
 WITHOUT APPROVAL
 FROM A.S.A. WIND

S.S. TO HORIZONS EAST APARTMENTS
 BUILT BY VERN LIPPOLDT CONST. CO.
 BOOKED 15 DEC 72 FROM 1H-75
 PROD. NO. FAKB502049

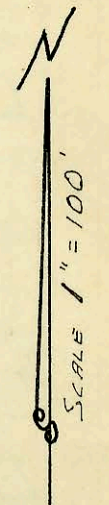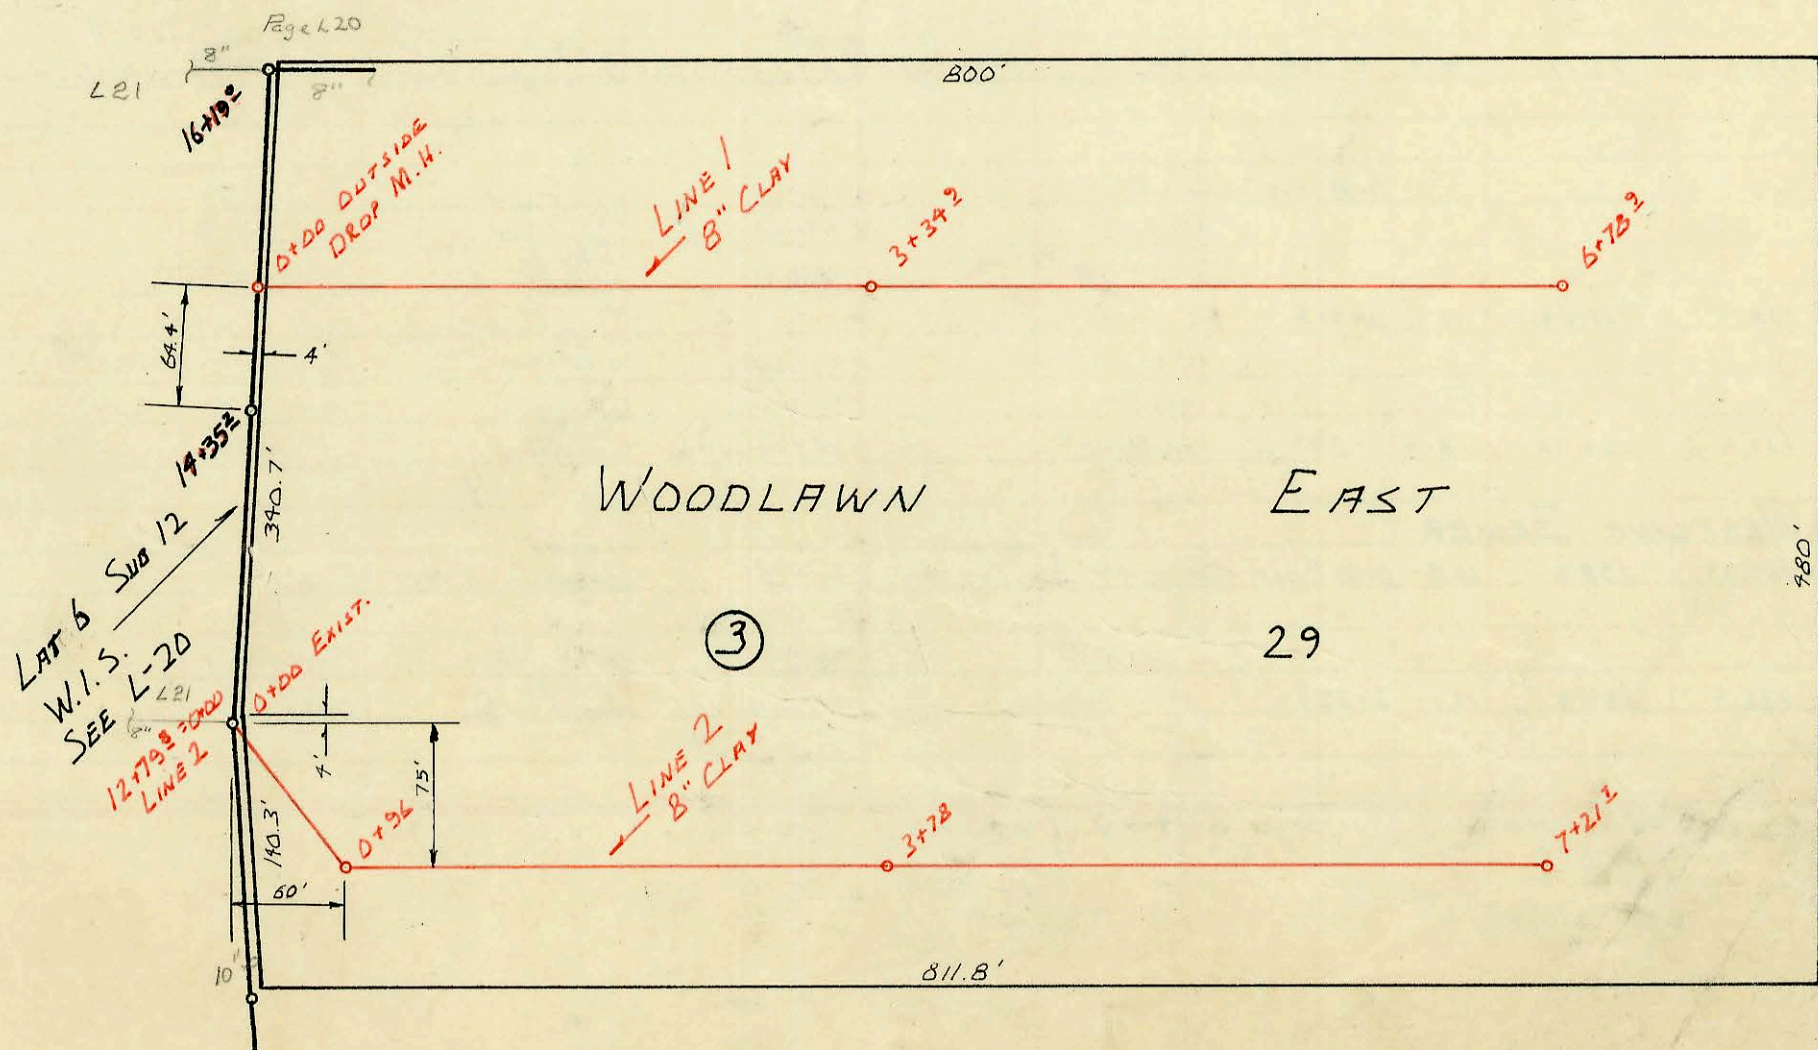

00287-51491 6514 W. Univ. East M.H. - 0'50R - 35 1/4 Fall tied into existing sewer line in front yard
 at (0+100) W. MH

