


✓ SANITARY SEWER WILLO-ESQUE 1ST ADDN.
 (LAT 49 S.W. INTERCEPTOR)
 BUILT BY UTILITY CONTRACTORS
 BOOKED 12 DEC 72 FROM K-87
 PROJ. No. AAKB502048

ON MAP

LAT 56, WESTLINK SEWER
 BUILT BY: W.B. CARTER CONST. CO. INC.
 BOOKED 31 JAN 73 FROM K-100
 PROJ. No. DBKL572054

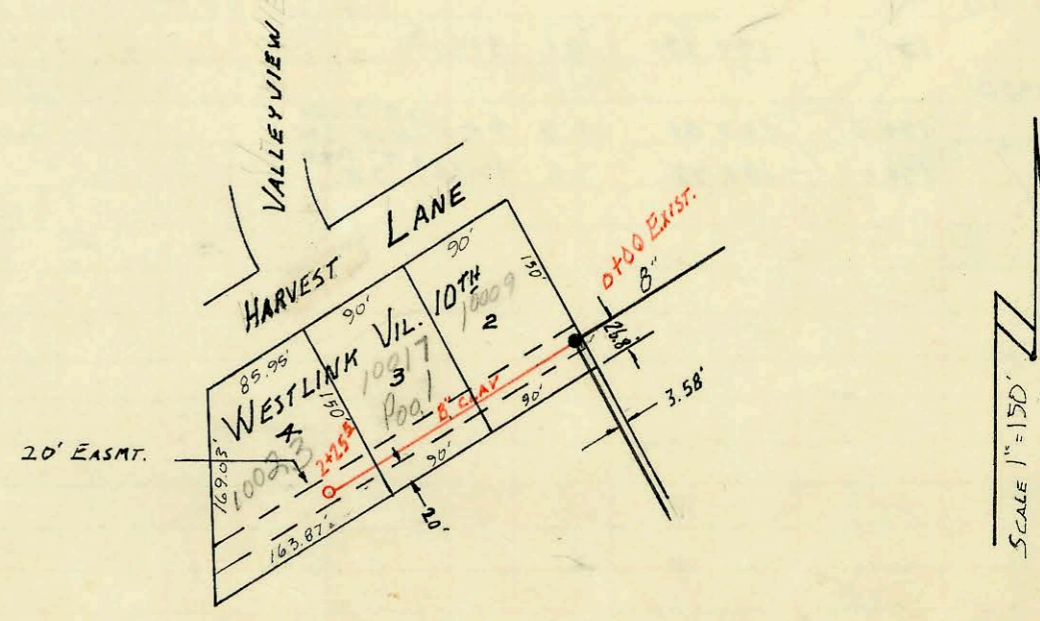

CONSTRUCTION RECORD						SERVICE RECORD						
STATION	ELEVATION		Depth	MANHOLE	4-INCH "Y" BRANCHES		No. of Permit		House Number		DATE OF PERMITS	
	Ground	Grade			North West	South East	North West	South East	North West	South East	North West	South East
LAT 49 S.W. INTERCEPTOR SANITARY SEWER WILLO-ESQUE 1 ST ADDN.												
LINE 1												
0+00												
0+09				Exist. 8" Sub N. & W. Tap	1+59.3		C48398		232 Caymarie			2-14-75
1+00				Tap	2+06.3		C46639		228 Caymarie			9-13-74
2+00				Tap	2+87.0		C46638		224 Caymarie			9-13-74
3+00	129.4	119.00	10.4	3+00 ^o	Tap	3+70.1	C49874		218 Caymarie			6-11-75
4+00					Tap	4+54.0	C49486		208 Caymarie			5-14-75
5+00					Tap	5+55.0	C45485		208 Caymarie			6-27-74
6+00	133.0	122.00	11.0	5+99 ^o								
7+00												
8+00	134.0	123.59	10.41	7+57 ^o 8" Str. N.	Tap	7+76	C38299		200 Caymarie			4-17-73
9+00					Tap	11+18.3	C67956		6705 Loconia Cr.			8-21-78
10+00						Tap	11+19	C50290	201 Willo Esque			7-11-75
11+00	138.7	126.47	12.2	10+32	Tap	10+51.9	C61825	C44491	6704 Loconia	207 Willo Esque	6-30-77	4-17-74
12+00					Tap	11+93.0	C61824		6717 Loconia		6-30-77	
	143.6	129.14	14.5'	12+87 ^o 8" Str. N. M.H. Tap	Tap	11+30.1	C48390	C41887	223 Willo Esque	215 Willo Esque	2-14-75	10-23-75
LINE 2												
0+00				Exist. 0+09 Line 1	0+40.7		C73778		336 Caymarie			8-29-79
1+00												
2+00												
3+00	128.5	118.45	10.1	2+90	Tap	3+46	C36616		6805 Shenice Cl.			1-4-73
4+00												
5+00					Tap	5+04	C35157		6811 Shenice Cl.			10-3-72
5+90	133.5	119.95	13.5	5+90	M.H. Tap		C35156		6819 Shenice Cl.			10-3-72
6+00					Tap	6+44.6	C35155		6827 Shenice Cl.			10-3-72
7+00												
8+00					Tap	7+16.9	C31159	C35154	6837 Shenice Cl.			7-26-78
	133.7	121.36	12.3	8+72 ^o 8" Str. W.								
LINE 3												
0+00				0+00 = 2+90 Line 2	Tap	0+60.6	C45838		231 Caymarie			7-18-74
1+00					Tap	1+39.5	C35481		6800 Shenice Cl.			7-18-75
2+00												
3+00	131.3	121.15	10.1	2+64 ^o	Tap	3+30.9	C41448		217 Caymarie			10-1-73
4+00					Tap	4+46.4	C40263		211 Caymarie			7-25-73
5+00					Tap	5+40.6	C48399		207 Caymarie			2-14-75
	135.6	124.15	11.4	5+52 ^o	M.H. Tap		C40262		201 Caymarie			7-25-73
LINE 4												
0+00				0+00 = 2+64 ^o Line 3	Tap	1+24.4	C35160		6806 Shenice Cl.			10-8-72
1+00												
2+00												
3+00												
4+00	135.1	124.35	10.7	3+02 ^o SE. 4" Str. SW. 4" Str. SE.	Tap	4+19.8	C35162	C35161	6820 Shenice Cl.	6812 Shenice Cl.	10-3-72	10-3-72
	135.9	126.17	9.7	4+72 ^o 4" Str. N.W. M.H. TAP	Tap	4+19.8	C35163	C35158	6828 Shenice Cl.	6738 Shenice Cl.	2-22-76	10-3-72
LINE 5												
0+00				0+00 = 5+52 ^o Line 3	Tap	0+53.5	C44496		210 Willo Esque			4-17-74
1+00					Tap	1+51	C40261		206 Willo Esque			7-25-73
2+00					Tap	2+38.2	C42071		224 Willo Esque			11-6-73
3+00	138.7	127.05	11.7	2+81 ^o	Tap	3+74.5	C35460		240 Willo Esque			10-18-72
4+00					Tap	4+44.1	C35462		248 Willo Esque			10-18-72
	137.6	129.25	8.4	4+89 ^o	M.H. TAP		C35461		256 Willo Esque			10-18-72
LAT 56 WESTLINK SEWER												
0+00	169.35	158.6	10.8	0+00 Exist	Tap	0+41.5	C38923		10009 Shenice Cl.			5-11-73
1+00												
2+00	172.6	159.5	13.1	2+25 ^o	Tap	1+18.2	C38924		10013 Shenice Cl.			5-11-73
					M.H. Tap		C37260		10023 Shenice Cl.			2-16-73

Tap C45337 - 204 Caymarie (Thompson) 6-14-74 (6+58.6)
 Tap C45338 - 203 " " " " (2+41.8)
 Tap 45342 - 227 " " " " (1+96.2)
 Tap C45341 - 232 Willo Esque " " " " (3+19.6)