


LAT 23 MAIN 21 S.S. No. 22
 BUILT BY UTILITY CONTRACTORS INC.
 BOOKED 3 JAN 73 FROM S.S. J.K. #9
 PROJ. NO. DBKL571015




ON MAP

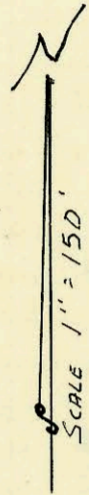

SANITARY SEWER RELOCATION
 LIGHTNER ADDITION
 BUILT BY UTILITY CONTRACTORS INC.
 BOOKED 8 JAN 73 FROM PLAN.
 PROJ. NO. AAKB502021

1917
 1187
 730

ON MAP

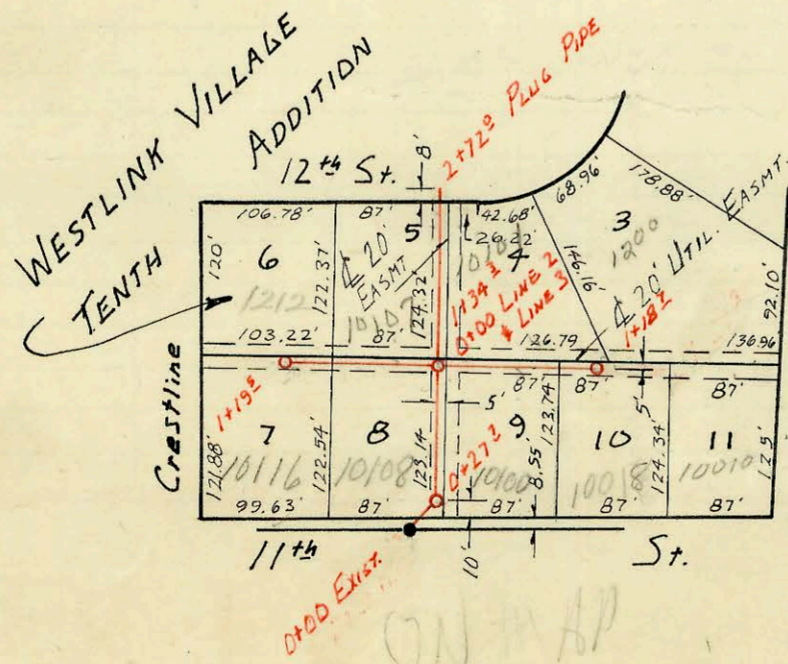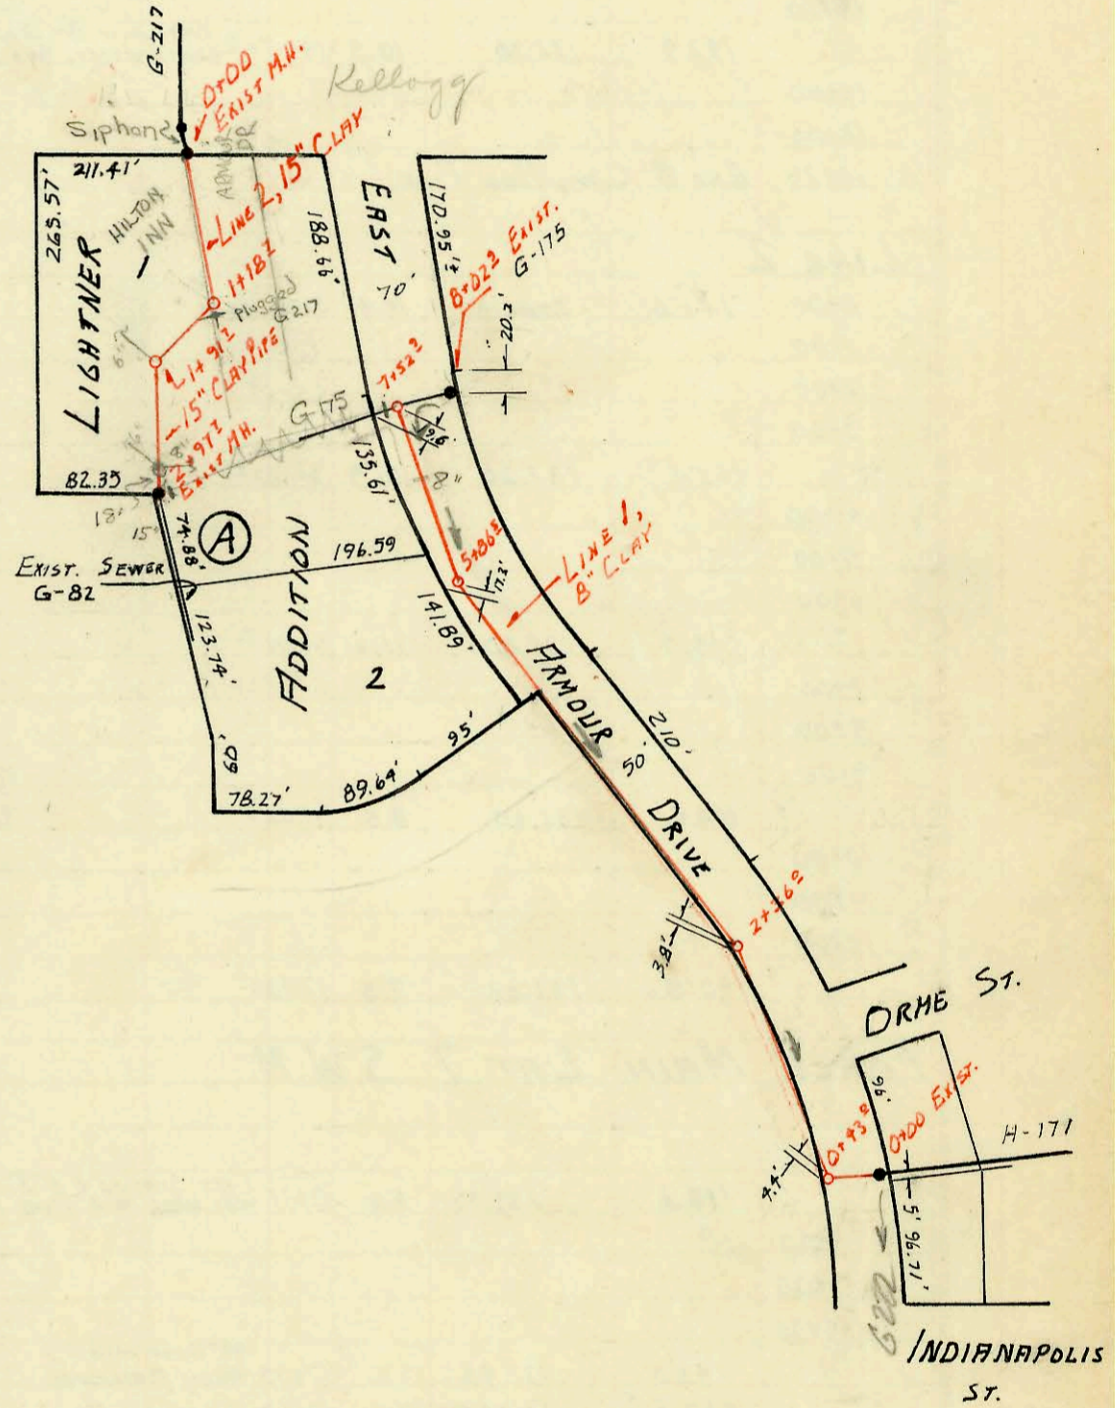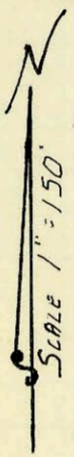

LAT 4 MAIN 2 WESTLINK SEWER
 BUILT BY: UTILITY CONT. INC.
 BOOKED 2 FEB 73 FROM K-110
 PROJ. NO. DBKL572052

ON MAP



CONSTRUCTION RECORD							SERVICE RECORD					
STATION	ELEVATION		Depth	MANHOLE	4-INCH "Y" BRANCHES		No. of Permit		House Number		DATE OF PERMITS	
	Ground	Grade			North West	South East	North West	South East	North West	South East	North West	South East
LAT 23 MAIN 21 SS 22												
0+00				0+00 EXIST								
1+28	BEG. CONST.											
2+00	132.9	128.58	4.3	2+02 ^B	top 2+43		C38956		3909	1562	5-14-73	
3+00					top 2+91 ^B		C38954		3910	1550		5-14-73
4+00	133.8	128.95	4.8	4+54 ^E	top 3+06 ^B		C40987		3920	1542	8-30-73	9-5-73
5+00					top 3+94 ^B		C40988		3930	1542	8-30-73	9-5-73
6+00					top 4+59 ^B		C44300		3930	1532	4-4-74	9-5-73
7+00	131.2	129.27	1.9'	6+56.6	top 6+03 ^B					3940		11-8-73
8+00	133.5	129.67	3.8	8+10 ^E	top 8+04.3		C61122			3950		5-12-77
SANITARY SEWER, LIGHTNER ADDITION												
LINE 1												
0+00	145.2	140.46	4.7	0+00 EXIST.								
	145.0	140.67	4.3	0+43 ^E								
1+00												
2+00	145.8	141.33	4.5	2+36 ^E								
3+00												
4+00												
5+00												
6+00	147.7	142.47	5.2	5+86 ^E								
7+00												
8+00	149.4	143.00	6.4	7+52 ^B								
				8+02 ^B EXIST.								
LINE 2												
0+00				0+00 EXIST. MH.								
1+00	151.6	142.80	8.8'	1+18 ^Z								
	151.8	142.54	9.3	1+91 ^Z	6" M.H. J.P.		C35874		7335E		11-8-72	
2+00				2+80.7			C35875		7335E		11-8-72	
	152.1	142.3	9.8	2+97 ^Z EXIST.			C37035		7335E		2-5-73	
LAT 4 MAIN 2 WESTLINK SEWER												
LINE 1												
0+00	153.9	140.60	13.3	0+00 EXIST								
	153.6	140.81	12.8	0+27 ^Z								
1+00	154.2	141.26	12.9	1+34 ^Z								
2+00												
2+72 ^Z	154.0	141.71	12.3	END PUGGED								
LINE 2												
0+00				0+00=1+34 ^Z LINE 1	top 0+29.7		C37282		10100	W. 1174		2-20-73
1+00	154.8	146.20	8.6	1+18 ^Z	top 1+11.4		C43390		10018	W. 1174		2-5-74
LINE 3												
0+00				0+00=1+34 ^Z LINE 1	top 0+62.72 ^Z (0+28.5)		C37258		10106	W. 1174		2-16-73
1+00	152.7	144.48	8.2	1+19 ^Z	top 0+45.2 ^Z (1+13.4)		C40254		10107	W. 1174		7-25-73
					top 1+02.9		C37287		1212	W. 1174		2-20-73

C47181-7411 E. Kellogg = 10/29/74 - Paul Johnson
 C47182-7411 E. Kellogg = 10/29/74 - Paul Johnson
 S.O. C42545-7335 E. Kellogg-12-3-73 (sealed in M.H. 2+97.7)
 S.O. C42546- " " " " " "