
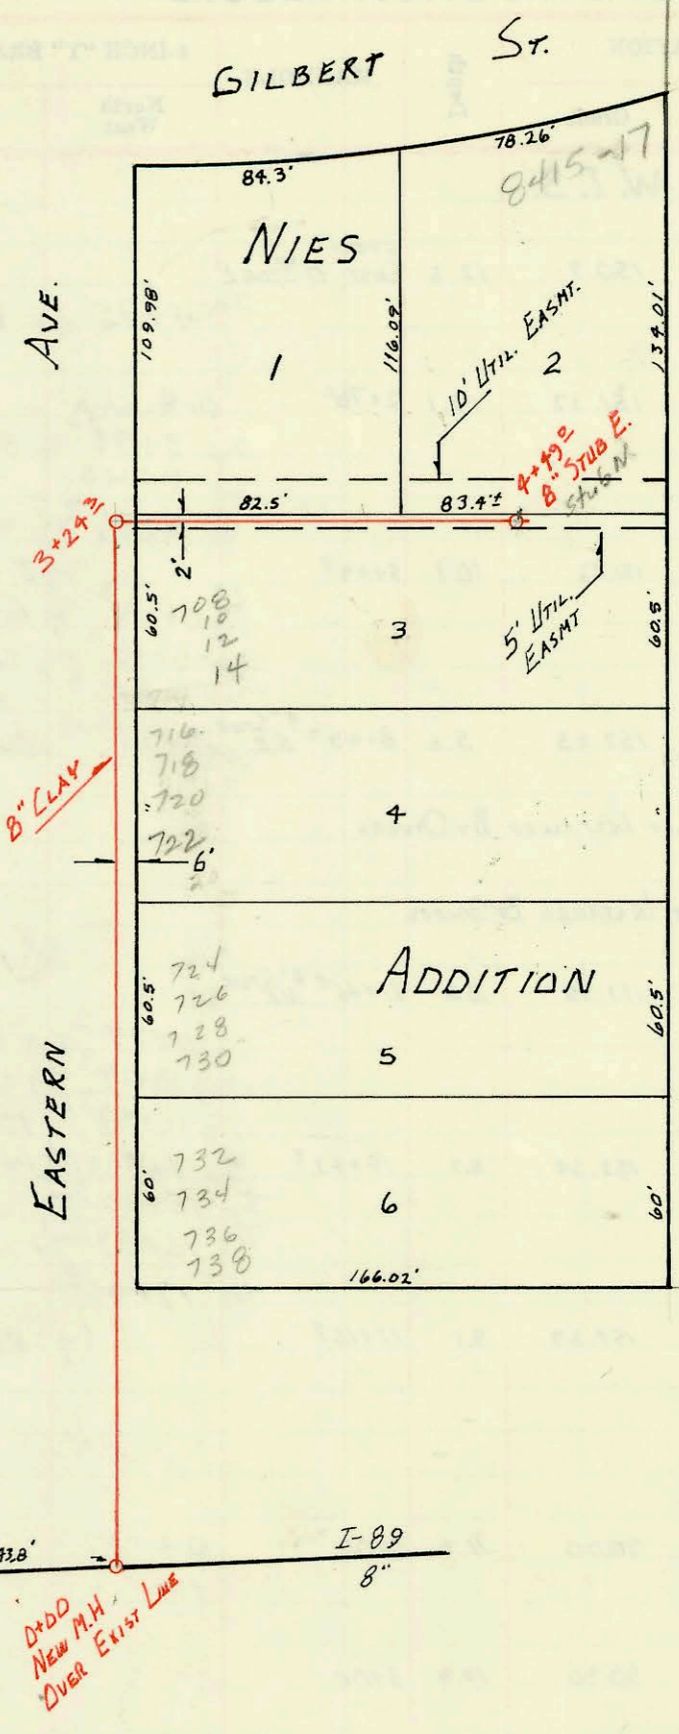



SERVICE RECORD CONSTRUCTION RECORD

LAT 52 W.I.S.
BUILT BY: UTILITY CONTRACTORS
BOOKED 20 MARCH 73 FROM I.H. - 79
PROJECT NO. DBKL 572042

ON MAP

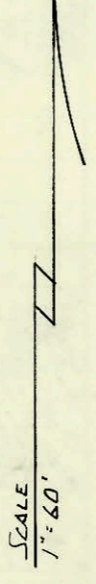


8425 Gilbert
oil septic

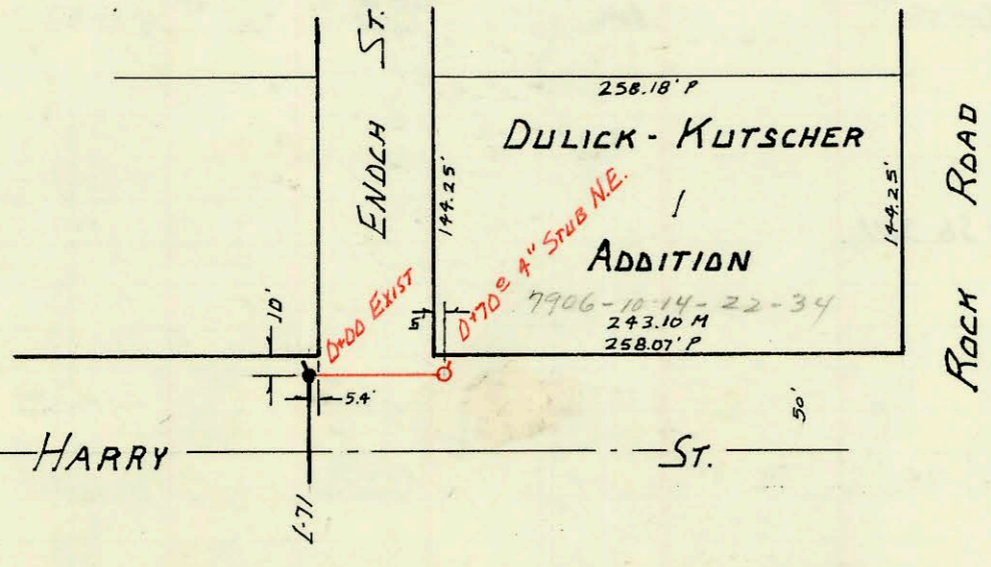

LAT 8 MAIN 16 W.I.S.
BUILT BY: UTILITY CONTRACTORS
BOOKED 21 MARCH 73 FROM 271-Y
PROJ. NO. DBKL 572077
WAR INDUSTRIES S.S.

ON MAP

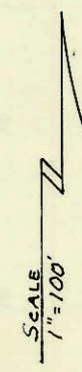

CONSTRUCTION RECORD

SERVICE RECORD

STATION	ELEVATION		Depth	MANHOLE	4-INCH "Y" BRANCHES		No. of Permit		House Number		DATE OF PERMITS	
	Ground	Grade			North West	South East	North West	South East	North West	South East	North West	South East
LINE 6												
0+00	94.8	88.94	5.9	0+00-6+98° LINE 3								
1+00						0+68.5		C42408	C42409	Lot 153	Lot 12A	11-26-73
2+00	95.8	89.29	6.5	1+75°								
3+00						2+52°		C37827	C43859	Lot 133	Lot 13A	3/21/73
4+00	95.6	89.67	5.9	3+65°								
5+00						4+99°		C37501		(Wash. House) 2206 N. Mrs. Arthur		2-28-73
6+00	95.4	90.04	5.4	5+99°								
7+00						7+28°		C41651		Lot 41		10-11-73
						+59°		C41653		Lot 55		10-11-73
								C41654		Lot 56		10-11-73
								C41652		Lot 42		10-11-73
8+00	95.6	90.60	5.0	7+75° 8" STUB S. S. E.		8+59°		C41039	C38914	Lot 53	Lot 24	9-5-73 5-10-73
								C41040	C38915	Lot 54	Lot 23	9-5-73 5-10-73
9+00								C38133		Lot 43		4-9-73
								C38134	C50377	Lot 44	Lot 11	4-9-73 7-17-75
								C38135	C50378	Lot 22	Lot 12	4-9-73 7-17-75
10+00								C38148		Lot 21		4-9-73
	95.6	91.09	4.5	10+23°				C37498		Lot 19		2-28-73
								C39732	C37492	Lot 45	Lot 20	6-27-73 2-28-73
								C39733	C37495	Lot 46	Lot 13	6-27-73 2-28-73
11+00								C39734	C37496	Lot 51	Lot 14	6-27-73 2-28-73
12+00								C39735	C41643	Lot 52	Lot 17	6-27-73 10-11-73
								C38139	C14644	Lot 48	Lot 18	4-9-73 10-11-73
	95.8	91.91	3.9	12+26° 4" Stub No.				C38140	C14645	Lot 47	Lot 15	4-9-73 10-11-73
LINE 7												
0+00	95.6	89.67	5.9	0+00-3+65° LINE 6				C38130	C14646	Lot 50	Lot 16	4-9-73 10-11-73
								C38129		Lot 49		4-9-73
								C38903	C38920	Lot 114	Lot 93	5-10-73 5-10-73
1+00								C38904	C38921	Lot 115	Lot 94	5-10-73 5-10-73
								38905	C39742	Lot 133	Lot 75	5-10-73
								38906	C39743	Lot 132	Lot 76	5-10-73
2+00								C38907	C42114	Lot 118	Lot 122	5-10-73 11-7-73
								C38908		Lot 119		5-10-73
	95.5	90.27	5.2	2+45°				C38909	C42398	Lot 128	Lot 90	5-10-73 11-26-73
								C38910	C42397	Lot 129	Lot 89	5-10-73 11-26-73
									C42701		Lot 79	12-12-73
3+00								C38131	C42700	Lot 126	Lot 80	4-9-73 12-12-73
								C38132	C39728	Lot 127	Lot 87	4-9-73 6-27-73
								C38136	C39729	Lot 120	Lot 88	4-9-73 6-27-73
4+00								C38137	C42103	Lot 121	Lot 122	4-9-73 11-7-73
	95.4	91.13	4.3	4+59° 6" STUB S. 4" STUB N.				C38141		Lot 85		4/9/73
								C38142		Lot 86		4/9/73
								C42104		Lot 123		11-7-73
								C42106	C42105	Lot 125	Lot 124	11-7-73 11-7-73
0+00	143.4	135.57	7.8	0+00				C37936		732-37-36-38 Eastern		3-27-73
1+00								C37935		734-26-28-30 Eastern		3-27-73
2+00								C38236		716-13-24 Eastern		
3+00												
4+00	148.77	136.87	11.9	3+24°								
	150.3	137.47	12.9	4+49°				C37858	C39862	8415-17 E Gilbert Eastern		3-22-73 7-5-73
								C38063		8415-17 E Gilbert Eastern		4-4-73
LAT 52 W.I.S.												
LAT 8 MAIN 16 WAR INDUSTRIES SEWER												
0+00	149.13	140.60	8.5	0+00 Exist.								
	147.04	140.88	6.1	0+70° 4" STUB NE.				C36103		7906-10-14-22-34 E. Harry		11-27-72

C42111 - Lot 116 - 11-7-73 - Wye 1+91
 C42112 - Lot 117 - " " "
 C42113 - Lot 131 " " "
 C45111 - Lot 91 - 6-4-74 - Wye 1+77.5
 C45112 - " 92 - " " "
 C45113 - " 93 - " " "
 C45114 - " 94 - " " "