



Must have drop slyp on existing houses & by Banks on me houses M-185A

SANITARY SEWER
REPLAT OF LAWN
TERRACE
AND KRUEGER'S ADDN.
BOOKED 5 MARCH 73
FROM SEWER WYE MAP

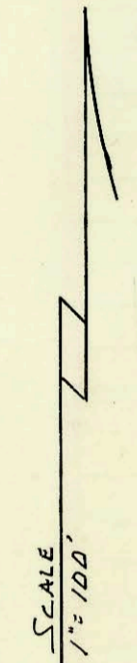

SEE PAGE M-198

ON MAP

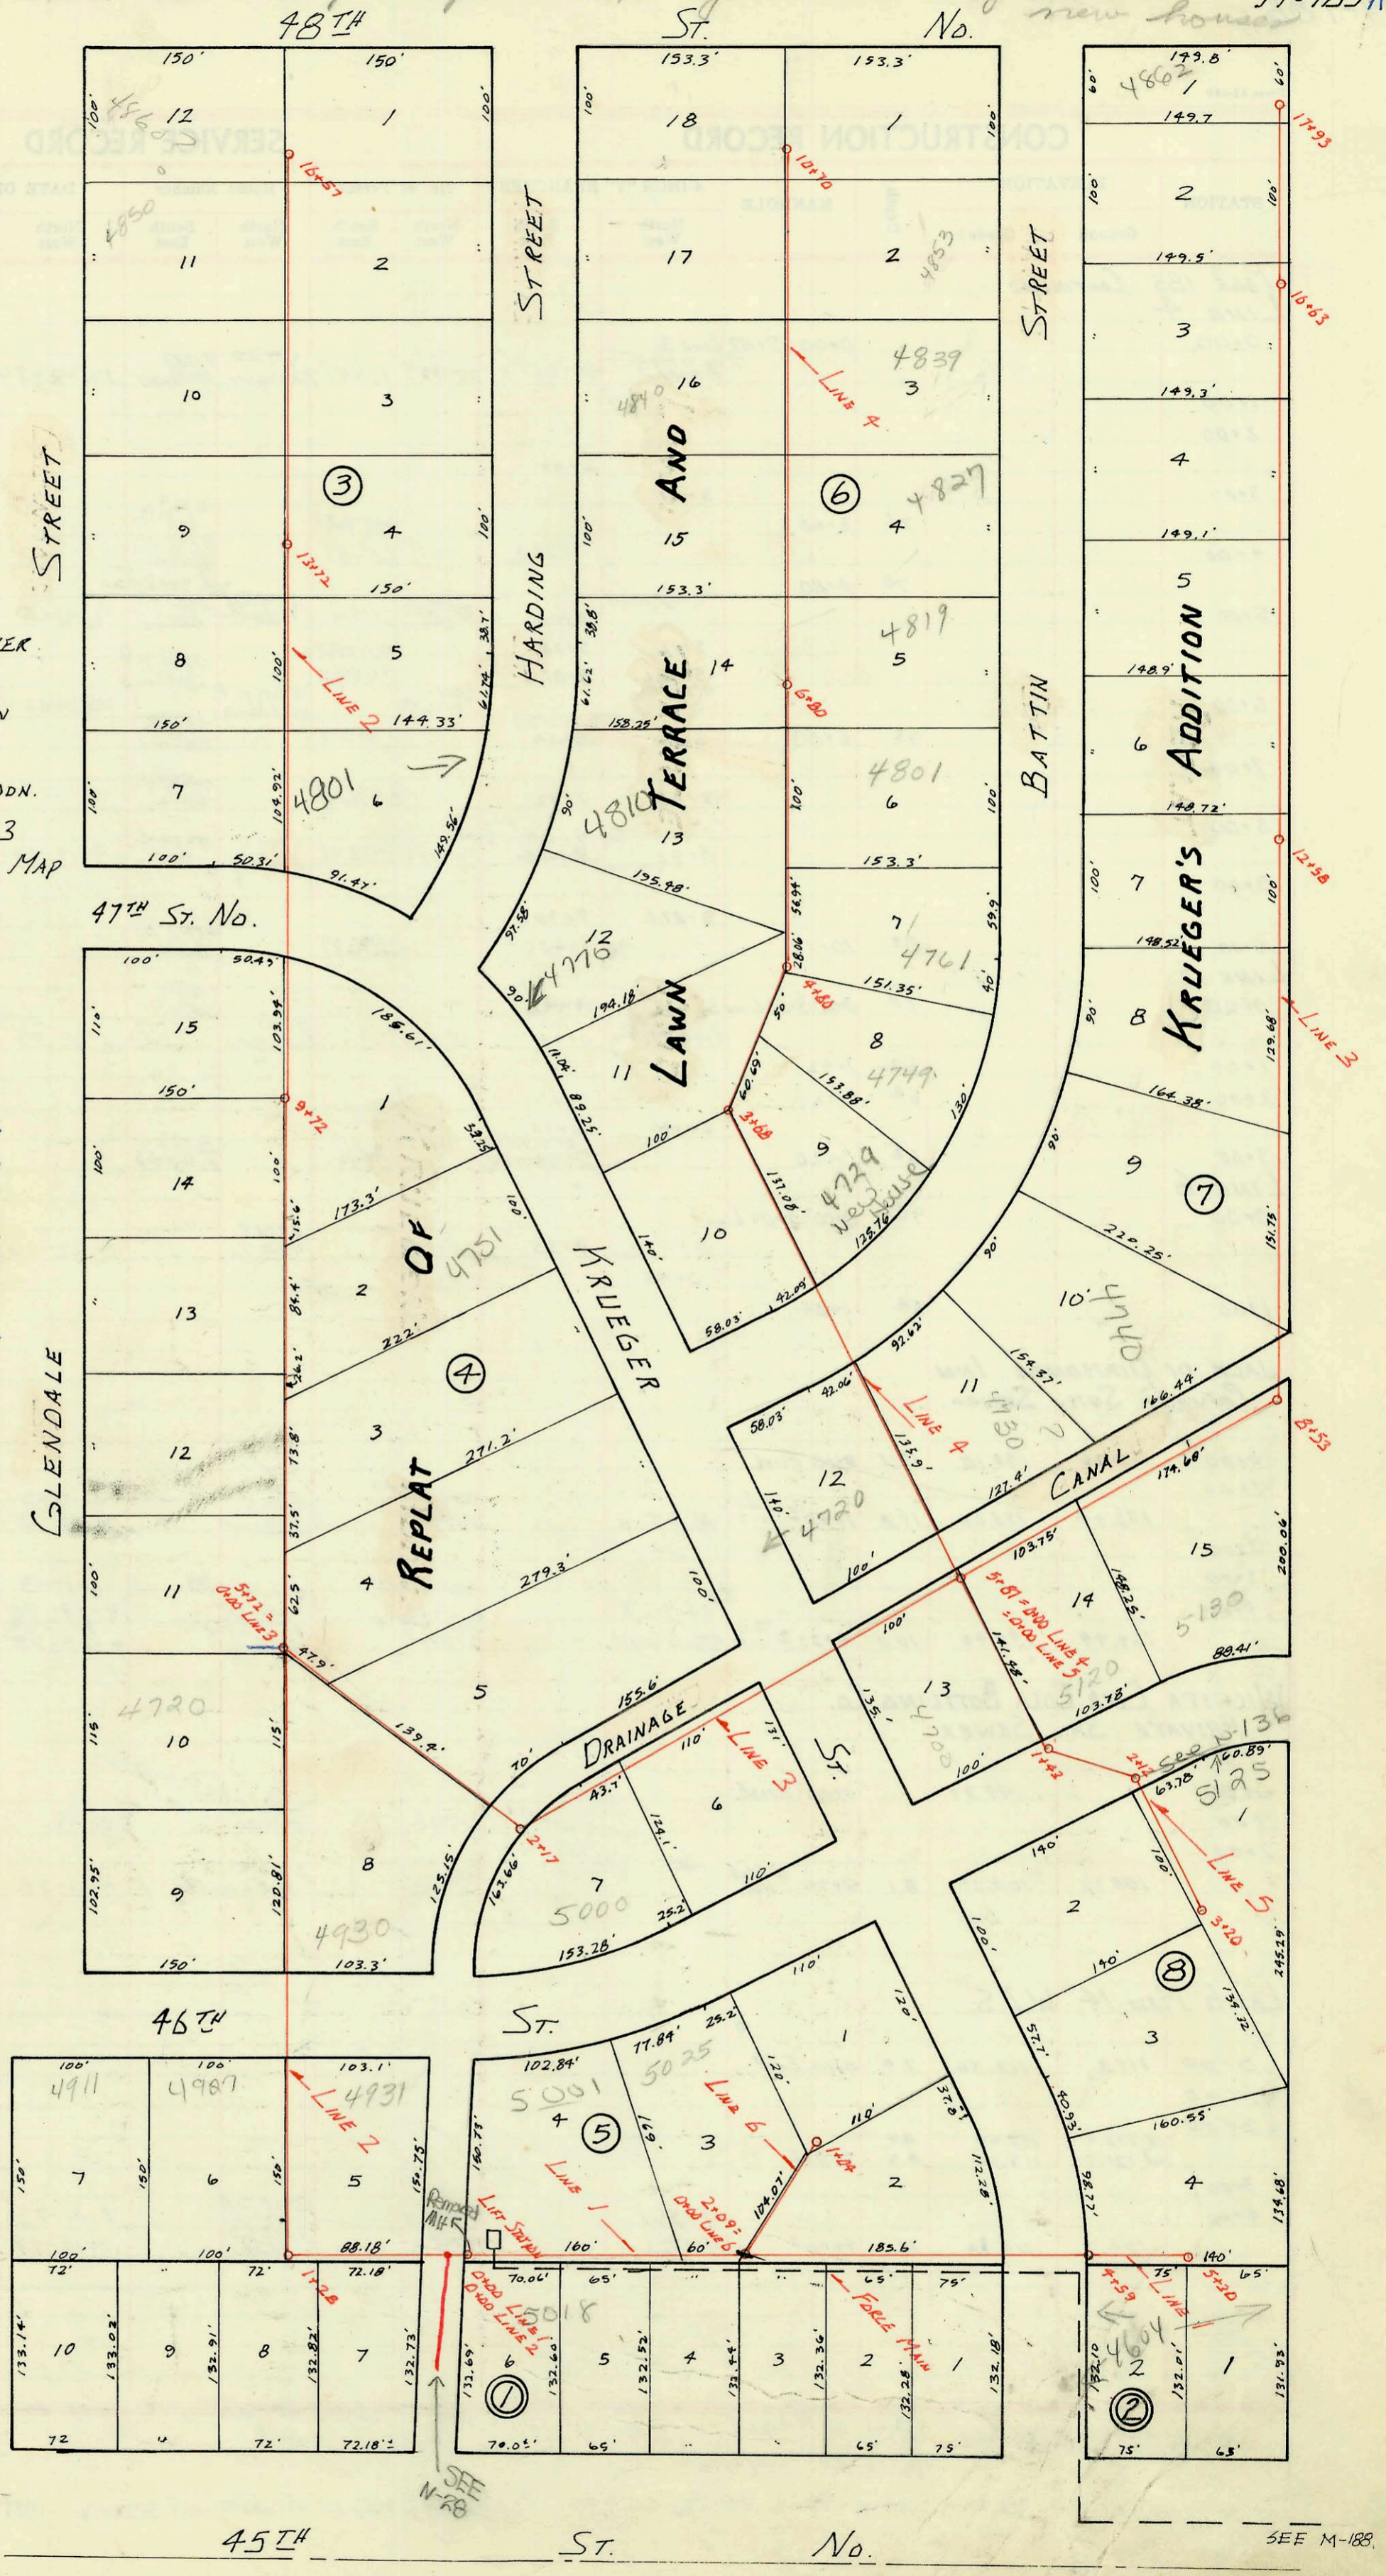

45TH ST.

ST.

No.

SEE M-188

CONSTRUCTION RECORD						SERVICE RECORD						
STATION	ELEVATION		Depth	MANHOLE	4-INCH "Y" BRANCHES		No. of Permit		House Number		DATE OF PERMITS	
	Ground	Grade			North West	South East	North West	South East	North West	South East	North West	South East
S.S. for REPLAT OF LAWN TERRACE AND KRUEGER'S ADDN.												
LINE 1												
0+00				0+00 ← MH TAP	0+16		19544		5018 E 45 N		11/9/87	
					0+50							
1+00					0+72							
					1+44							
					1+73							
2+00					2+03							
			9'	2+09								
					2+71							
3+00					3+34							
4+00			12'	4+59 4" Srv S								
5+00					5+26	5+29						
			12'	5+30								
LINE 2												
0+00				0+00								
					0+50	0+53						
1+00					0+77	0+77 TAP	58220	C58730	4931 E 46th N		11-18-76	11-8-76
			10'	1+28	1+63 STA 1+52	1+28	19038		4987 E 46th N		9-10-87	
2+00												
3+00					3+82	4+00		C50148	4930 E 46th N		7-2-75	
4+00					5+32	4+24	043203		4720 7th St		1-29-74	
5+00					5+58							
			9'	5+72								
6+00					6+00							
					6+98	6+63						
7+00												
					7+95	7+68						
8+00						8+82						
9+00					9+00							
			12'	9+72								
10+00												
11+00					11+78	11+76						
12+00					12+80	12+82						
13+00					13+67	13+65						
			12'	13+72								
14+00												
					14+63	14+72						
15+00					15+49	15+62						
16+00			9'	16+57								
LINE 3												
0+00			10'	0+00 = 5+72 LINE 2								
1+00					0+74							
2+00												
			6'	2+17		2+31		C50149	5000 E 46th N		7-2-75	
3+00						3+45						
4+00												
5+00					5+48.0%	5+05		10304	4700 4th St		7-23-88	
			6'	5+87								
6+00					6+19			C58786	5120 E 46th N		11-23-76	
7+00						7+17 7+53.8		58785	5130 E 46th N		11-23-76	
8+00												
			5'	8+53	8+91.0		24220		4700 E 46th N		11-2-89	
9+00					9+03							
10+00												
11+00					11+21							
12+00					12+04							
			9'	12+58								
13+00					13+04							
14+00					14+11							
15+00					15+10							
16+00					16+07							
			9'	16+53	16+85							
17+00												
					17+93	17+82	18972		4862 W 46th N		8/3/87	

CONTINUED PAGE 186

#3269 2-18-99 5001 = 46th - Boardman