


Need plumbing inspection slip for old, plg. permits for new houses (and legal descriptions)

SANITARY SEWER FOR PEARSON'S FIRST ADDN. BOOKED 8 MARCH 73 FROM SEWER WYE MAP

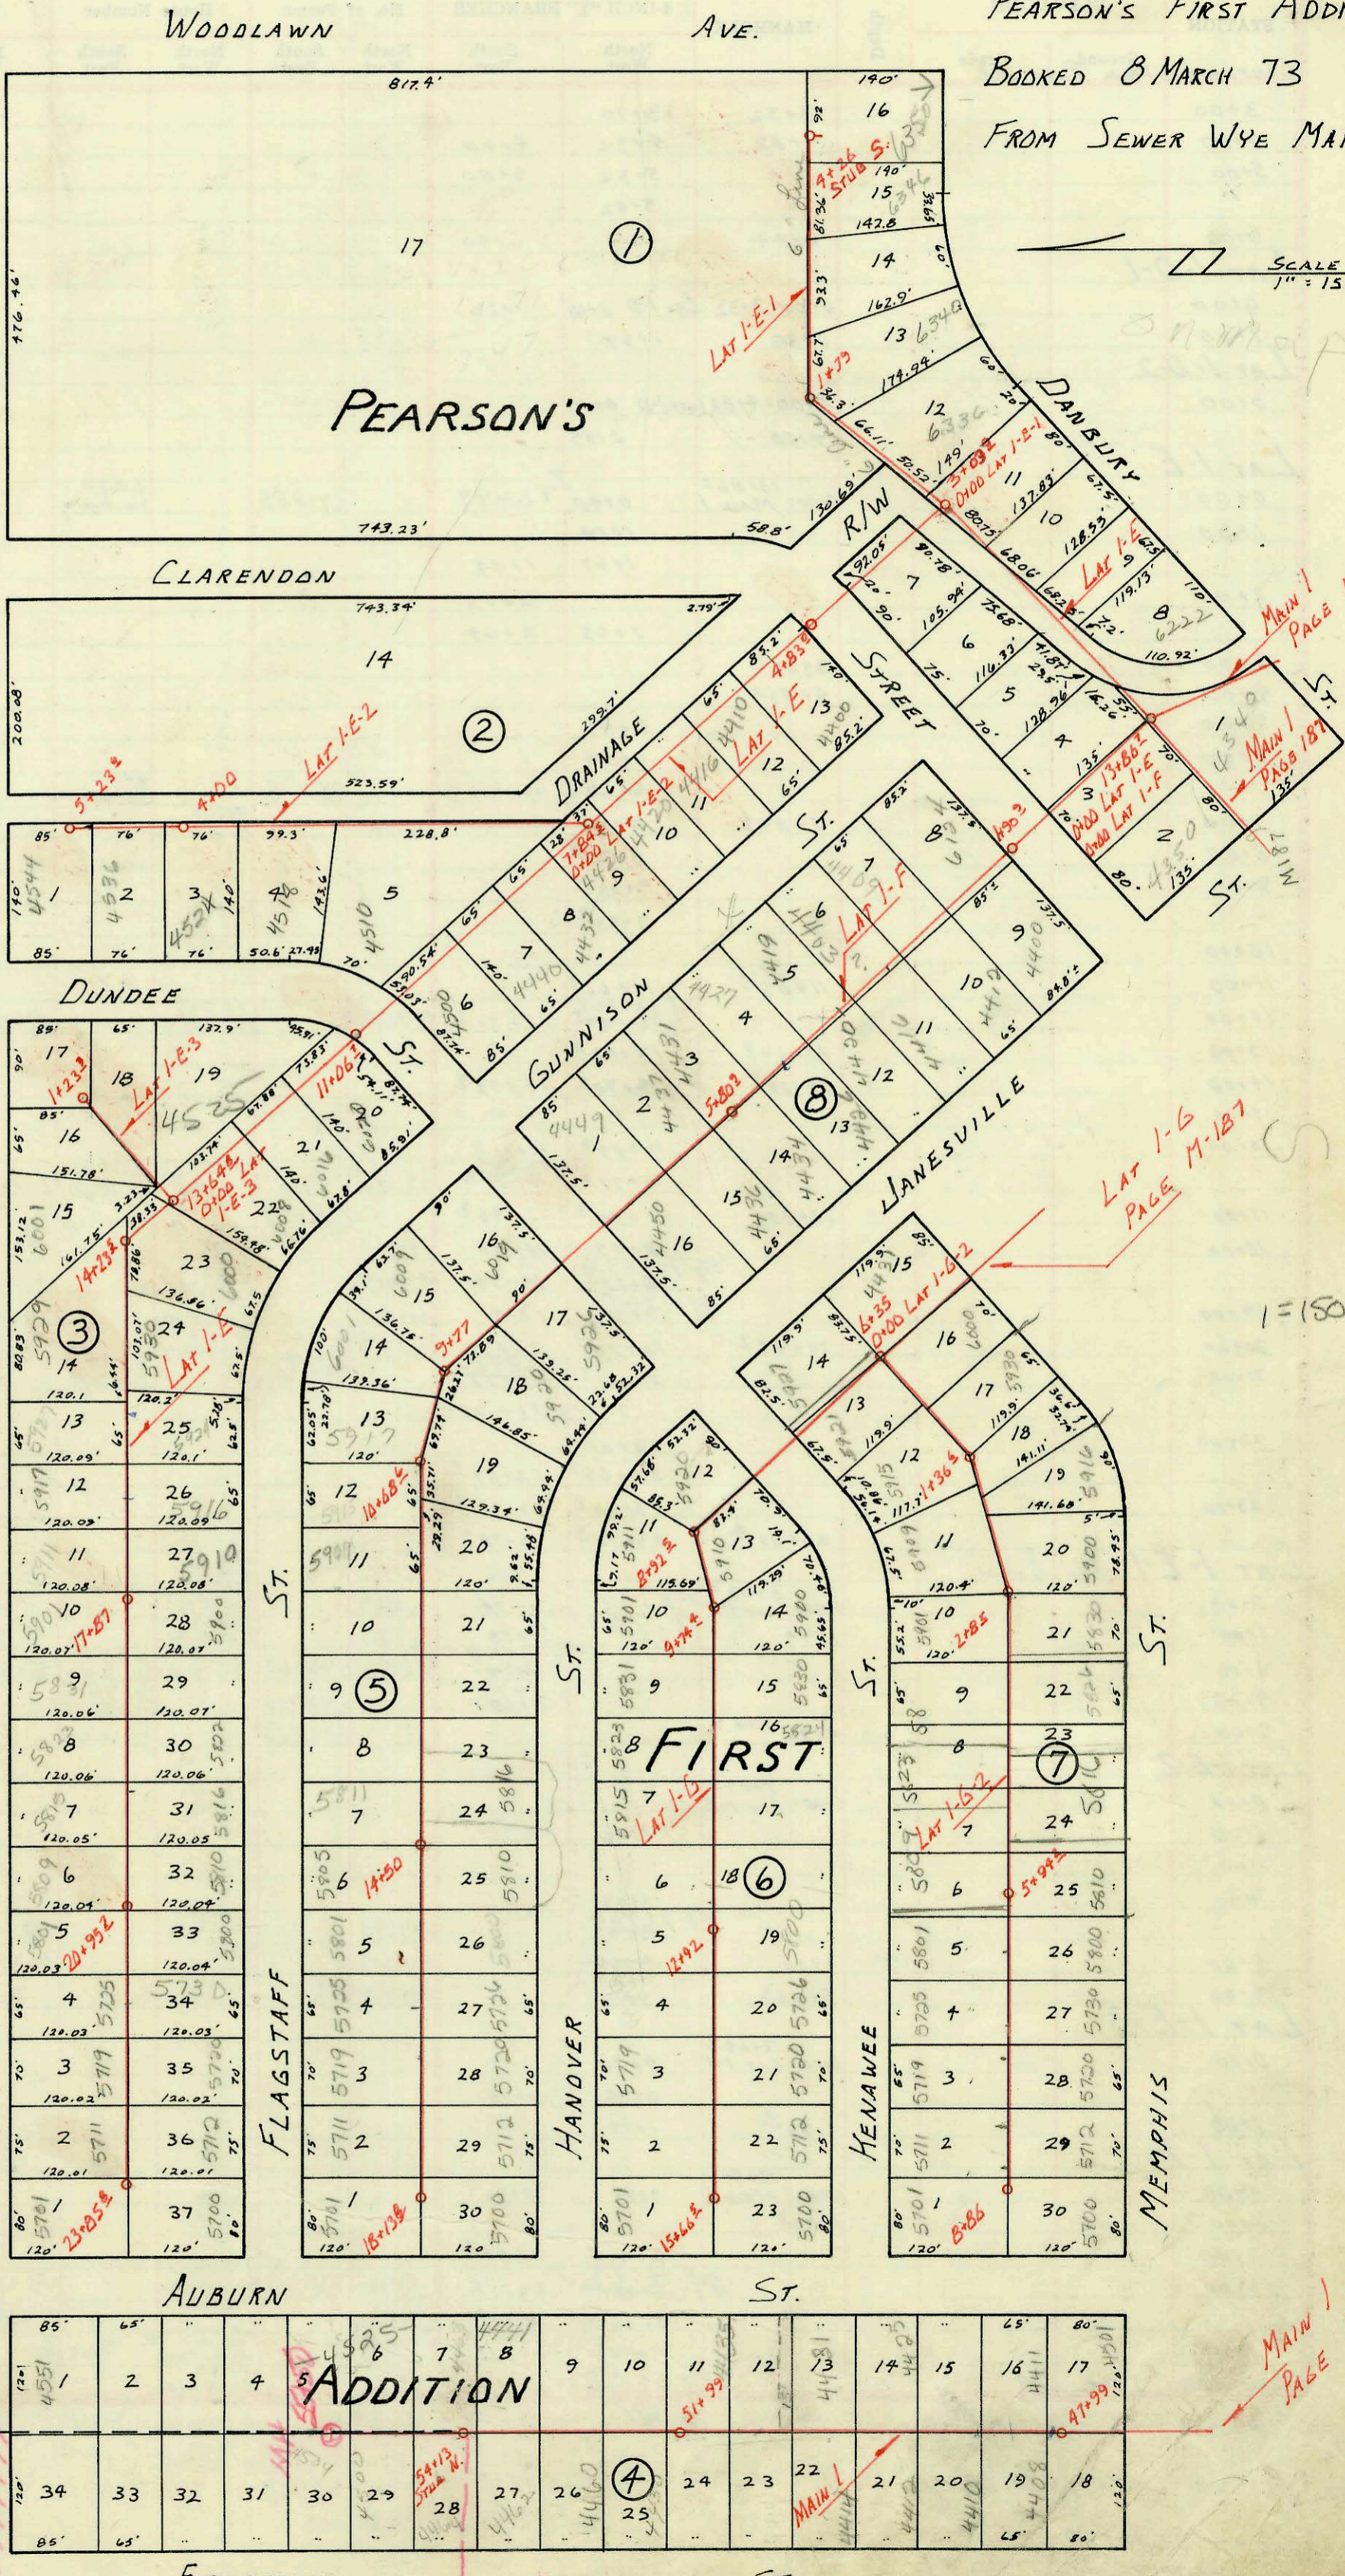

No. STREET 45th

LAT 1-G PAGE M-187

1=150

MAIN 1 PAGE M-187

SEE M-185

Force Main 1 See Sketch 3

CONSTRUCTION RECORD						SERVICE RECORD						
STATION	ELEVATION		Depth	MANHOLE	4-INCH "Y" BRANCHES		No. of Permit		House Number		DATE OF PERMITS	
	Ground From	Grade Page 189			North West	South East	North West	South East	North West	South East	North West	South East
5100				5+802	50A 40 PVC-4		82777		4487	R Repair	4-17-92	
6+00			7'		6+232 ✓	6+252	04712		4449	R Permit	10-5-79	
					6+882	6+902	053341		4449	R Permit	1-23-76	
7+00												
8+00					8+642	8+662						
9+00				9+77	Top 9+246	9+432	039660		6001	Flagstaff	6-22-73	
10+00				10+682	10+35	10+55	048708		5917	Flagstaff	3-18-75	
11+00					Top 11+70.6		047782		5901	Flagstaff	12-16-74	
12+00					12+572	12+362						
13+00					13+216	13+232						
14+00				14+50	Top 13+88	13+892	047482		5811	Flagstaff	11-21-74	
					14+542	14+562						
					14+90	14+92						
15+00					15+52	15+54						
16+00					16+16	16+18	18848		5925	Flagstaff	8-19-87	
					16+75.8	16+72	2806		5919	Flagstaff	3-31-85	
					16+704	16+72						
17+00					17+38	17+40						
18+00				18+132	4" SCH 40	18+05	200277		5901	Flagstaff	5-24-00	
LAT 1-G												
0+00				0+00	16+782							
1+00					MAIN 1							
2+00						2+94						
3+00				3+252		3+432						
4+00												
5+00						5+882						
6+00				6+35		6+66						
7+00												
8+00				8+922		8+45						
9+00						9+042		3114	5920	R Kenawee	3-31-97	
						9+912						
10+00						10+412						
11+00						11+262						
						11+722						
12+00			7.4	12+92		12+372	075388	1408	5909	R Kenawee	11-19-79	9-12-85
13+00						13+04						
						13+68		23724	5719	R Kenawee	3-7-79	8-8-89
14+00						14+30	070496					
15+00						15+06						
						15+58						
LAT 1-G-1												
0+00				0+00	3+252							
1+00					LAT 1-G							
						1+11		2500	6014	R	See next pg	16-3-00
						1+76		047789	5925	R	Memphis	12-16-74
2+00						2+66	25895		5919	R	Memphis	8-2-90
3+00						3+23	19568					
4+00				4+732		4+902						
5+00												
6+00												
7+00						7+082		039658	4335	R	Bellmore	6-22-73
8+00				7+402		7+622						
						8+582						
						8+342						
9+00				9+332		9+242						
						9+842						
10+00						10+672						
11+00						11+452						
						11+872						
LAT 1-G-1A												
0+00				0+00	3+732	0+52						
1+00				1+06	LAT 1-G-1	1+10		048707	5901	R	Memphis	3-18-75
LAT 1-G-1B												
0+00				0+00	4+372							
1+00												
2+00						1+95						
3+00						2+21						
4+00						2+85						
						3+49						
						3+92						

CONTINUED PAGE 191

062527 - at planning - 5924 Kenawee - 8-11-77 - R (26 ft. W of E. Maple Ave) #2417 8-13-92 5931 Memphis - MORRIS - 109 (W Mt)

#24338 11-22-87 6000 Clarendon - Rep. (2161.1)

#2482 4-20-93 6020 Clarendon - Buckley -

