



CONSTRUCTION RECORD

SERVICE RECORD

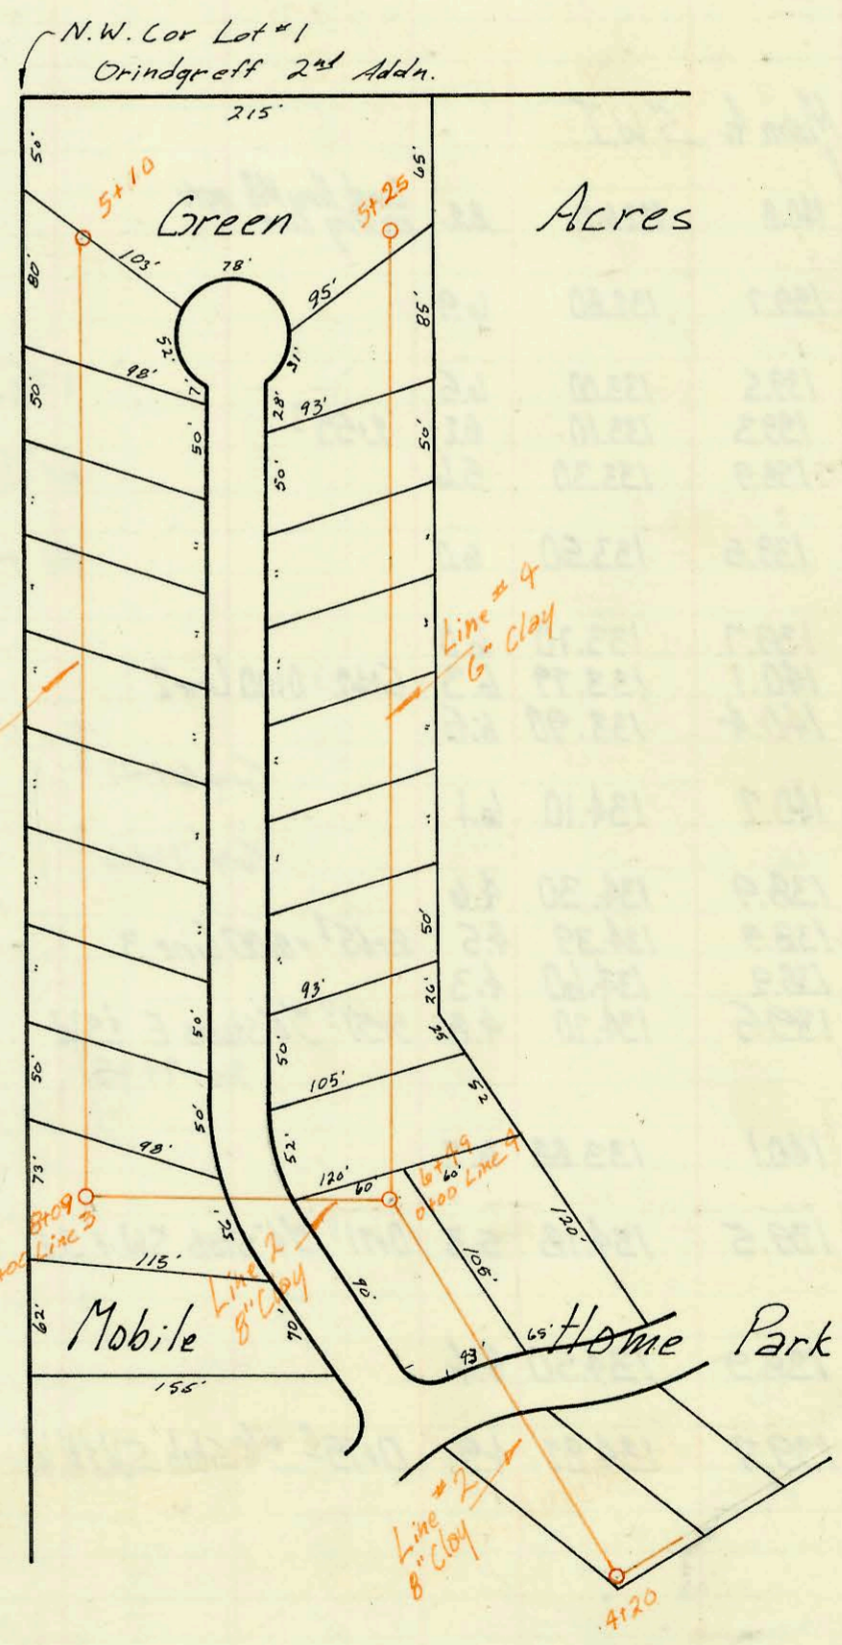

Private Lines
 Sanitary Sewer for
 Green Acres Mobile Home Park
 Built by: Mid-States Const. Co.
 Booked B-27-73 from "As Built" Plan
 Proj No. BHK8503019

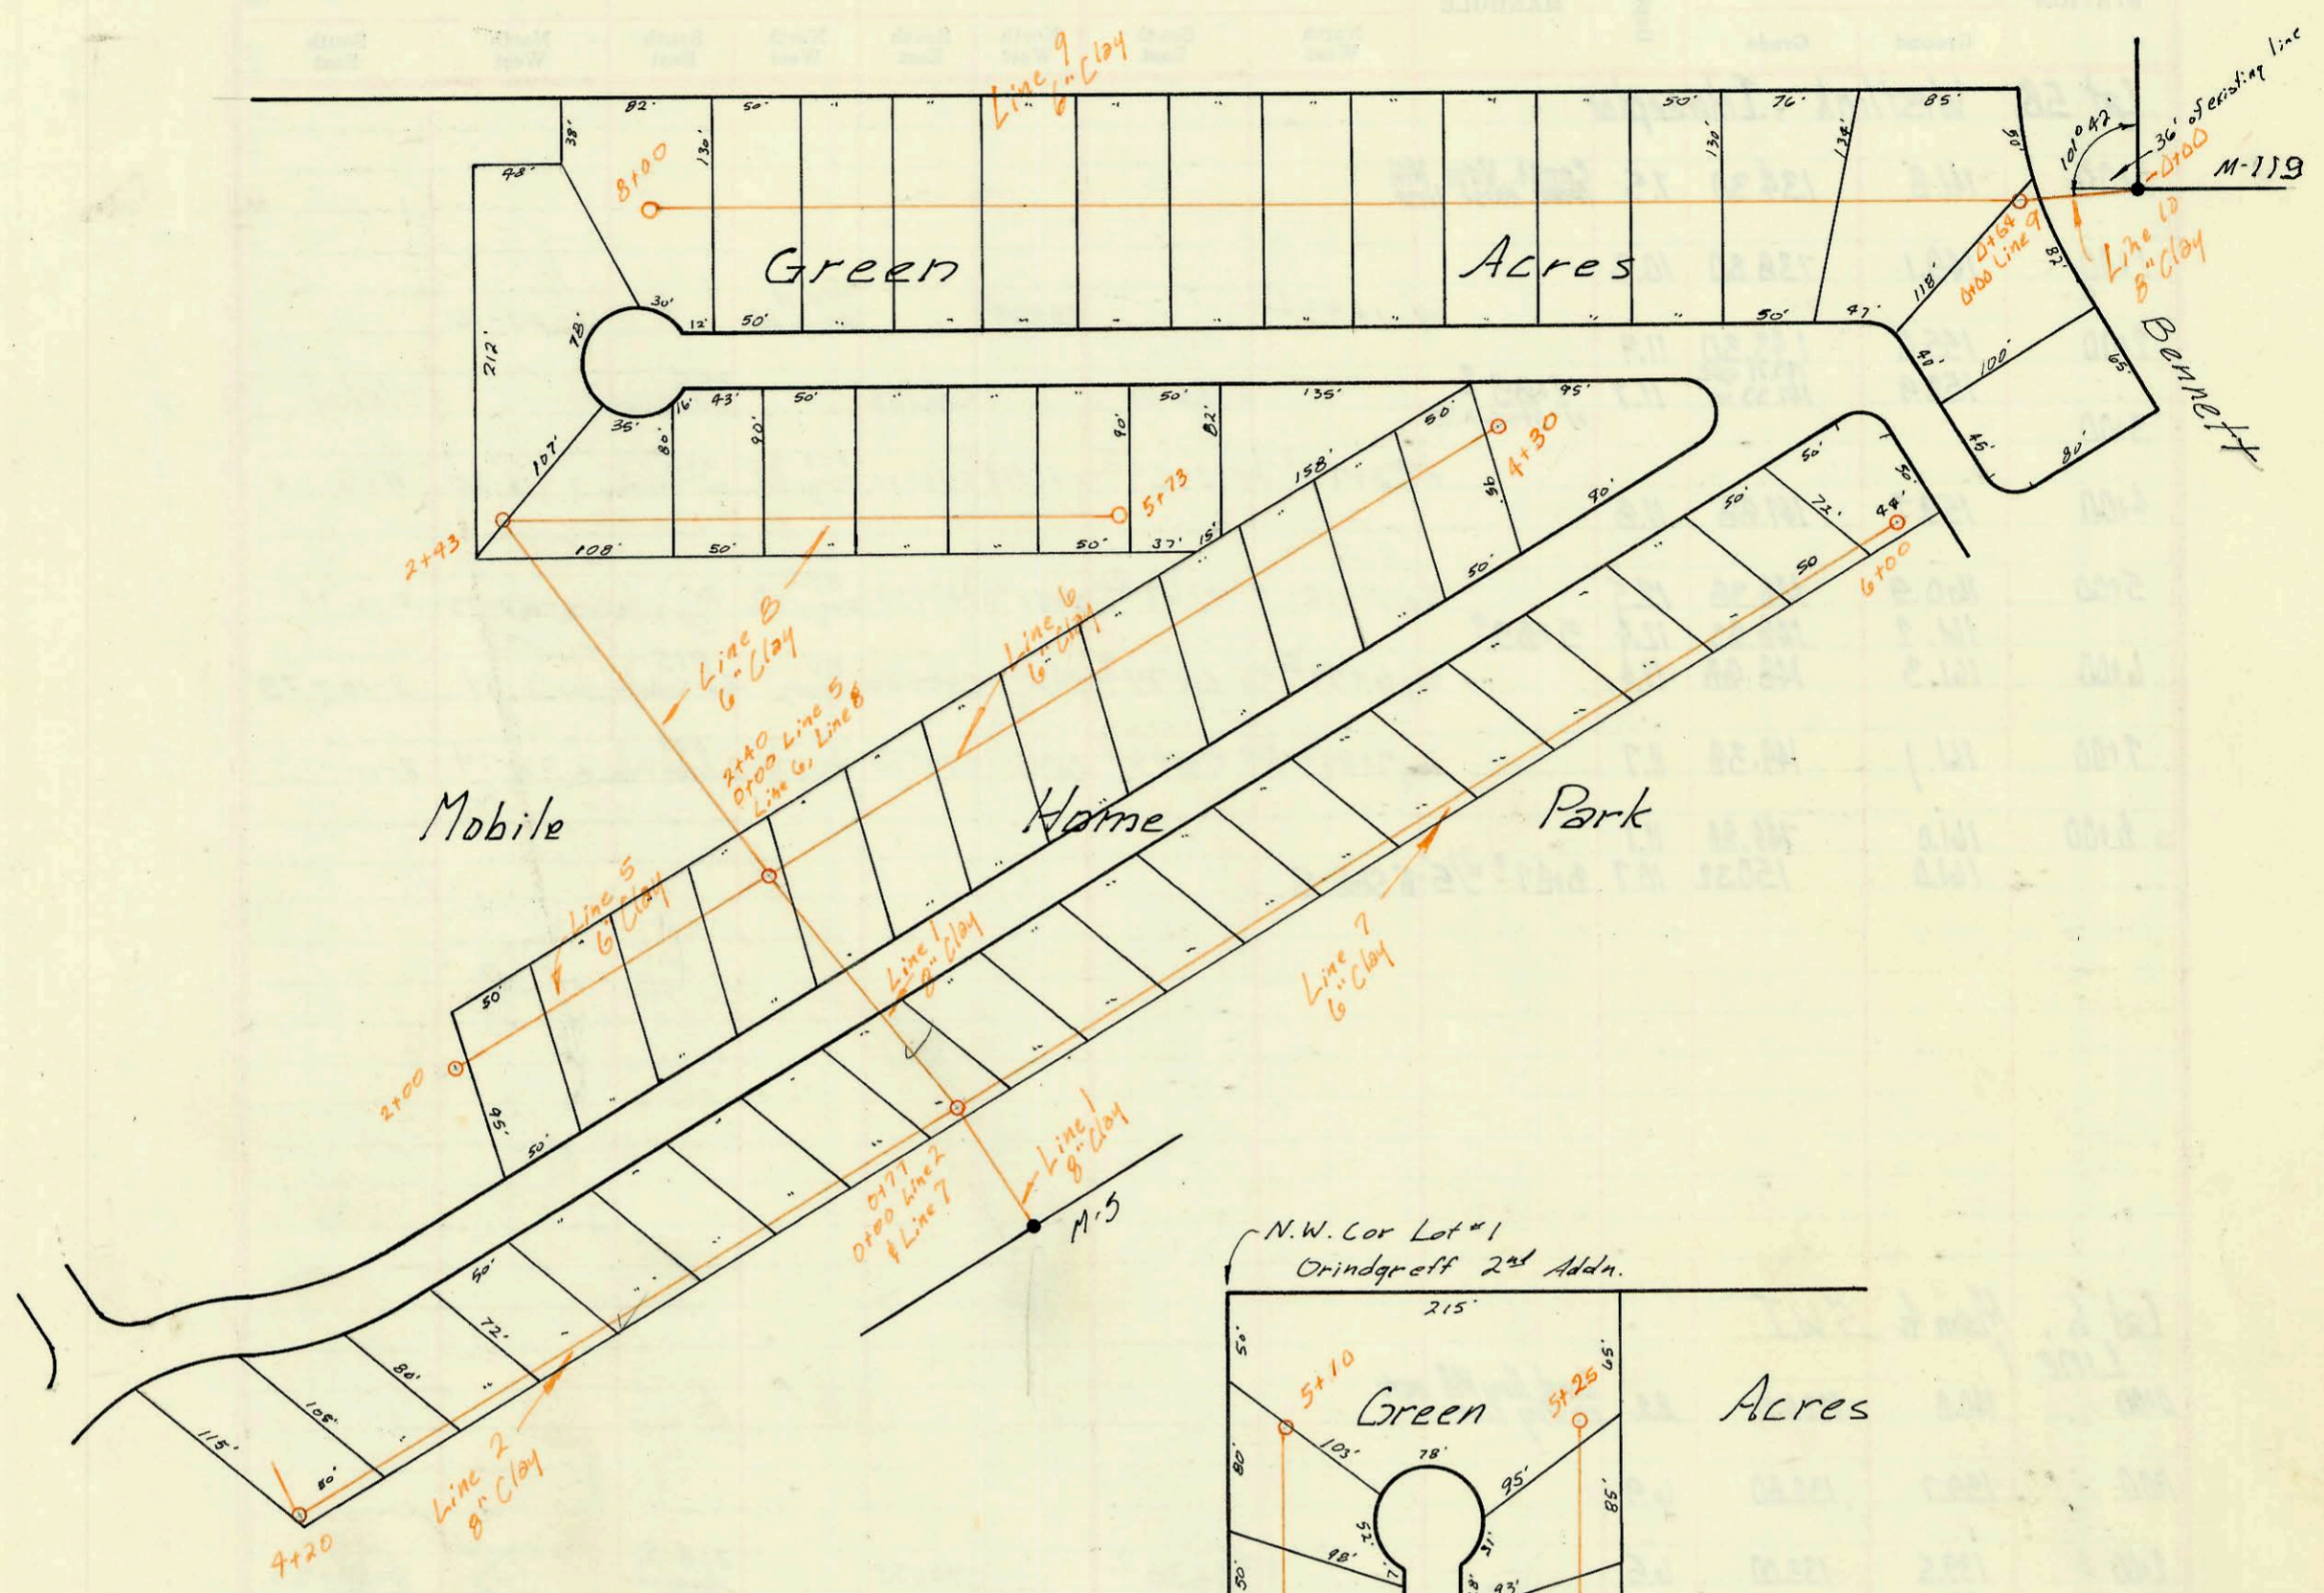