
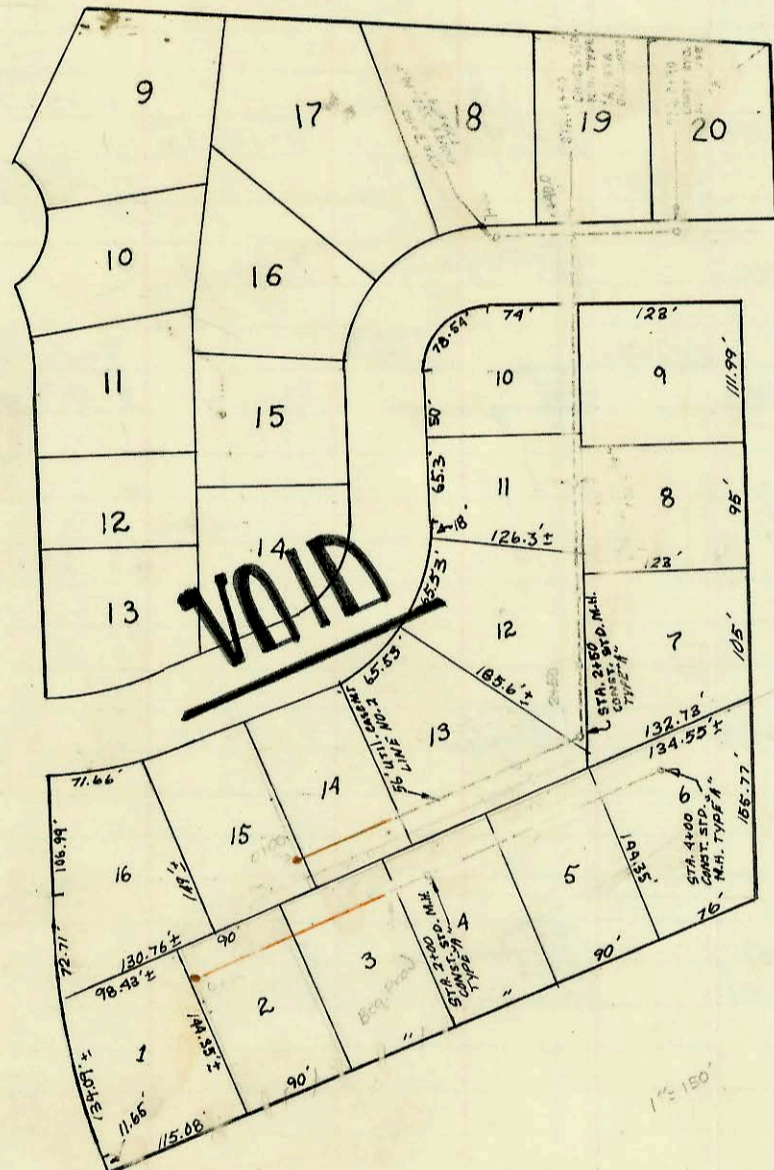
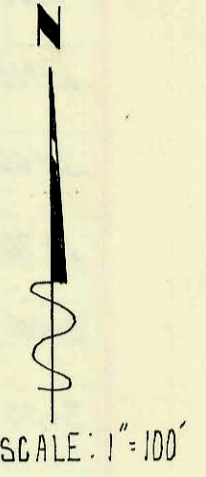


Lat 55 Westlink Sewer.

Built by Mid-States Const. Co.
Booked Nov 5, 1973 from K-100
Proj No. DBKL572048

on map

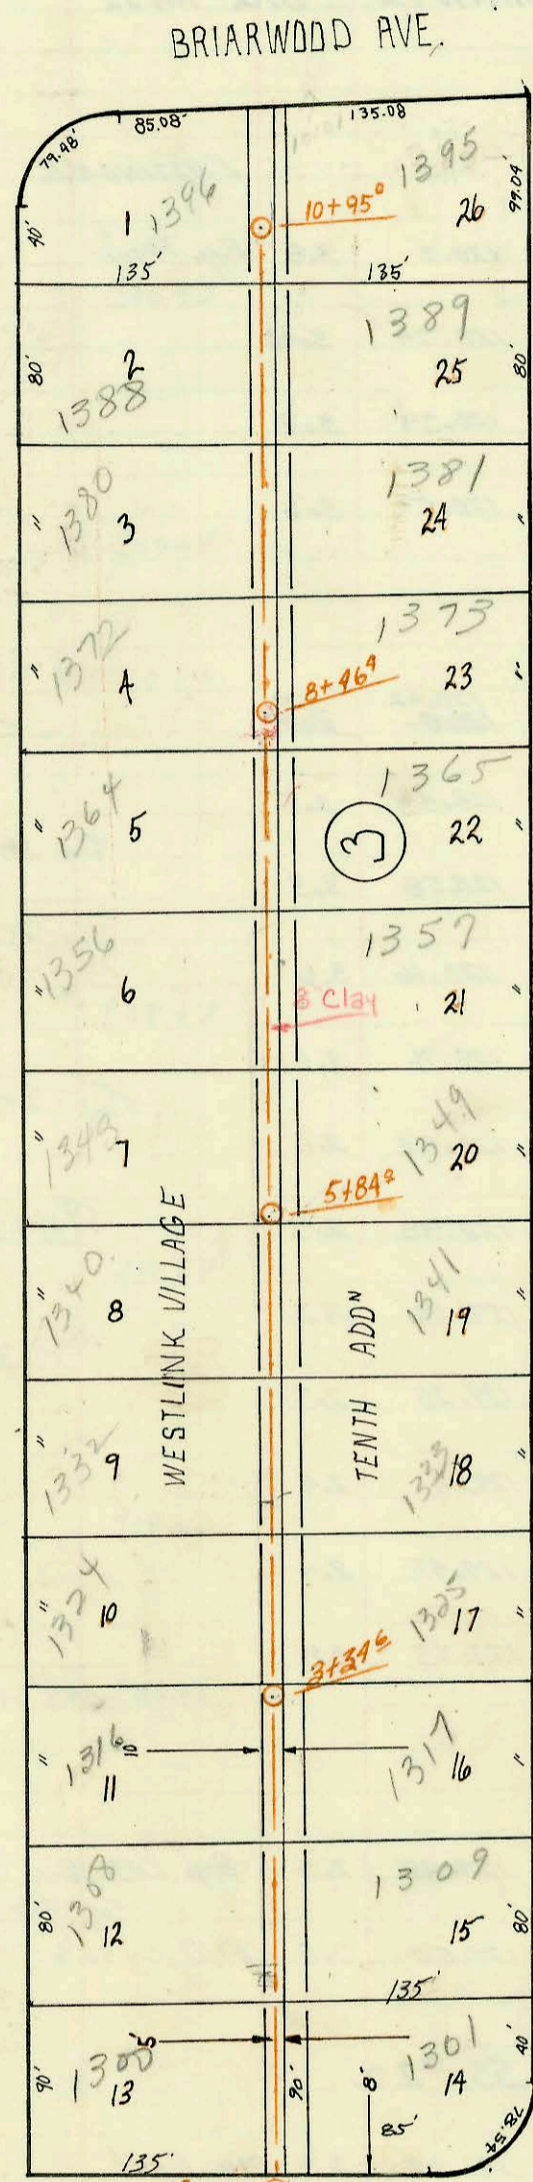

LAT.5, MAIN 2
WESTLINK SEWER
BUILT BY: UTILITY CONST. CO.
BOOKED: OCT. 19, 1973 From K-109
PROJECT NO. DBKL 572053

on map

