


SERVICE RECORD

CONSTRUCTION RECORD

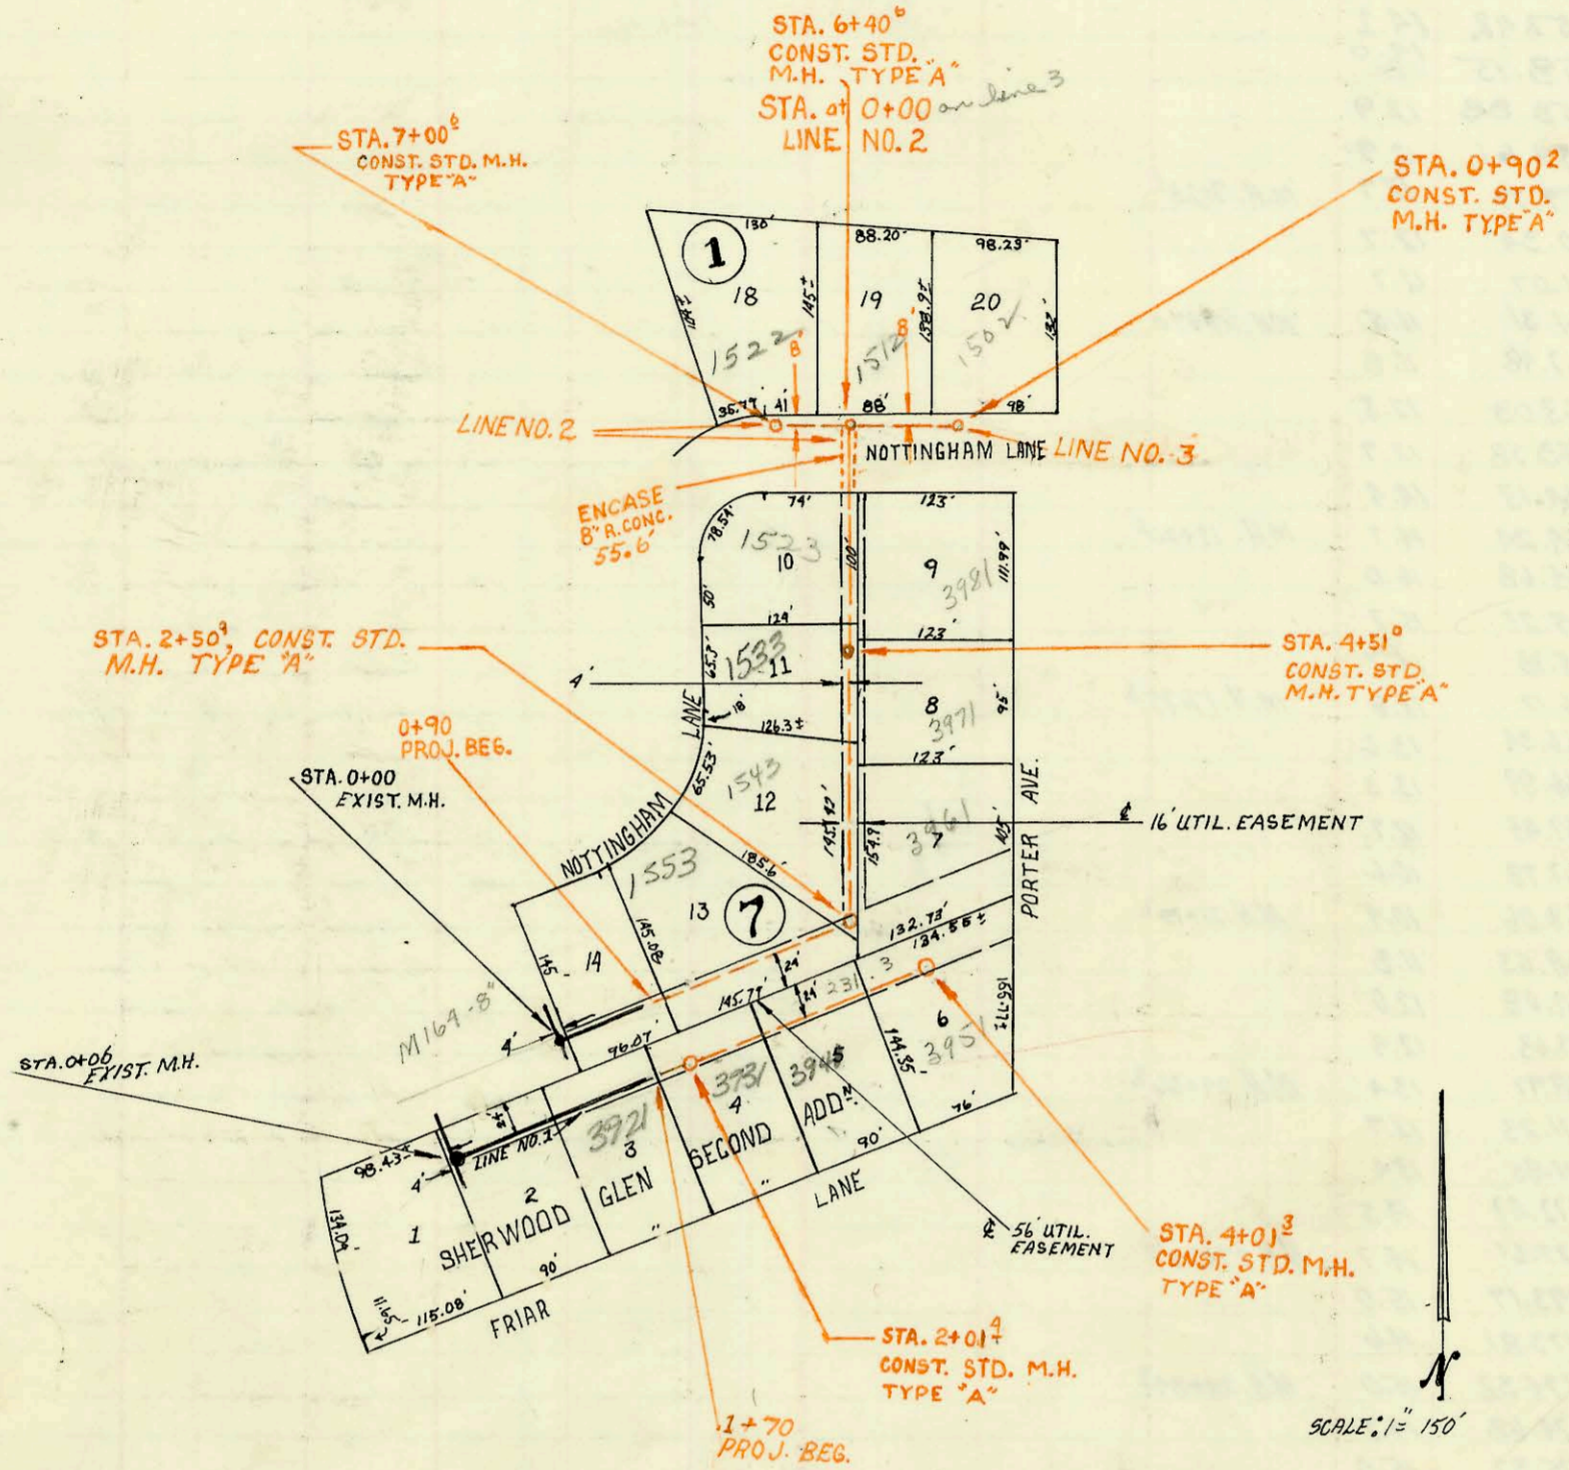


LAT. 7 SUBMAIN 21, S.S. 22
 BUILT BY: UTILITY CONST. CO.
 BOOKED: NOV. 19, 73 FROM: K-107
 PROJ. NO. DBKL 565027

Ortech Add
 Lots 1 & 2
 700' Lot + main line per lot
 Waived per receipt of
 Notwithstanding letter from owner
 stating these two lots will
 be mt. to future gravity flow
 sewer to their lots and
 must receive Bids and
 to new gravity
 sewer
 See copy of letter
 encl. 5/1/90
 BK

Ormap

Leisy Addition

Private Easement
 5' 10" of E. 350' of
 Lot 1, Leisy Add.
 Lots 1 & 2
 of
 Ortech Add
 Lot 1
 22 S18
 Lot 2

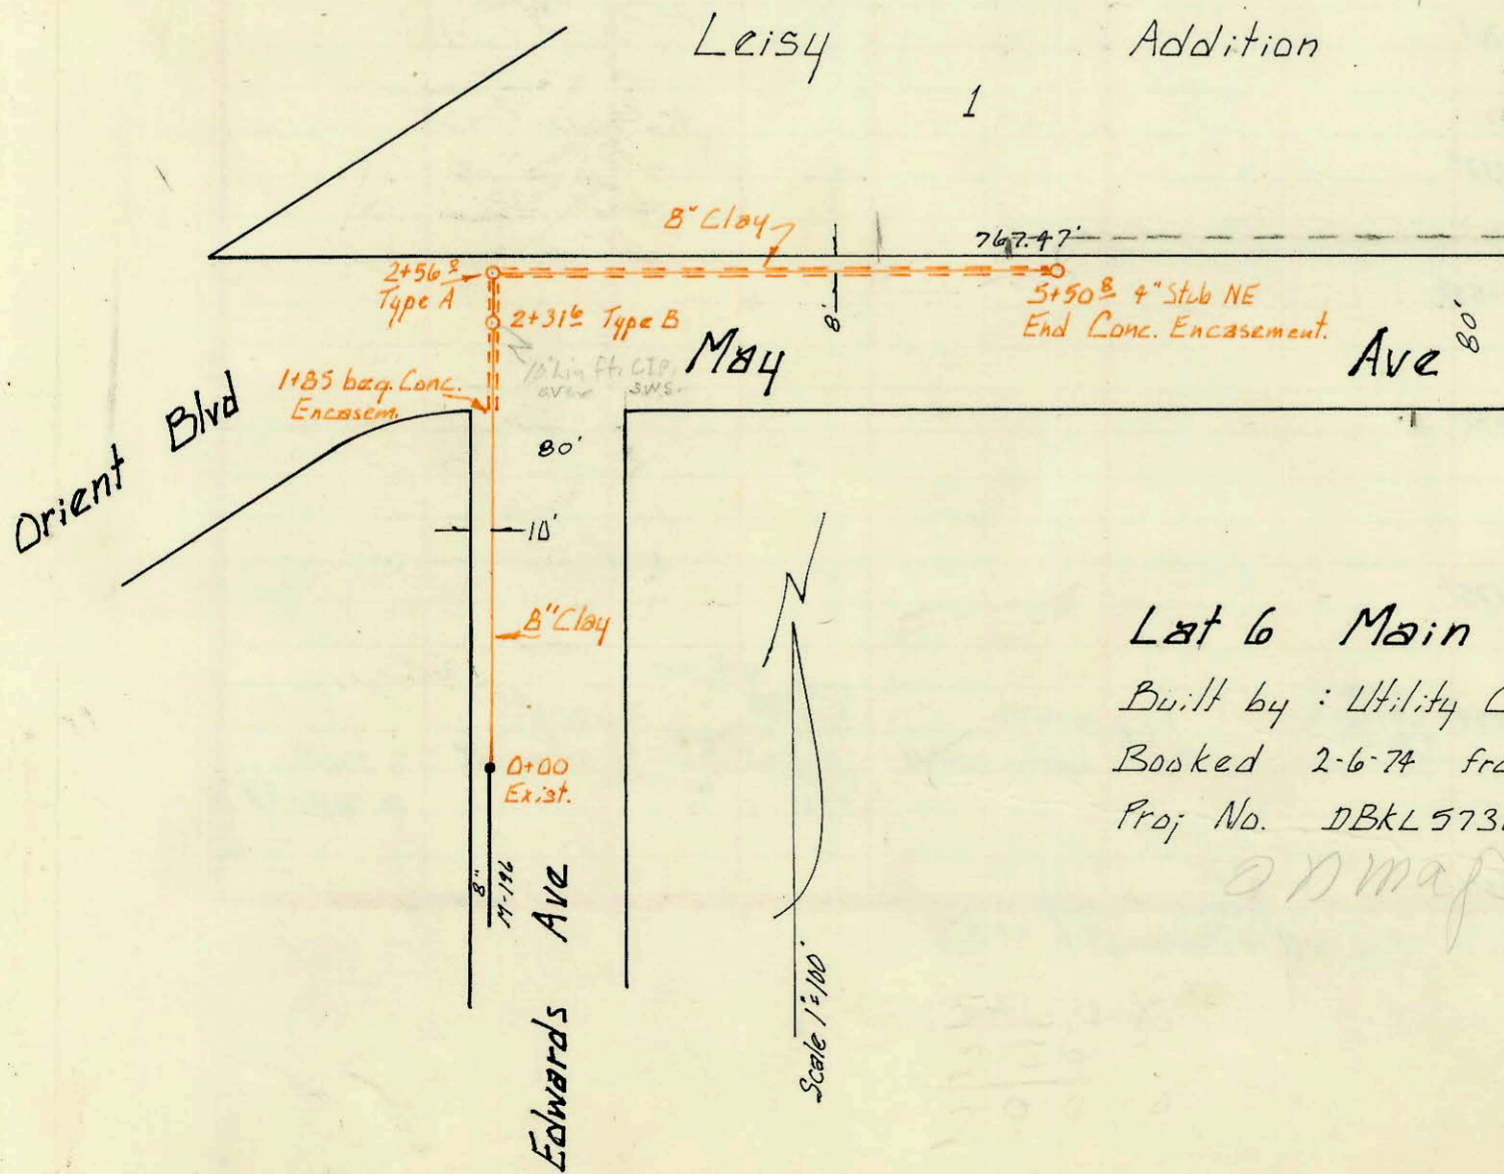

Lat 6 Main 16 S.S. 22
 Built by: Utility Cont. Inc.
 Booked 2-6-74 from S.S. Jk #5
 Proj No. DBKL 573053

Ormap

CONSTRUCTION RECORD						SERVICE RECORD						
STATION	ELEVATION		Depth	MANHOLE	4-INCH "Y" BRANCHES		No. of Permit		House Number		DATE OF PERMITS	
	Ground	Grade			North West	South East	North West	South East	North West	South East	North West	South East
LAT. 7 SUBMAIN 21 S.S. No. 22												
LINE NO. 1												
0+00				EXISTING M.H.								
1+70	132.0	128.2	3.8	Beq. Prod. 2+01 1/2	Top 1+32 0		C45335		3921 Fran			6-19-74
2+00	131.7	128.24	3.04		Top 2+18 0		C45336		3931 Fran			6-19-74
3+00	131.6	128.39	3.02									
4+00	132.2	128.54	3.06	4+01 1/2	Top 3+93 1/2		C48467		3951 Fran			2/26/75
LINE NO. 2												
0+90	131.9	128.42 128.42	3.5 3.5	0+0 EXIST M.H.								
1+00	131.7	128.43	3.05		Top 1+87 2		C47677		1553 Nottingham			12-5-74
2+00	131.9	128.58	3.03									
2+50 IN	132.3	128.66	3.6	2+50 1/2								
2+50 OUT	131.9	128.76	3.1		Top 1+34 1/2		C53116		3961 Fran			1-13-76
3+00	131.9	128.83	3.0		Top 3+19 1/2		C52389		1543 Nottingham			11-10-75
4+00	131.7	128.98	2.7	4+51 1/2	Top 4+14 1/2		C53117		3971 Fran			1-13-76
5+00	132.1	129.13	2.3		Top 4+37 1/2		C43206		1535 Nottingham			1-29-74
6+00	131.6	129.28	2.3		Top 4+92 1/2		C51381		3981 Fran			9-16-75
6+40 IN	131.7	129.34	2.4		Top 3+96		C54093		1523 Nottingham			3-9-76
6+40 OUT	131.8	129.43	2.4	6+40 1/2								
7+00	132.3	129.53	2.8	7+00 1/2	Top 6+92		C50179		1522 Nottingham			7-3-75
LINE NO. 3												
0+00	131.8	129.45	2.3	0+0 Beq. EXISTING	Top 0+35.6		C48470		1512 Nottingham			2-26-75
0+90 1/2	131.6	129.58	2.0	END 0+90.2 - M.N. Tap			C57084		1531 Nottingham			8-4-76
Lot 6, Main 16. S.S. # 22												
0+00	104.9	101.49	3.4	0+00 Ex. st.								
1+00	104.8	101.64	3.2									
2+00	105.2	101.79	3.4									
	104.6	101.84	2.8	2+31 1/2								
	104.6	101.87	2.5	2+56 1/2								
3+00	105.1	101.94	3.2									
4+00	104.6	102.09	2.5									
5+00	105.0	102.24	2.8									
	104.4	102.32	2.1	5+50 1/2 4" Stub NE.	MHTAP		C44255	25219	236 May	2518 May		4-3-74 4-29-90
South 2005 - 0632 3170s 1543 w Nottingham - Ben. Franklin Hqs: (Repair New Bathroom)												

Top 45334 3941 Fran Lane " " (3+42.3)