
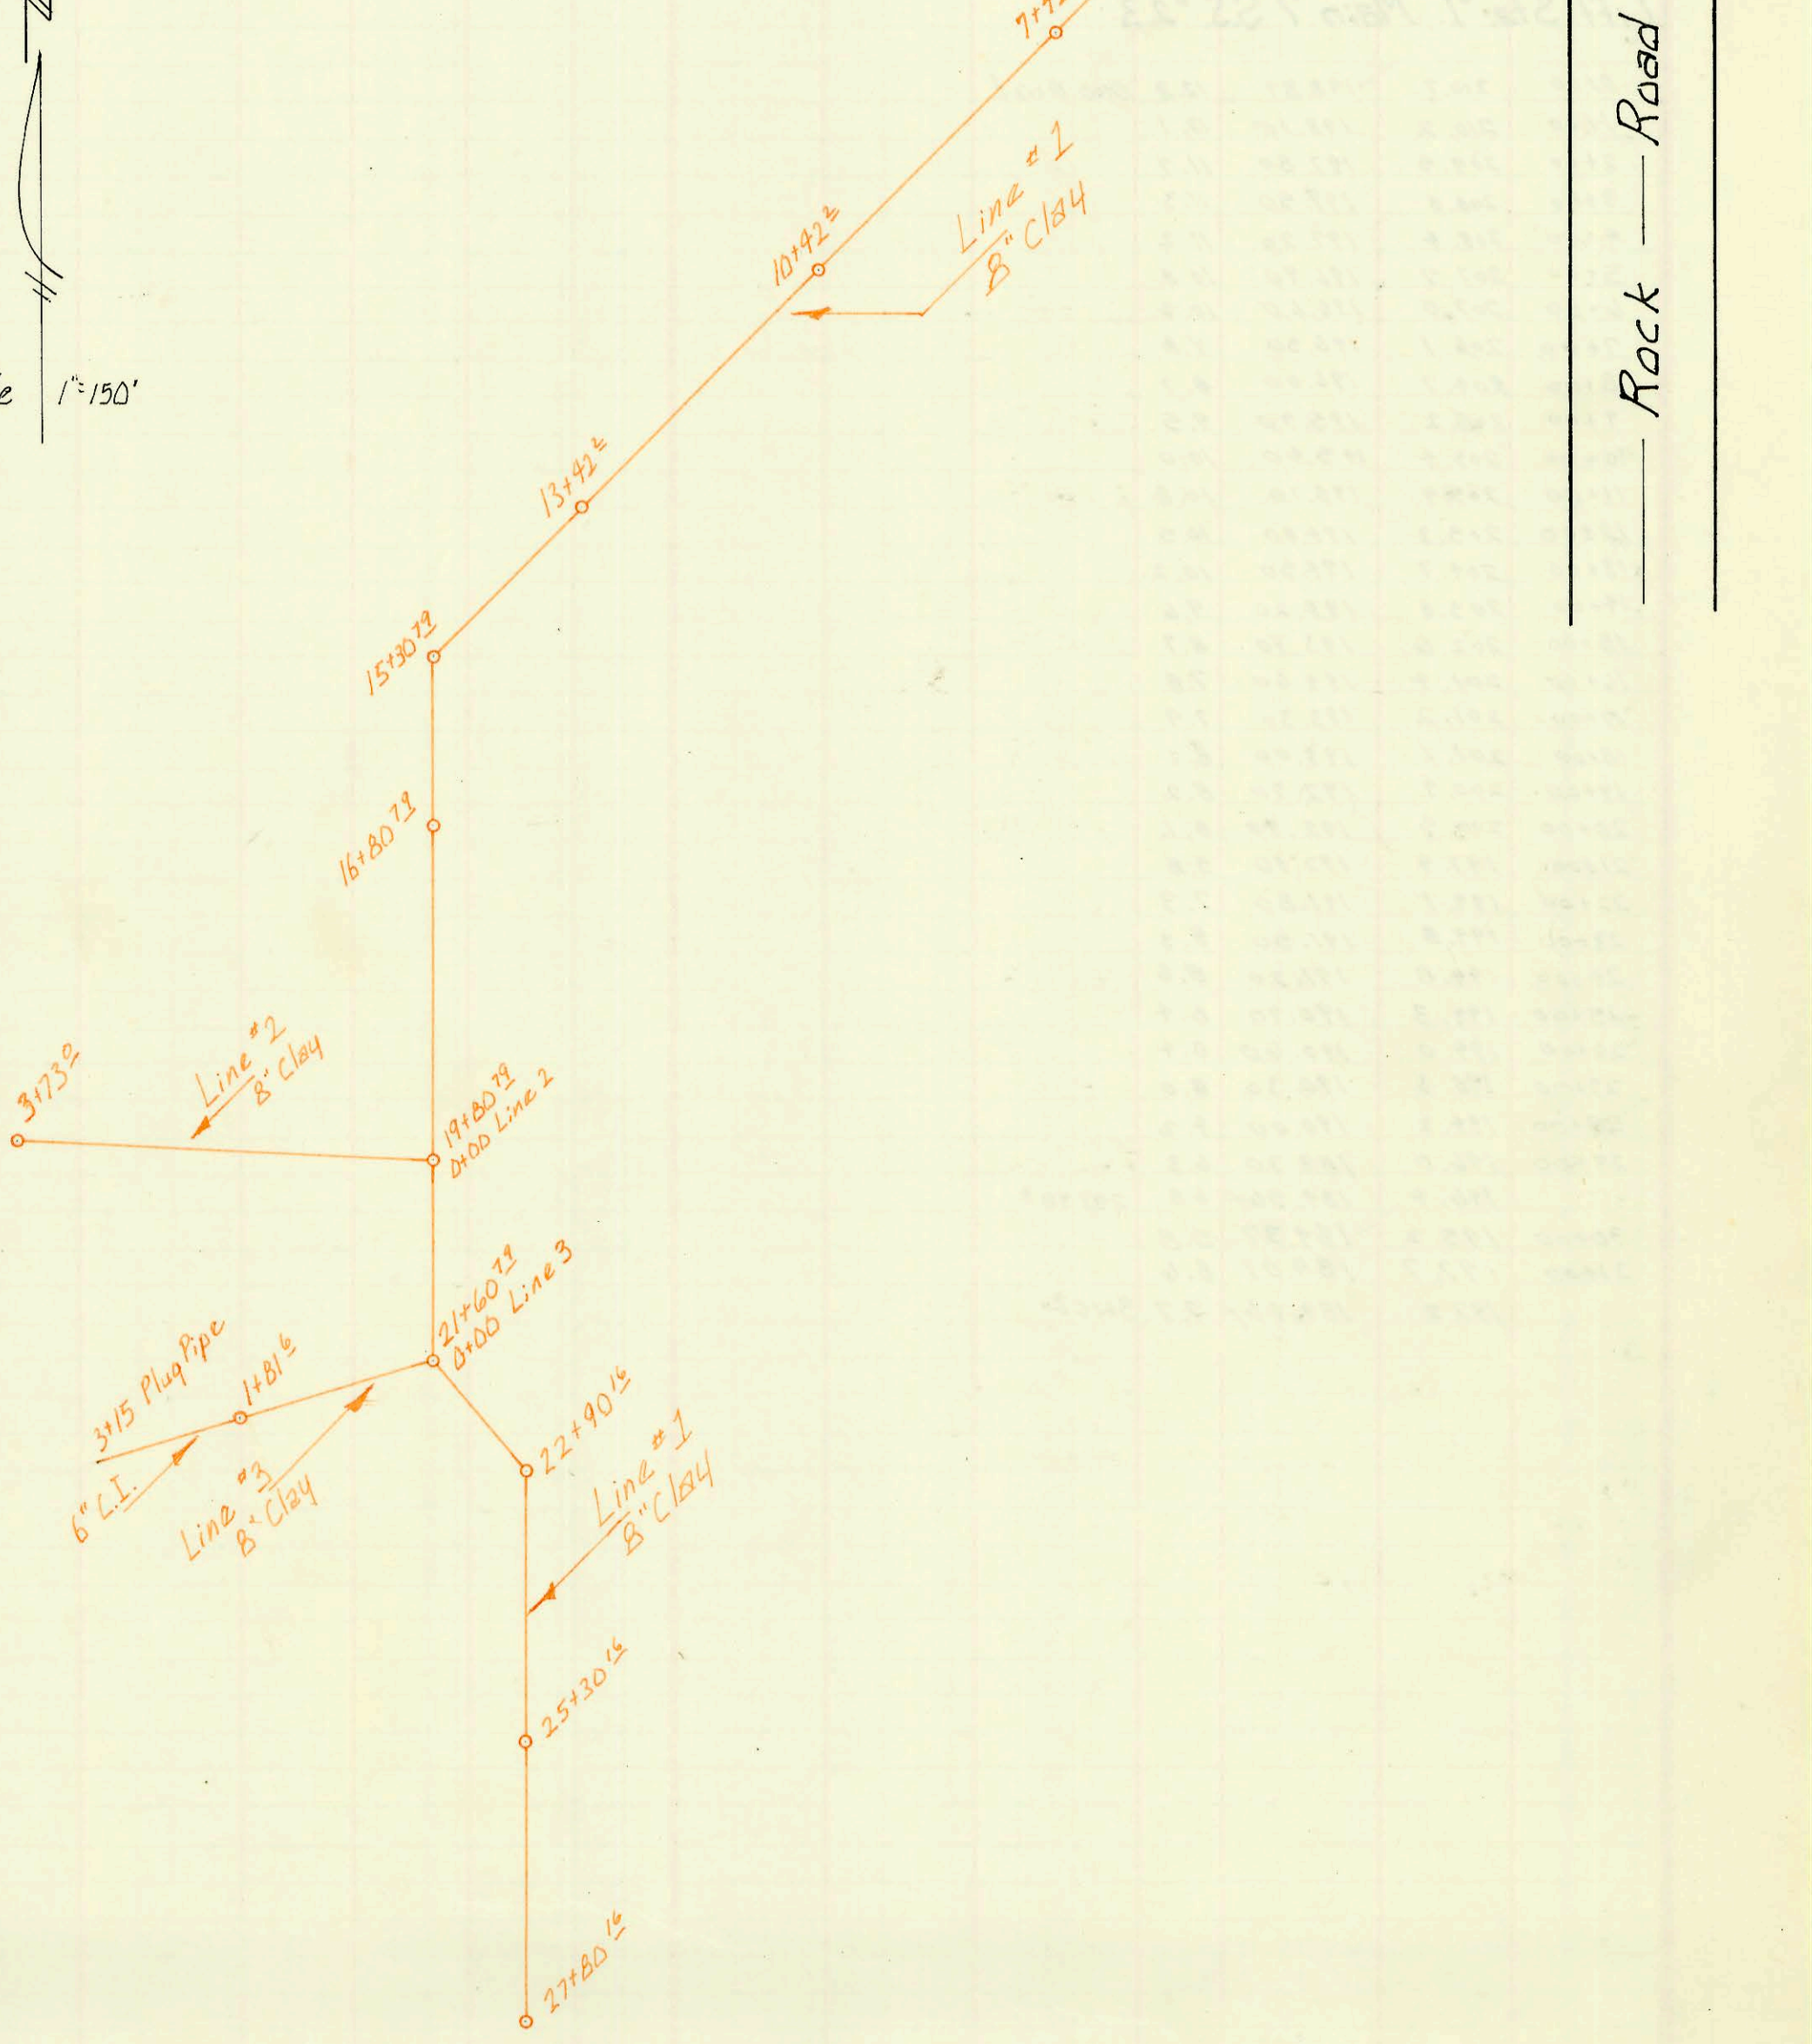


Pawnee Ave

Private Sanitary Sewer for Cessna Aircraft

Built by: Carter Const. Co.
Booked Jan. 9, 1974 from "As Built" Plan
Pro No. BHKBS03041

on map

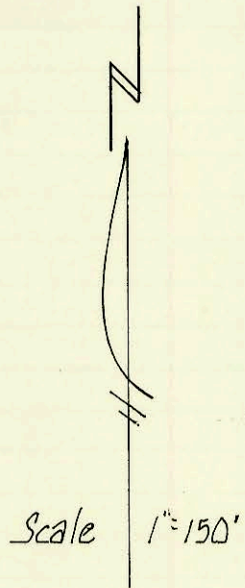

CONSTRUCTION RECORD						SERVICE RECORD						
STATION	ELEVATION		Depth	MANHOLE	4-INCH "Y" BRANCHES		No. of Permit		House Number		DATE OF PERMITS	
	Ground	Grade			North West	South East	North West	South East	North West	South East	North West	South East
Private Sen. Sew. Cessna Aircraft.												
Line #1 0+00	163.3	151.9	11.4	Exist MH								
1+00	169.1	out 159.32 in 163.72	19.8 5.4	1+42 ²								
2+00												
3+00												
4+00	174.0	out 167.05 in 170.10	6.9 3.9	4+42 ²								
5+00												
6+00												
7+00	178.8	173.25	5.5	7+42 ²								
8+00												
9+00												
10+00	185.1	176.45	8.6	10+42 ²								
11+00												
12+00												
13+00	191.9	179.65	12.2	13+42 ²								
14+00												
15+00	195.2	181.53	13.7	15+30 ¹⁹								
16+00	195.0	183.02	12.0	16+80 ¹⁹								
17+00												
18+00												
19+00	195.2	out 186.20	9.0	19+80 ¹⁹								
20+00												
21+00	195.6	186.90	8.7	21+60 ¹⁹								
22+00	194.8	187.52	7.3	22+90 ¹⁶								
23+00												
24+00												
25+00	195.8	188.48	7.3	25+30 ¹⁶								
26+00												
27+00	197.0	189.48	7.5	27+80 ¹⁶								
Line #2 0+00	195.2	in 186.60	8.6	0+00 = 19+80 ¹⁹ Line 1								
1+00												
2+00	194.2	187.69	6.5	3+73 ²								
Line #3 0+00	195.6	186.90	8.7	0+00 = 21+60 ¹⁹ Line 1								
1+00	195.2	188.24	7.0	1+81 ⁶								
2+00												
3+00												
3+15	Plugged Pipe											