


Private San. Sew. for NCR


Built by: Pearson Inc.

Booked Jan 17, 1974 from "As Built" Plan


Proj No BHKBS03060 on map

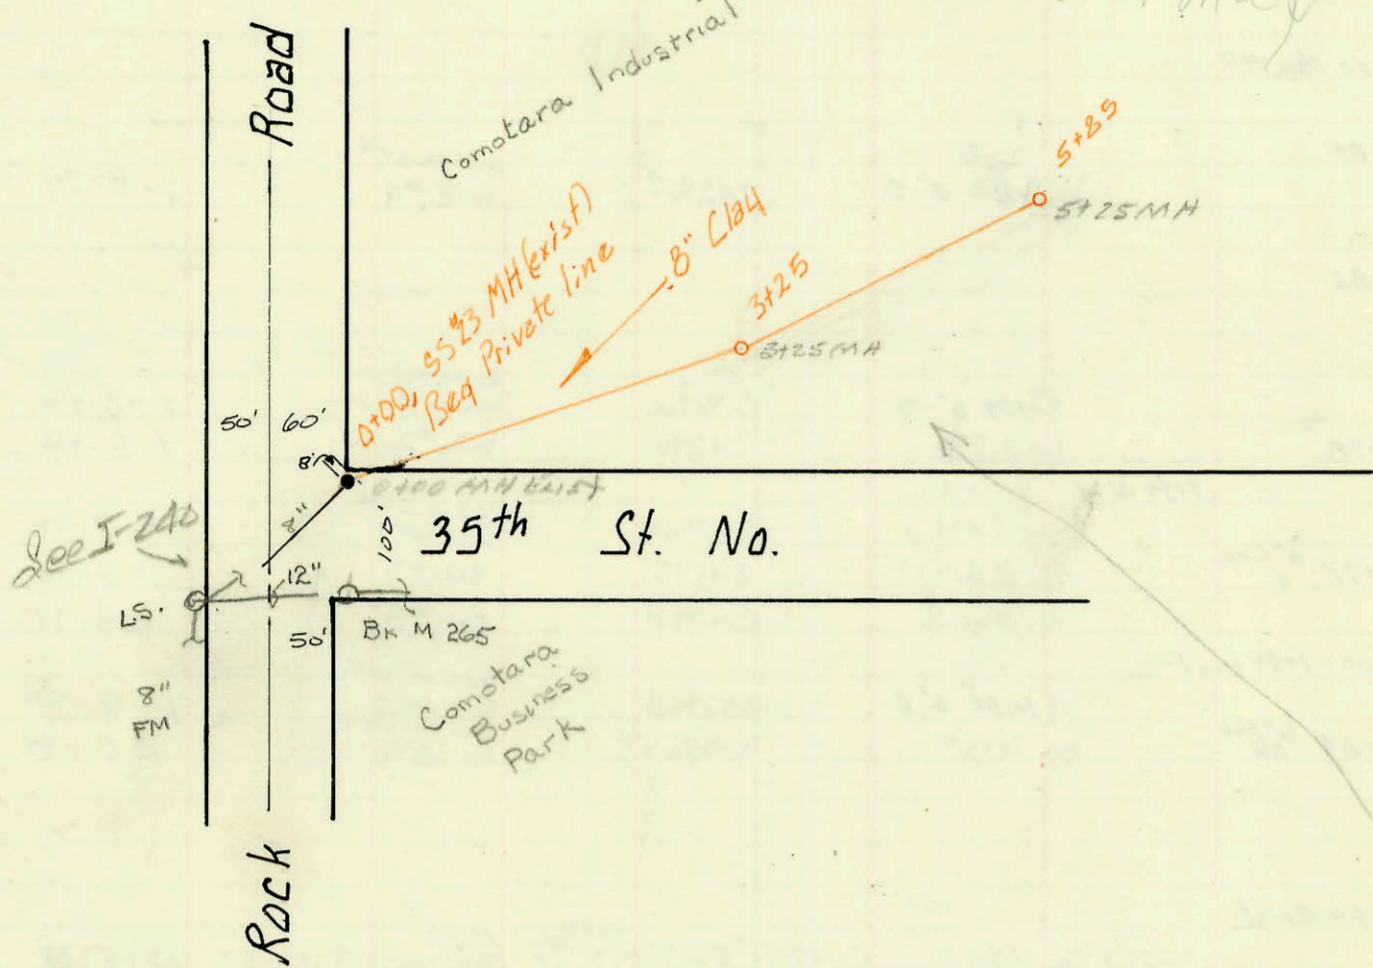

Scale 1" = 150'

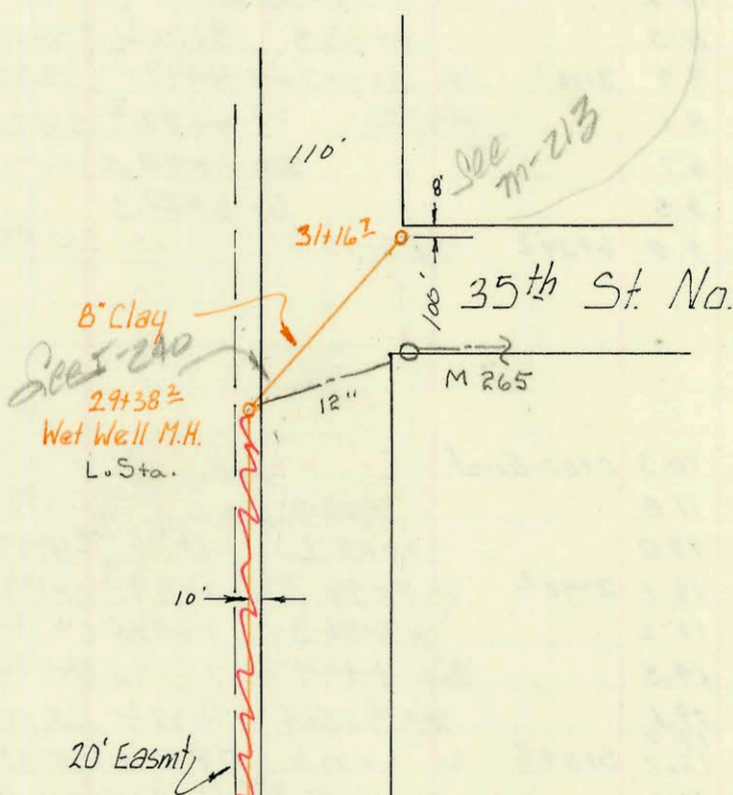

Scale 1" = 150'

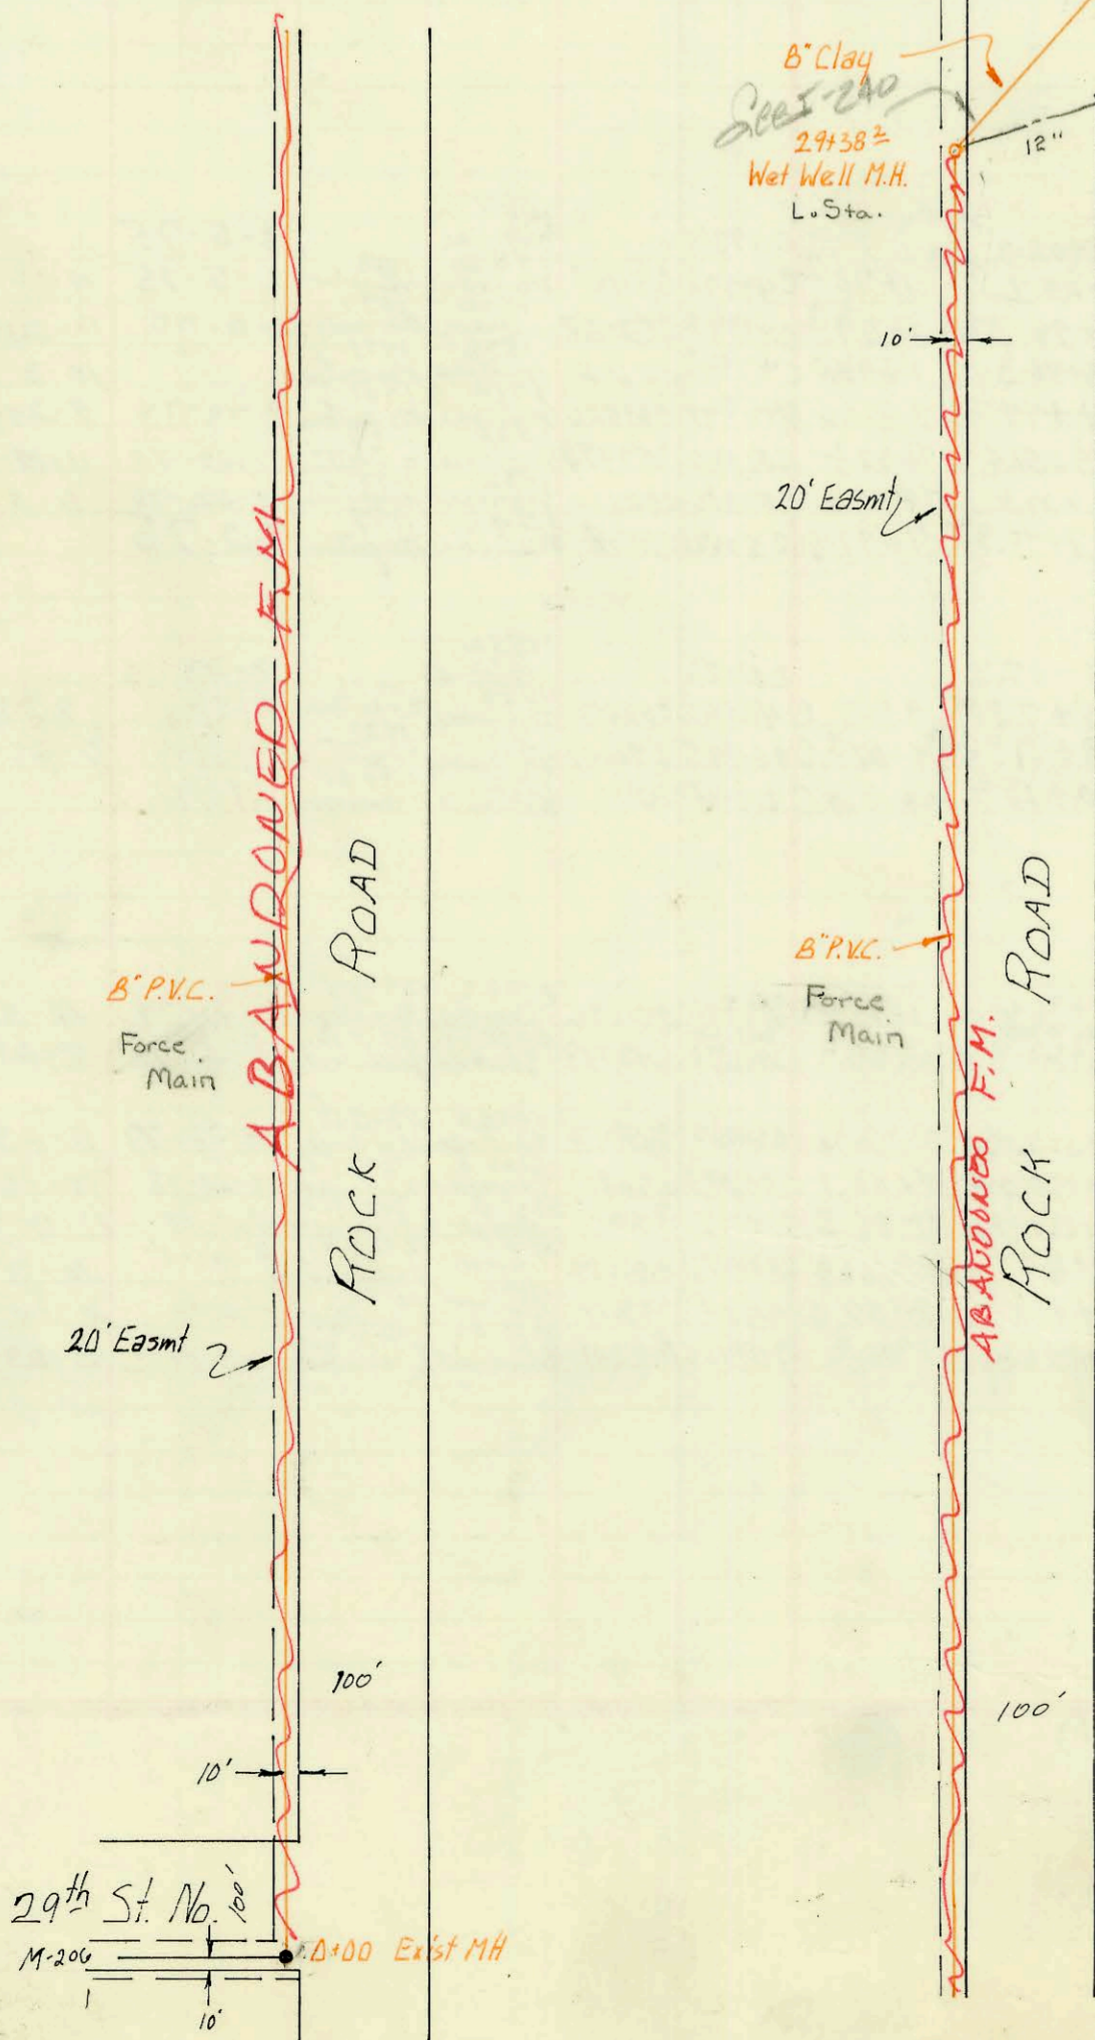

Lift Station #1 Main #7 SS #23

Built by: Utility Cont. Inc.

Booked 3-5-74 from I-H-74

Proj No. DBKP573060 on map

CONSTRUCTION RECORD						SERVICE RECORD						
STATION	ELEVATION		Depth	MANHOLE	4-INCH "Y" BRANCHES		No. of Permit		House Number		DATE OF PERMITS	
	Ground	Grade			North West	South East	North West	South East	North West	South East	North West	South East
Private San. Sew NCR												
0+00		IN 190.00 OUT 189.50		0+00 Exist								
1+00												
2+00												
3+00		IN 193.35 OUT 193.25		3+25								
4+00												
5+00		195.95		5+85								
Lift Sta. #1 Main #7 S.S. #23												
0+00	210.7	198.37	12.3	0+00 Exist								
1+00	210.2	198.10	12.1									
2+00	209.5	197.80	11.7									
3+00	208.8	197.50	11.3									
4+00	208.4	197.20	11.2									
5+00	207.7	196.90	10.8									
6+00	207.0	196.60	10.4									
7+00	206.1	196.30	9.8									
8+00	204.7	196.00	8.7									
9+00	205.2	195.70	9.5									
10+00	205.4	195.40	10.0									
11+00	205.9	195.10	10.8									
12+00	205.3	194.80	10.5									
13+00	204.7	194.50	10.2									
14+00	203.8	194.20	9.6									
15+00	202.6	193.90	8.7									
16+00	201.4	193.60	7.8									
17+00	201.2	193.30	7.9									
18+00	201.1	193.00	8.1									
19+00	200.9	192.70	8.2									
20+00	200.5	192.40	8.1									
21+00	197.9	192.10	5.8									
22+00	199.1	191.80	7.3									
23+00	199.8	191.50	8.3									
24+00	199.8	191.20	8.6									
25+00	199.3	190.90	8.4									
26+00	199.0	190.60	8.4									
27+00	198.3	190.30	8.0									
28+00	194.2	190.00	4.2									
29+00	196.0	189.70	6.3									
	196.4	189.56	6.8	29+38 [±]								
30+00	195.2	189.37	5.8									
31+00	197.7	189.07	8.6									
	197.2	189.46	7.7	3+16 [±]								

045378-3718 N. Park Rd. - Initial Inv. - 6-18-74 - Ext + build new M.H.