

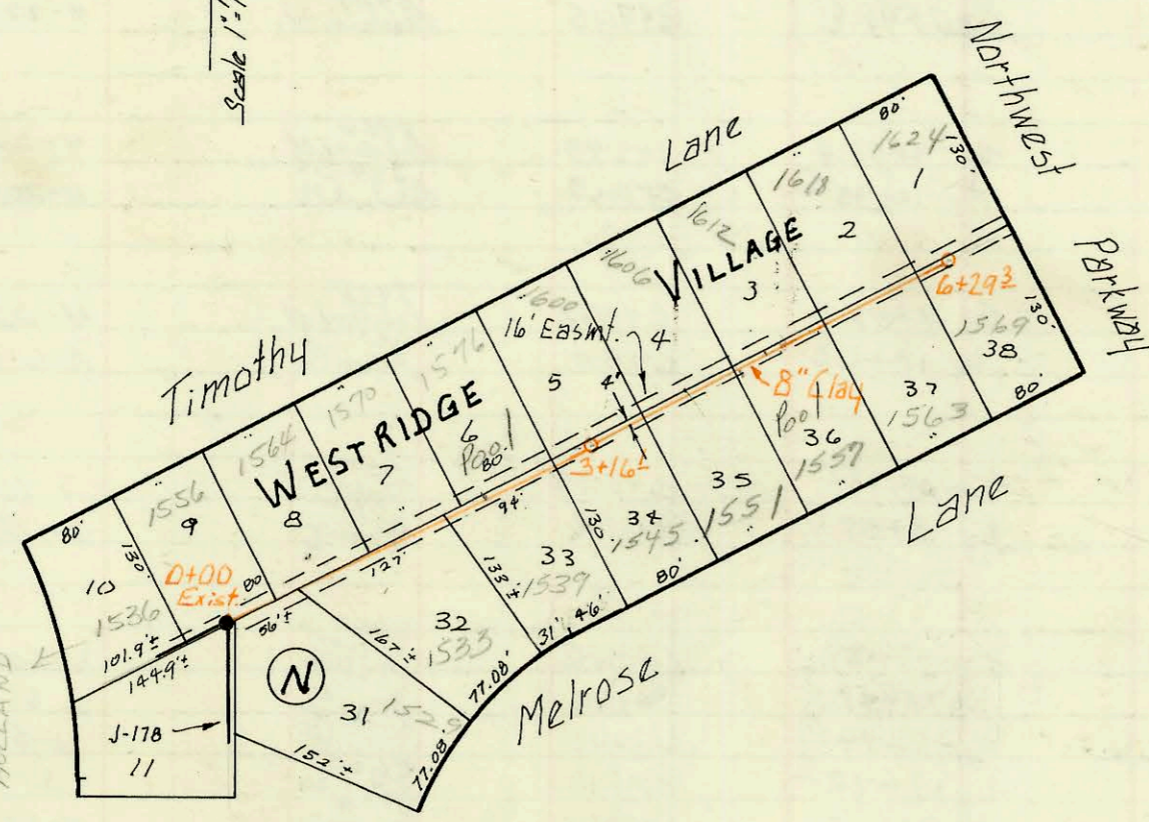
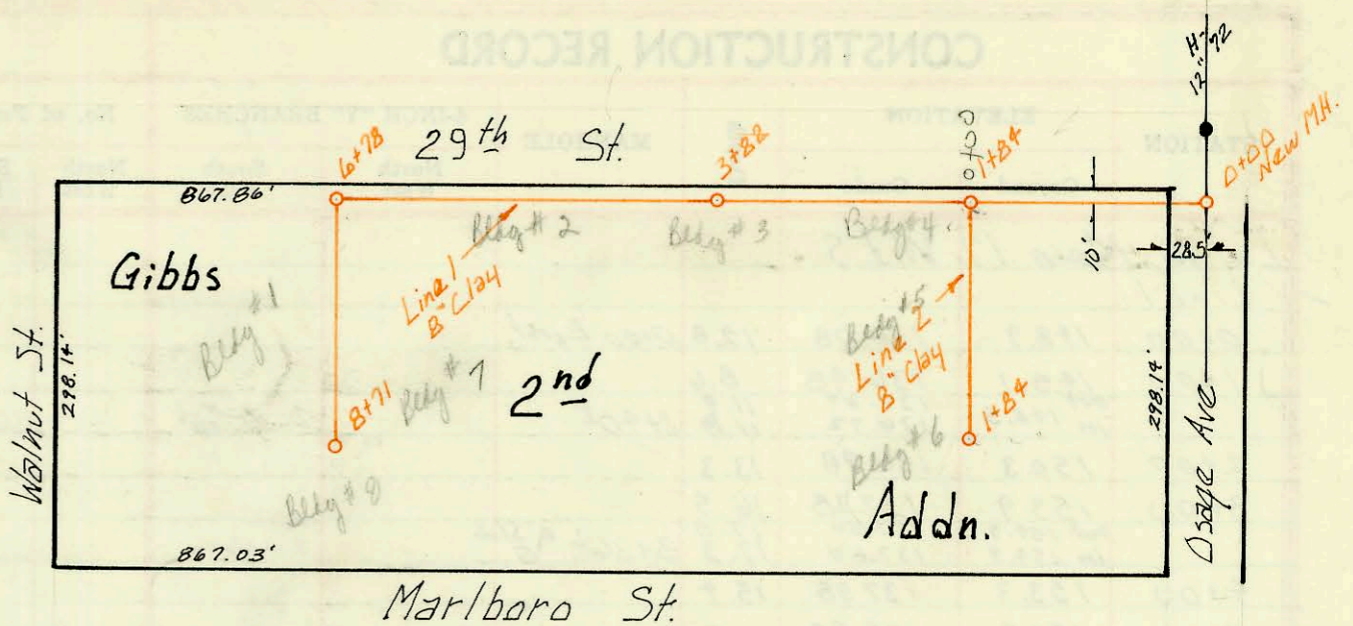


Private San. Sew. - 29th & Osage
 Built by: Mid-States Const. Co.
 Booked 1-31-74 from "As Built" Plan
 Proj. No. BHK503053

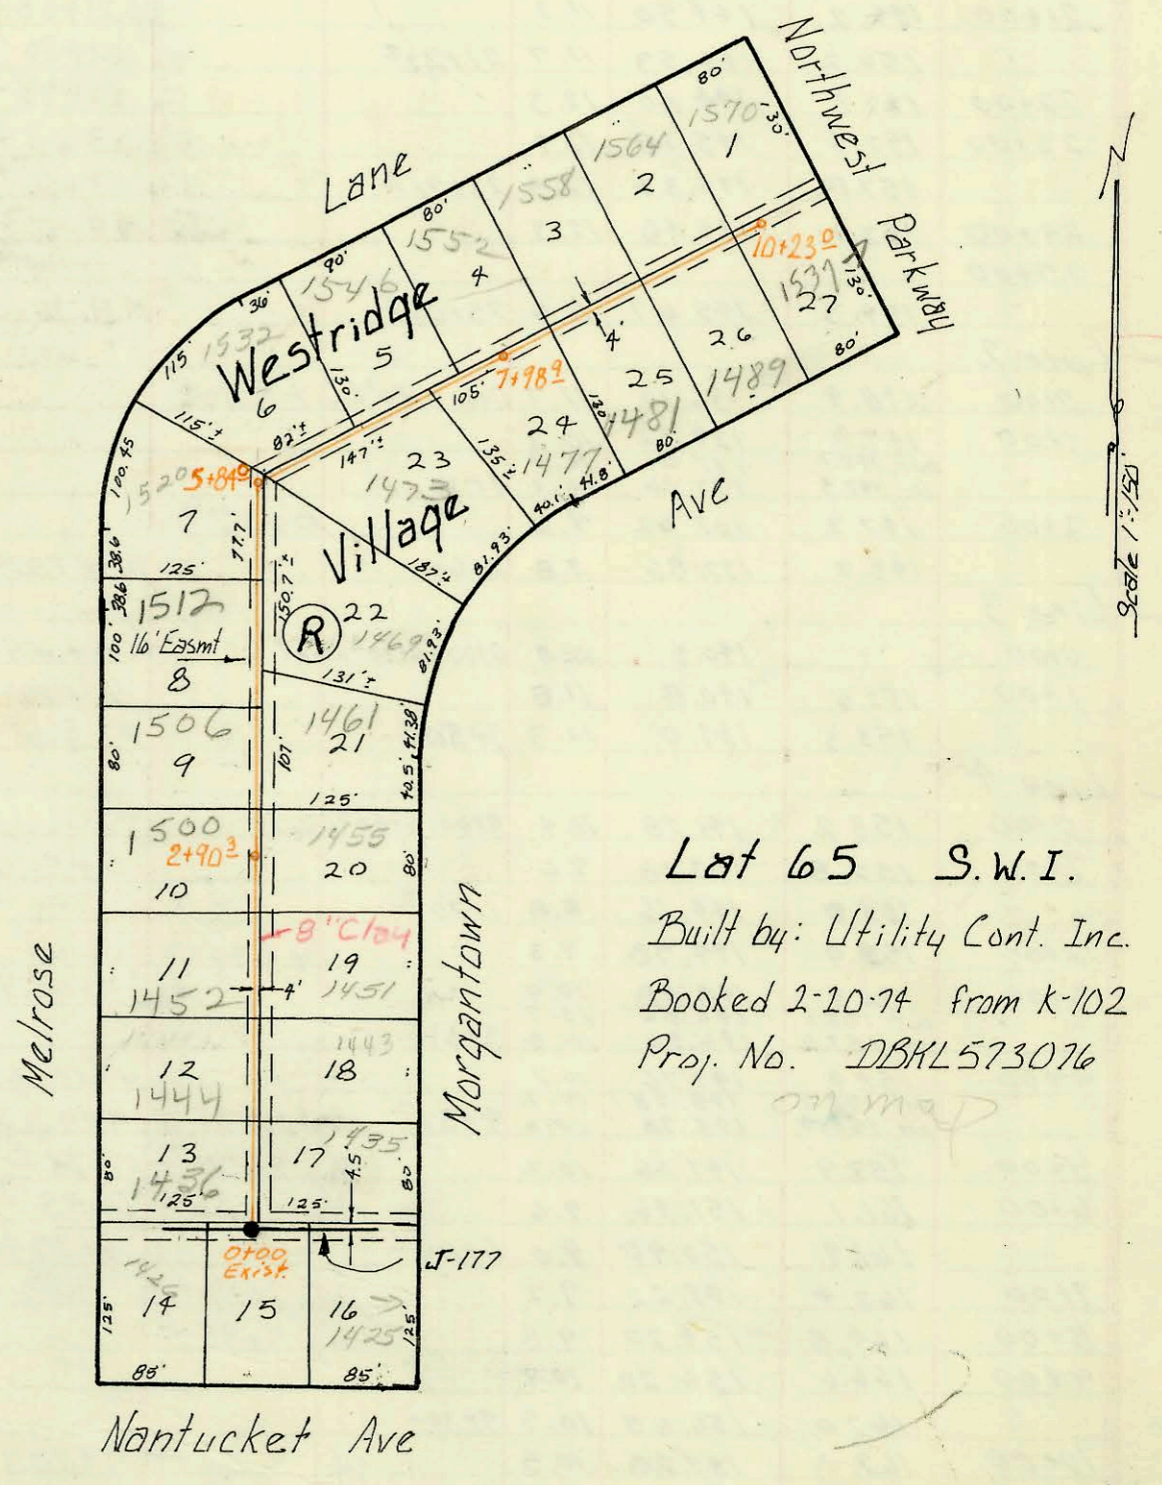

Lat 64 S.W.I.
 Built by: Utility Cont. Inc.
 Booked 2-20-74 from K-102
 Proj. No. DBKL573075
 on map

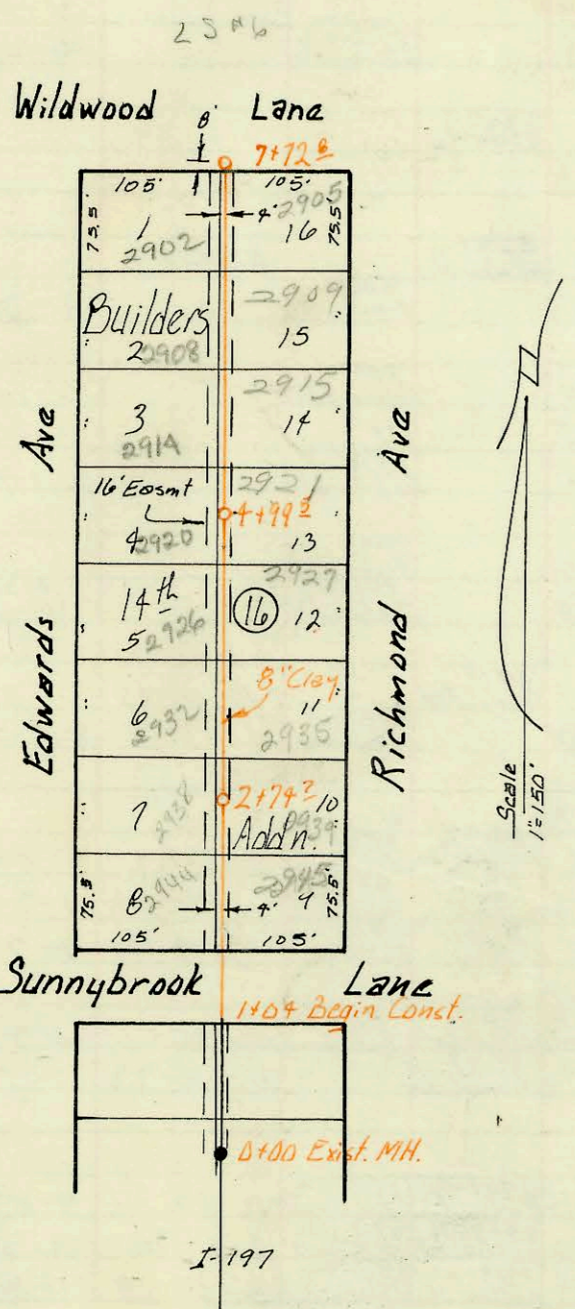

Lat 65 S.W.I.
 Built by: Utility Cont. Inc.
 Booked 2-20-74 from K-102
 Proj. No. DBKL573076
 on map

Lat 105 S.S. 22
 Built by Mid-States Const. Co.
 Booked 3-12-74 from SS #11 JAK
 Proj. No. DBKL568005
 on map

CONSTRUCTION RECORD

SERVICE RECORD

STATION	ELEVATION		Depth	MANHOLE	4-INCH "Y" BRANCHES		No. of Permit		House Number		DATE OF PERMITS	
	Ground	Grade			North West	South East	North West	South East	North West	South East	North West	South East
Private San Sew - 29th & Osage												
0+00	97.6	88.63	9.0	0+00 New MH								
1+00												
2+00	99.0	89.41	9.6	1+84								
3+00												
4+00	99.50	90.51	9.0	3+82								
5+00												
6+00												
7+00	98.7	91.92	6.5	6+78								
8+00												
9+00												
10+00	96.8	93.51	3.3	8+71 6" Line E.								
Line #2												
0+00				0+00 = 1+84 Line 1								
1+00	100.2	96.00	4.2	1+84 6" Sh6 SW.								
Lat 64 S.W.I												
0+00	158.9	148.50	10.4	0+00 Exist								
1+00	158.3	148.70	9.6									
2+00	159.1	148.90	10.2									
3+00	140.4	149.10	11.3									
4+00	159.0	149.13	9.9	3+16 1/2								
5+00	158.4	149.30	9.1									
6+00	156.2	149.50	6.7									
7+00	159.2	149.70	4.5									
8+00	153.8	149.76	4.0	6+29 3/4								
Lat 65 S.W.I.												
0+00	157.5	144.25	10.3	0+00 Exist.								
1+00	156.2	144.45	11.8									
2+00	157.6	144.65	13.0									
3+00	158.9	144.83	14.1	2+90 3/4								
4+00	159.0	144.85	14.2									
5+00	159.5	145.05	14.5									
6+00	159.3	145.25	14.1									
7+00	159.2	145.55	13.6									
8+00	157.9	145.95	11.9	7+98 3/4								
9+00	157.4	146.15	11.2									
10+00	156.0	146.35	9.6									
11+00	155.4	146.40	9.0	10+23 3/4								
Lat 105 SS #22												
0+00				0+00 Exist.								
1+00	98.6	93.76	4.8									
2+00	98.6	93.91	4.7									
3+00	99.0	94.02	5.0	2+74.7								
4+00	100.4	94.06	6.3									
5+00	98.2	94.21	4.0									
6+00	99.0	94.36	4.6	4+99.5								
7+00												
8+00	99.6	94.56	5.0									
9+00	99.3	94.76	4.5									
10+00	99.5	94.91	4.6	7+72.8								

Tap C52959-1564 Timothy - 12/30/75 (0+85.5)
 Tap C56707-1570 Timothy - 7-19-76 (1+41.4)
 Tap C50708-1576 Timothy - 7-19-76 (2+21.4)
 Tap C57340-1624 Timothy - 8-24-76 (6+13.9)