
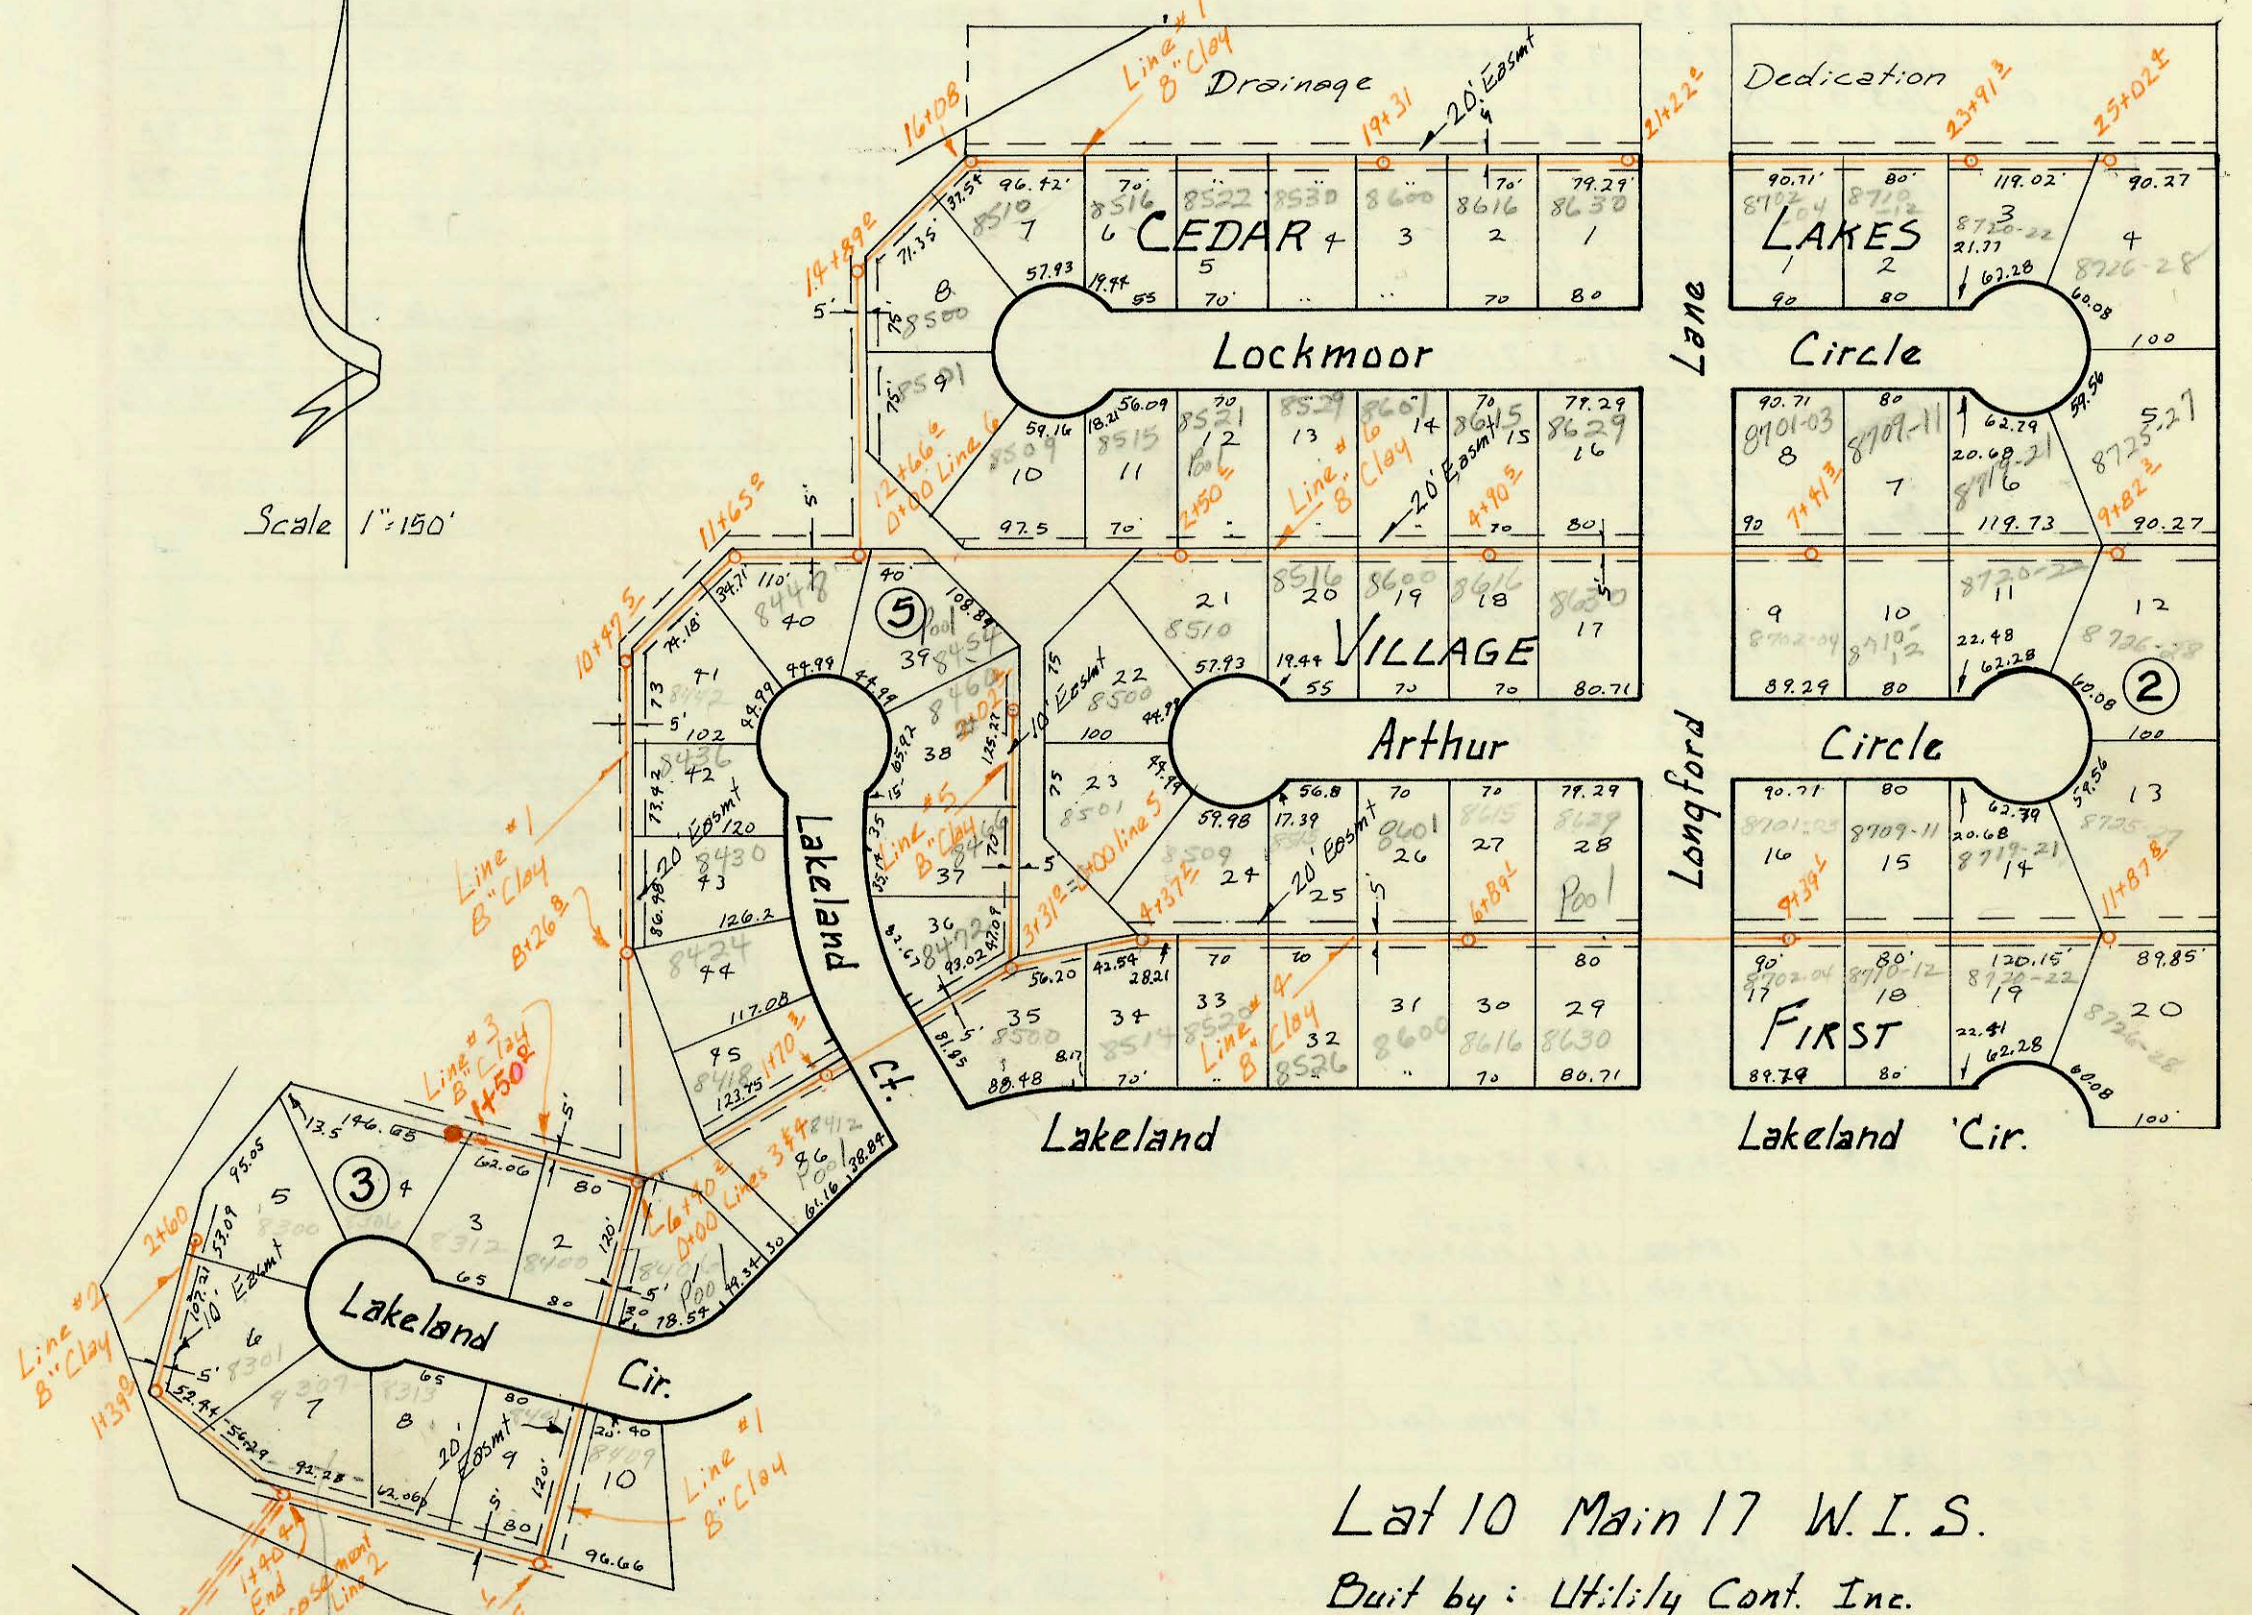


SERVICE RECORD

CONSTRUCTION RECORD

DATE OF SERVICE		DESCRIPTION		NO. OF FEET		ELEVATION		STATION	
Start	End	From	To	Start	End	Start	End	Start	End

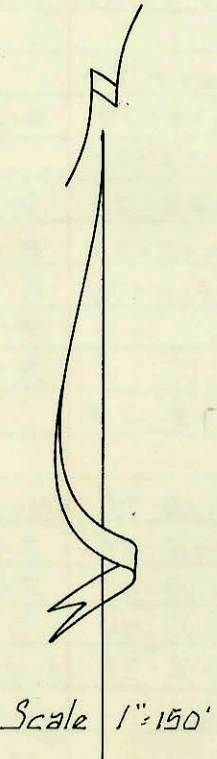

8307 Lakeland
 PA16 Euse.
 Film 3K1
 Page 1027
 Dated 8/5/78
 N. S. of Reak
 15' of Lot 7 BL 3
 TO Lot 8 BL 3
 (8303 Lakeland)

Lat 10 Main 17 W.I.S.
 Built by: Utility Cont. Inc.
 Booked 1-31-74 from 279-Y
 Proj. No. DBKM573043

CONSTRUCTION RECORD						SERVICE RECORD						
STATION	ELEVATION		Depth	MANHOLE	4-INCH "Y" BRANCHES		No. of Permit		House Number		DATE OF PERMITS	
	Ground	Grade			North West	South East	North West	South East	North West	South East	North West	South East
Lat 10, Main 17 W.I.S.												
Line 1												
0+00	148.9	136.08	12.8	0+00 Exist.								
1+00	145.1 out 148.5 in 148.5	136.48 136.67 136.72	8.6 11.9 11.8	1+40 [±]						8313 Fakeland		8-8-78
2+00	150.3	136.98	13.3									
3+00	153.9 out 154.5 in 154.9	137.38 137.50 137.60	16.5 17.0 17.3	3+36 [±] 8" stub E.						8401 Fakeland G.		7-26-77
4+00	153.3	137.88	15.4									
5+00	155.2	138.28	16.9									
6+00	154.1 out 153.1 in 153.1	138.68 138.82 138.92	15.4 14.3 14.2	6+40 [±]								
7+00	151.7	139.15	12.5									
8+00	151.6 out 151.4 in 151.4	139.50 139.55 139.65	12.1 11.8 11.7	8+26 [±]						8424 Fakeland Ct.		4-22-75
9+00	151.6	139.95	11.6									
10+00	150.9 out 150.8 in 150.8	140.30 140.43 140.53	10.6 10.4 10.3	10+47 [±]						8436 Fakeland Ct. 8442 Fakeland Ct.		4-22-75 11-20-74
11+00	152.2 out 153.5 in 153.0	140.75 140.95 141.05	11.4 12.5 12.0	11+65 [±]								
12+00	155.2 out 156.5 in 156.5	141.20 141.40 141.50	14.0 15.1 15.0	12+66 [±]						8448 Fakeland Ct. 8501 Fakeland Ct.		4-22-75 3-6-74
13+00	155.8	141.65	14.1									
14+00	155.0 out 152.7 in 152.6	142.00 142.27 142.37	13.0 10.4 10.2	14+89 [±]						8500 Fakeland Ct. 8518 Fakeland Ct.		3-15-74 3-15-74
15+00	152.1	142.45	9.7									
16+00	151.3 out 151.3 in 151.3	142.79 142.89	8.5 8.4	16+08								
17+00	153.4	143.20	10.2									
18+00	154.2	143.50	10.7									
19+00	155.6 out 155.7 in 155.7	143.80 143.86 143.96	11.8 11.8 11.7	19+31								
20+00	156.0	144.20	11.8									
21+00	156.2	144.50	11.7									
22+00	156.2	144.53	11.7	21+22 [±]								
23+00	157.1	144.80	12.3									
24+00	157.5	145.10	12.4									
25+00	157.8	145.34	12.5	23+91 [±]								
26+00	157.7	145.40	12.3									
27+00	157.3	145.67	11.6	25+02 [±]								
Line 2												
0+00	148.4	136.72	11.7	0+00 = 1490 [±] Line 1 MH Tap								
1+00	147.4 out 148.1 in 147.5	137.12 137.26 137.36	10.3 10.8 10.1	1+39								
2+00	147.2 145.7	137.62 137.86	9.6 7.8	2+17 [±] 2+60						8301 Fakeland 8300 Fakeland		8-7-79 4-24-79
Line 3												
0+00		140.4	#8	0+00 = 6+40 [±] Line 1								
1+00	152.6	140.8	11.8									
2+00	153.3	141.0	12.3	1+50 [±]								
Line 4												
0+00	153.2	141.78	11.4	0+00 = 6+40 [±] Line 1								
1+00	152.8	143.18	9.6									
2+00	153.0	144.16	8.8	1+70 [±]								
3+00	153.9	144.58	9.3									
4+00	156.9 out 157.1 in 157.0	145.98 146.40 146.50	10.9 10.7 10.5	3+31 [±]								
5+00	157.9 out 158.5 in 158.4	147.76 148.28 148.38	10.1 10.2 10.0	4+37 [±]								
6+00	159.9	149.66	10.2									
7+00	161.1	151.46	9.6									
8+00	161.9	152.90	9.0	6+89 [±]								
9+00	162.4	153.20	9.2									
10+00	164.5	154.70	9.8									
11+00	166.6	156.20	10.4									
12+00	167.0	156.65	10.3	9+39 [±]								
13+00	167.8	157.28	10.5									
14+00	168.3	158.18	10.1									
15+00	168.3	158.90	9.4	11+87 [±]								
Continued on page 17-216												

C49139 - 8466 Lakeland Ct. - 4-22-75 (0+79)