




Private San. Sew. for  
 South Lake Addition  
 Built by Utility Cont. Inc.  
 Booked 3-18-74 from "As Built" Plan  
 Proj. No. BHK503055  
 on map

A B D A  
 C D C B

Force Main for Leisure Living  
 1st Addn (The Heritage)  
 Built by Utility Cont. Inc.  
 Booked 3-20-74 from Plan  
 Proj. No. BHK503006  
 on map

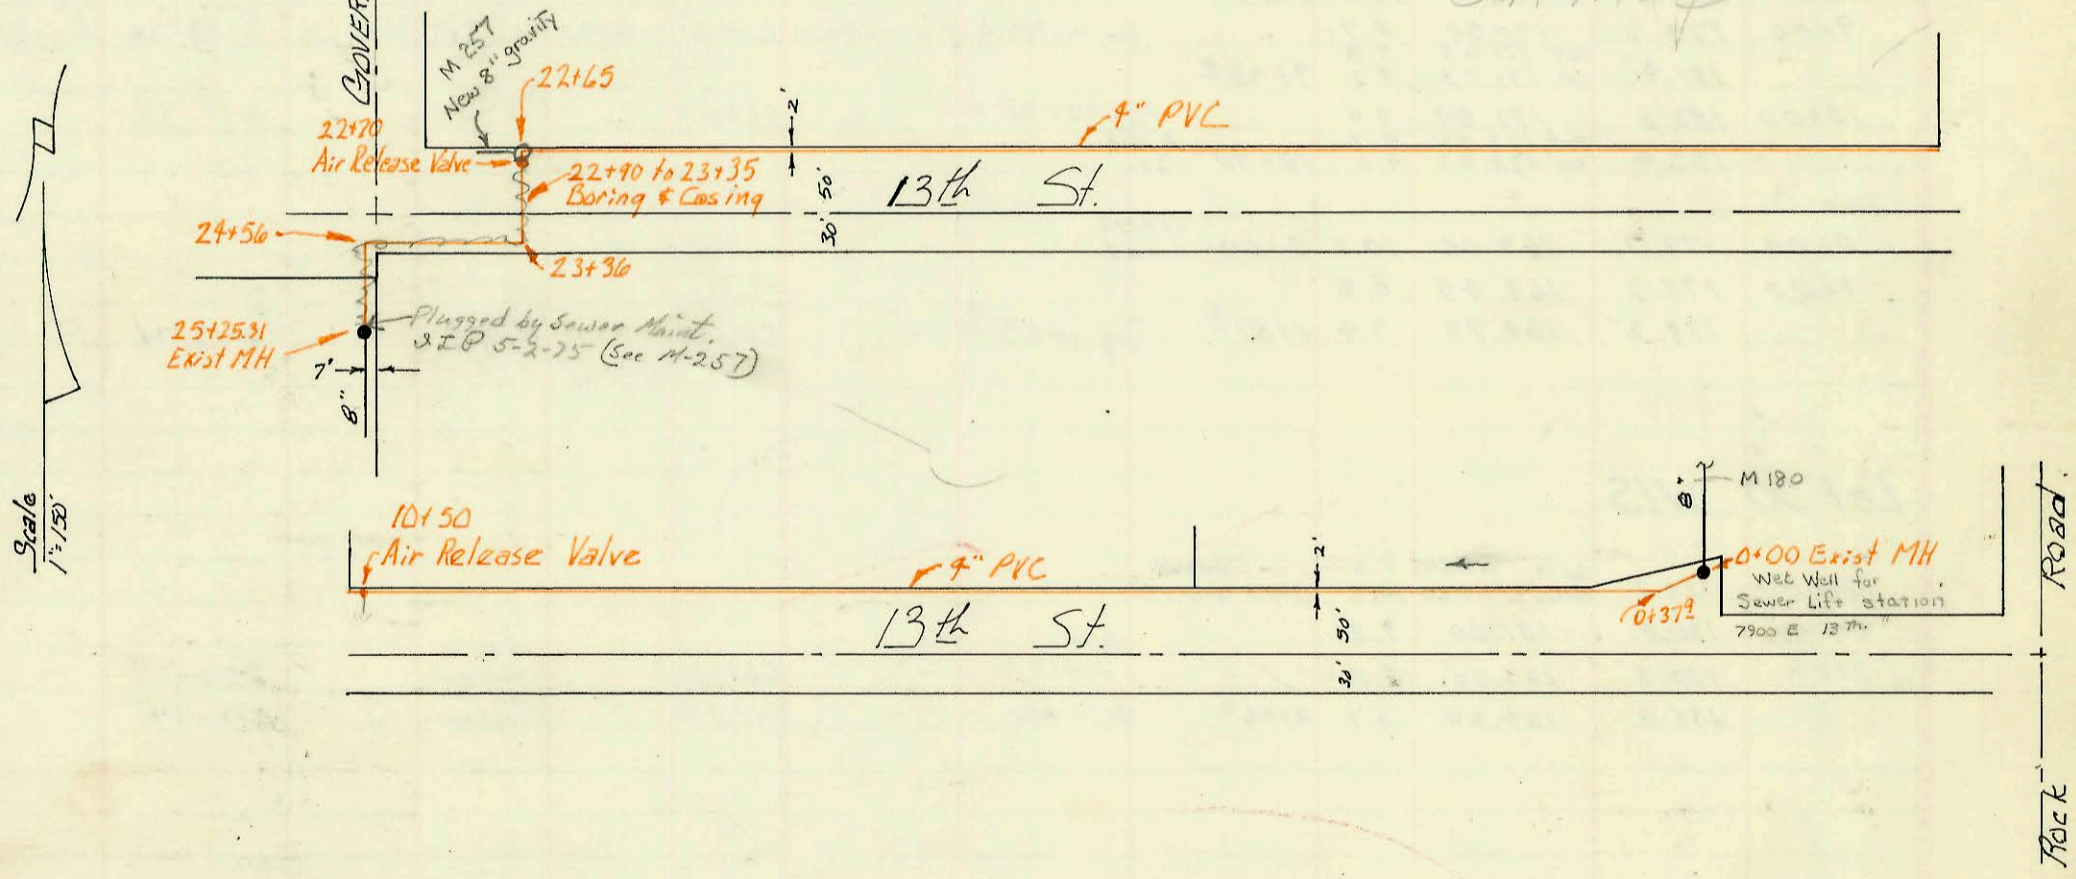

Lat 5, Sub. 14 W.I.S.  
 Built by Utility Cont. Inc.  
 Booked 4-1-74 from 273-Y  
 Proj. No. DBKL570057  
 on map

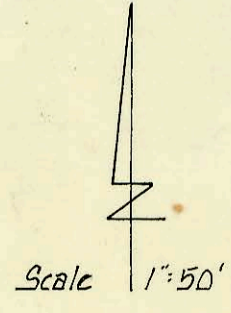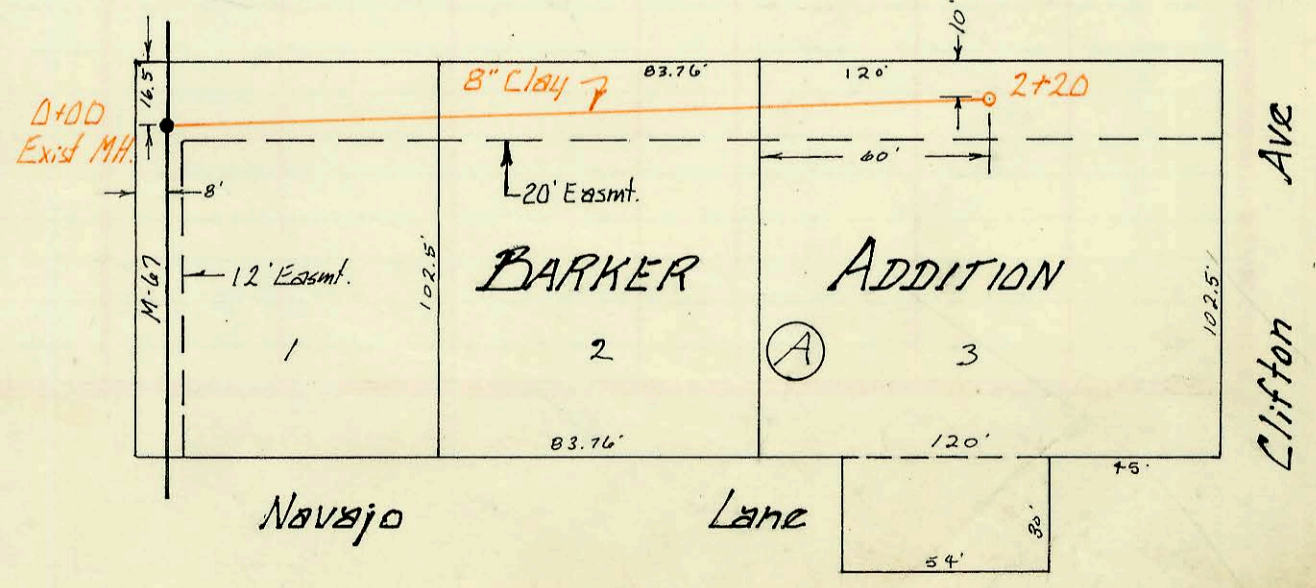

CONSTRUCTION RECORD						SERVICE RECORD						
STATION	ELEVATION		Depth	MANHOLE	4-INCH "Y" BRANCHES		No. of Permit		House Number		DATE OF PERMITS	
	Ground	Grade			North West	South East	North West	South East	North West	South East	North West	South East
<i>Private Sew. Sew. South Lake Addn.</i>												
<i>Line 1</i>												
0+00	88.9	81.75	7.1	0+00 Exist		0+44 6" P South		C46440		4141 S. Seneca Bldg 12		8-30-74
1+00	91.8	out 82.55 in 82.65	9.2 9.1	1+34 6" stubs N+SW		SW stub		C46439		4141 S. Seneca Bldg 11		8-30-74
2+00												
3+00												
	88.0	83.95	4.0	3+65 E								
4+00												
5+00												
6+00	90.5	out 84.77 in 84.87	5.7 5.6	6+42 2-6" stubs W				C44287 C44288		4141 S. Seneca Bldg 5 4141 S. Seneca Bldg 6		4/3/74 4-3-74
7+00												
8+00						6" E. 8+89						
9+00	90.5	85.86	4.6	9+72 E								
<i>Line 2</i>												
0+00	89.8	82.57	7.2	0+00 Exist								
1+00	88.5	out 84.10 in 84.20	4.4 4.3	1+91 6" stubs N+SW				C44142 C44143		4141 S. Seneca Bldg 5 4141 S. Seneca Bldg 6		3-26-74 3-26-74
2+00												
3+00												
4+00	88.5	85.13	3.4	4+23 6" stubs SW				C44145 C44144		4141 S. Seneca Bldg 4 4141 S. Seneca Bldg 3		3-26-74 3-26-74
<i>Force Main for Leisure Living 1st Addn. (The Heritage)</i>												
0+00	191.0	187.00	4.0									
1+00	191.6	188.00	3.6									
2+00	193.1	189.00	4.1									
3+00	194.6	190.00	4.6									
4+00	196.0	191.10	4.9									
5+00	196.8	192.20	4.6									
6+00	197.8	193.25	4.5									
7+00	198.7	194.30	4.4									
8+00	199.5	194.90	4.6									
9+00	200.6	195.1	5.5									
10+00	201.5	195.3	6.2									
	201.4	195.4	6.0	10+50 Air Release Valve								
11+00	201.3	194.5	6.8									
12+00	199.9	192.8	7.1									
13+00	197.3	191.0	6.3									
14+00	195.5	189.3	6.2									
15+00	193.5	187.6	5.9									
16+00	192.0	185.8	6.2									
17+00	191.7	184.0	7.7									
18+00	191.3	184.9	6.4									
19+00	192.8	186.8	6.0									
20+00	194.3	188.7	5.6									
21+00	195.9	190.6	5.3									
22+00	197.0	192.6	4.4									
	198.0	194.0	4.0	22+70 Air Release Valve								
23+00	197.8	193.6	4.2									
24+00	197.6	192.3	5.3									
25+00	197.0	192.6	4.4									
	196.6	in 192.7 out 184.19	3.9 10.4	25+25 3" Exist MH								
<i>Lot 5 Sub 14 WIS</i>												
0+00	132.6	122.33	10.3	0+00 Exist								
1+00	133.9	122.73	11.2			top 1+70.0		C44097		3253 S. Clifton		3-22-74
2+00	134.2	123.13	11.1									
	134.3	123.21	11.1	2+20								

C 44586 - 4141 S Seneca Bldg 9 4-23-74 James Morris (MH Stub)  
 C 44587 - 4141 S Seneca Bldg 10 4-23-74 " " (MH Stub)  
 C 44761 - 4141 S Seneca - Cent Haus 5-6-74 " " (avg 146.6 S. of MH # 2)  
 C 46620 - " " " 7 9-12-74 " MH Stub 6+42.0  
 C 46621 - " " " 8 9-12-74 " " "