


LAT 1 MAIN 6 SS #23
BUILT BY UTILITY CONT INC.
BOOKED 5-16-74 FROM 1H-76 & 1H-81
PROJ No DBKL572070

O.N. map

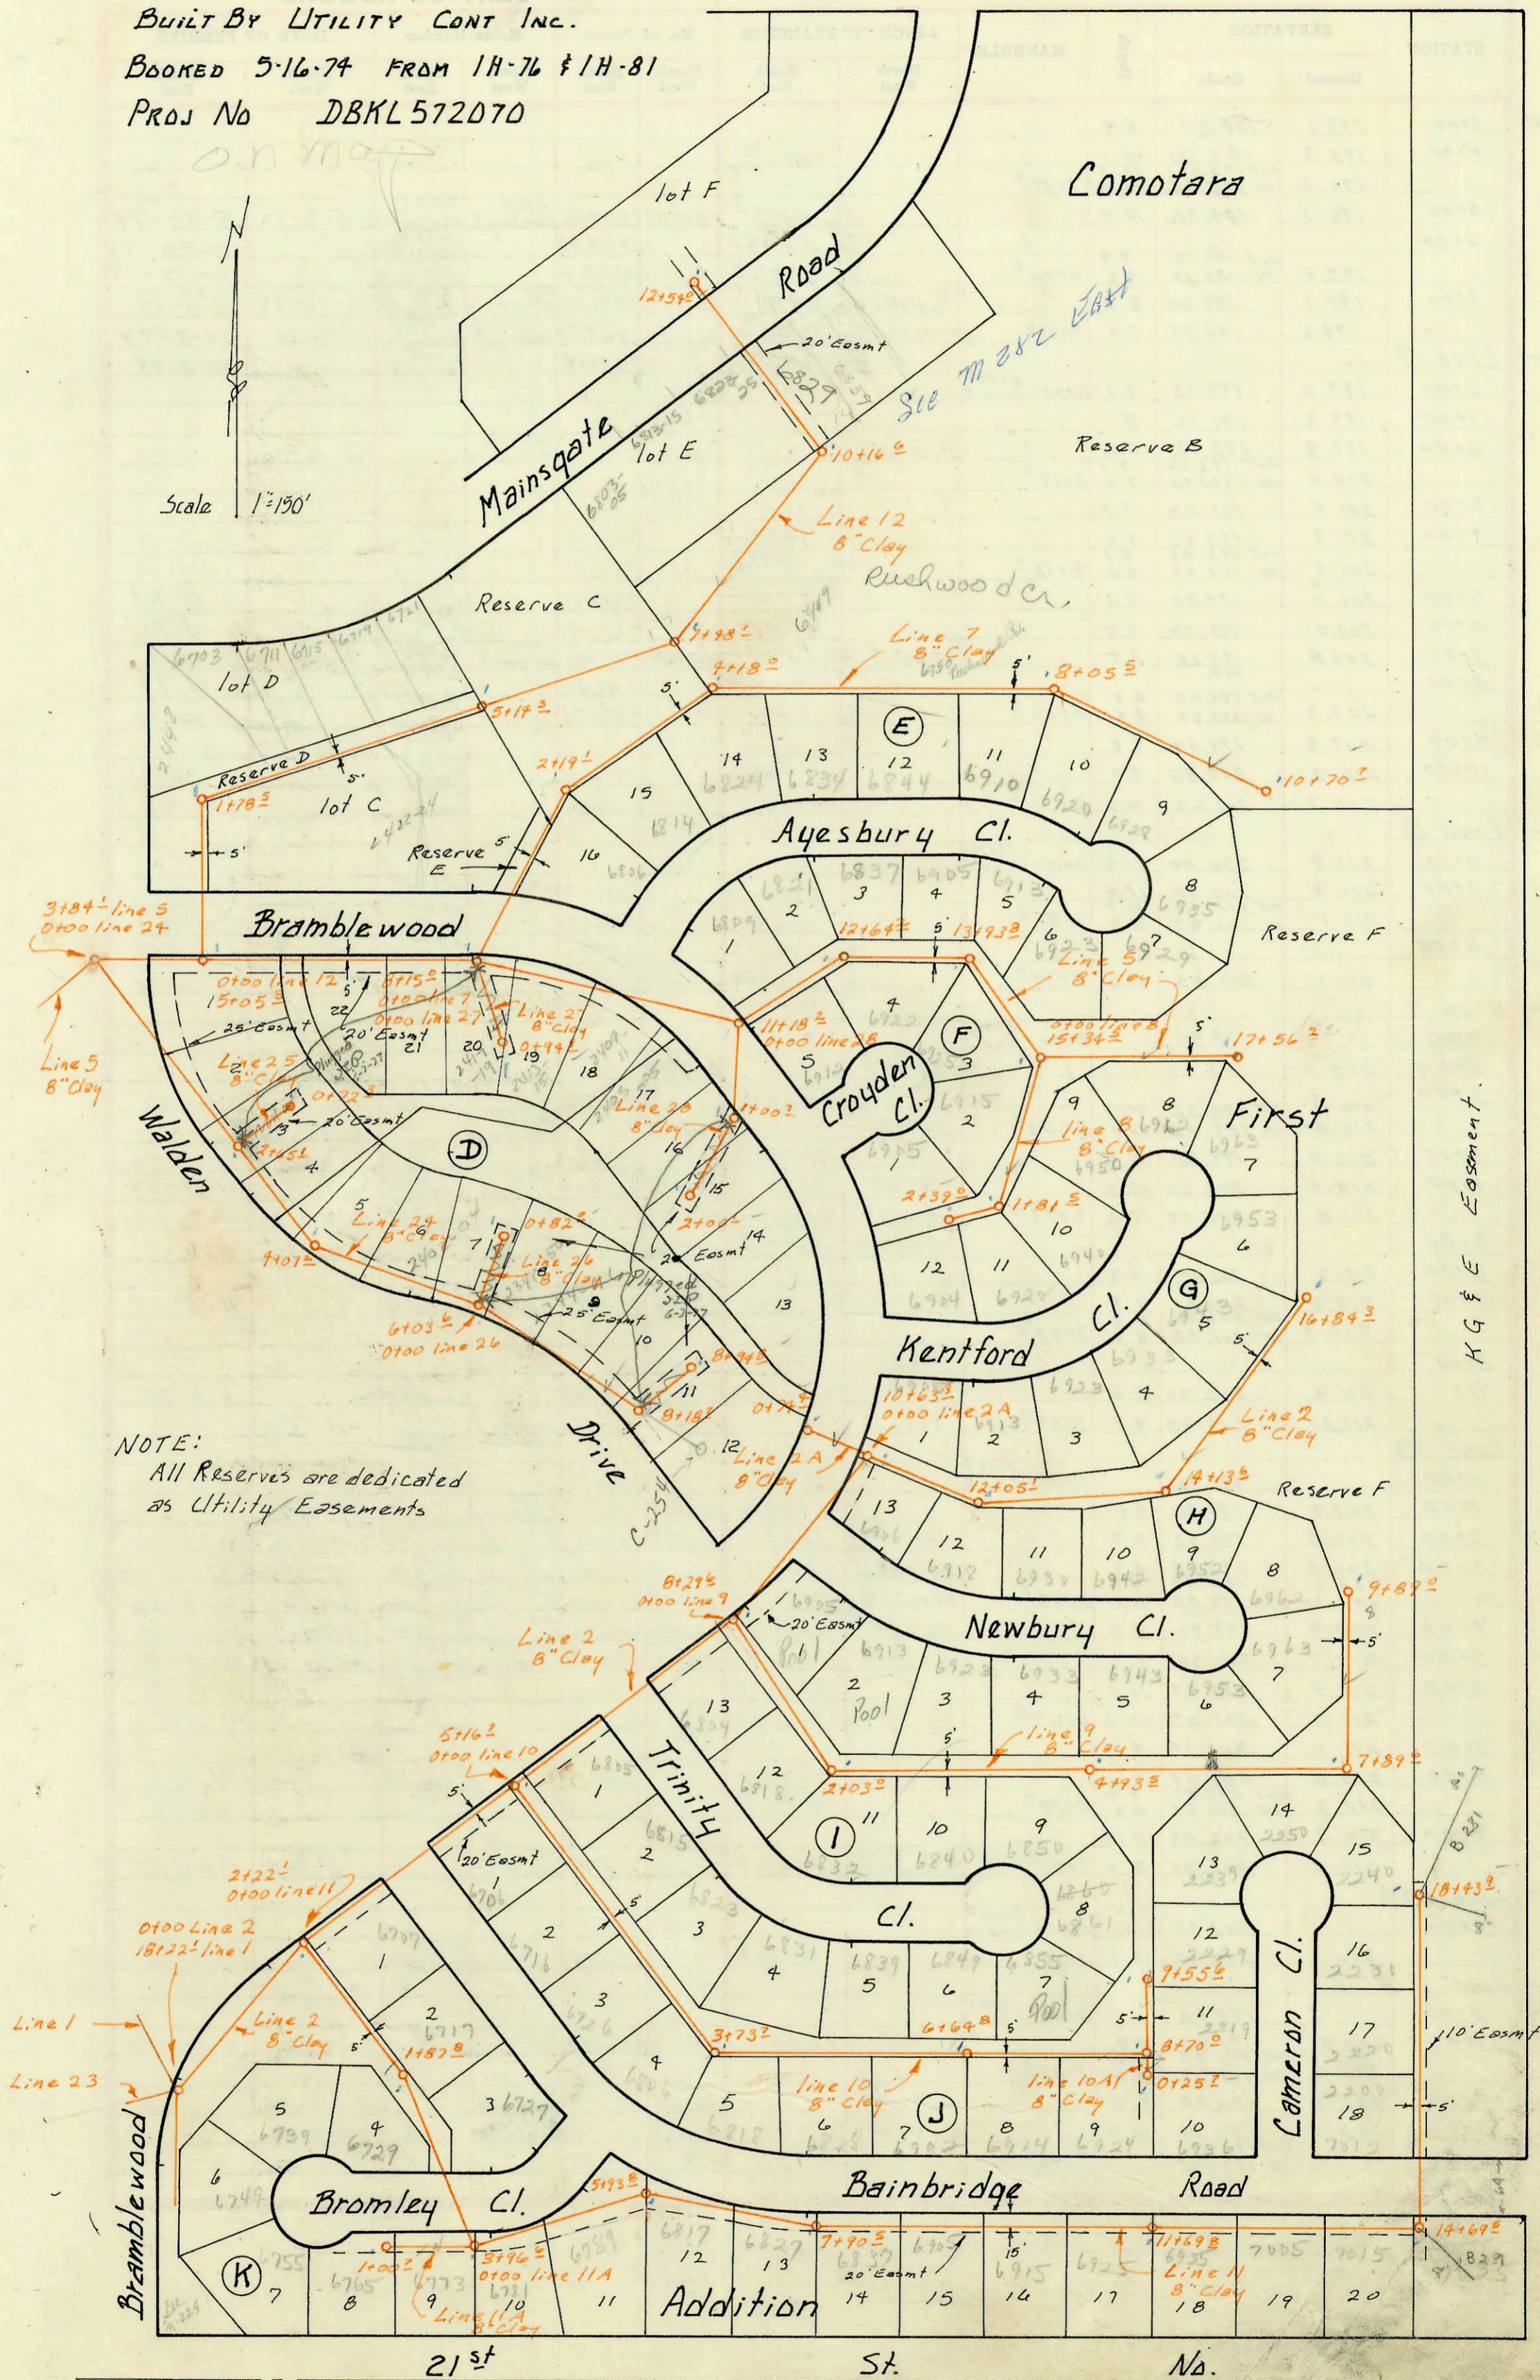

NOTE:
All Reserves are dedicated
as Utility Easements

H G & E Easement.

21st St. No.

CONSTRUCTION RECORD

SERVICE RECORD

STATION	ELEVATION		Depth	MANHOLE	4-INCH "Y" BRANCHES		No. of Permit		House Number		DATE OF PERMITS	
	Ground	Grade			North West	South East	North West	South East	North West	South East	North West	South East
5+00	205.5	193.82	11.7			4+23.0		C61302		6781		5-26-77
	206.9	194.42	12.5			5+60.8		C51985		6782		10-17-75
6+00		194.52	12.4	5+93 ⁸		5+92.8		C51984		6817		10-17-75
7+00	208.5	195.20	13.3			7+25.7		C51609		6827		9-30-75
	209.6	195.70	13.9	7+90 ⁵		8+56.2		C51608		6837		9-30-75
8+00	209.8	195.94	13.9			8+98.1		C53464		6705		1-22-76
9+00	210.5	196.50	14.0			10+56.8		C54535		6915		3-30-76
10+00	210.2	197.06	13.1									
11+00	209.5	197.62	11.9			10+99.8		C54018		6925		3/2/76
	209.7	198.00	11.7	11+69 ²		12+36.2		C54387		6925		3-24-76
12+00	208.8	198.18	10.6									
13+00	208.3	198.74	9.6			13+32.4		C59849		7005		4-9-77
14+00	207.8	199.30	8.5			14+13.5		C57634		7015		9-10-76
	208.0	199.68	8.3	14+69 ⁵		14+17.5		C52308		2200		11-4-75
15+00	208.1	199.91	8.2			16+98.9		C52310		2220		11-4-75
16+00	208.5	200.31	8.2									
17+00	208.8	200.71	8.1			18+12.5		C52311		2230		11-4-75
18+00	209.4	201.11	8.3									
	209.7	201.27	8.4	18+43 ²		Stub N.W.		C52311		2240		11-4-75
LINE 11A												
0+00	203.7	193.95	9.7	0+00 = 3+96 ⁰ line 11		0+11.5		C51561		6793		9-7-76
1+00		194.35	6.6	1+00 = 1		0+95.8		C56131		6765		6-25-76
LINE 12												
0+00	195.1	180.80	14.3	0+00 = 5+05 ² line 5								
1+00	196.0	181.22	14.8			2+26.5		C52950		6703		9-10-76
	197.2	181.53	15.7	1+78 ⁵		3+08.0		C59631		2426-30		12-29-75
2+00	197.3	181.65	15.7			3+02.5		C54951		2434-38		9-10-76
3+00	198.2	182.05	16.2			4+32.3		C57632		6711		12-29-75
4+00	199.0	182.45	16.0					C52952		6715		9-10-76
5+00	199.8	182.85	17.0			4+04.3		C44937		2422-24		12-29-75
	199.9	182.90	17.0	5+14 ³						6715		6-20-73
6+00	200.8	183.25	17.5									
7+00	201.0	183.65	17.3									
	201.0	183.83	17.2	7+48 ¹								
8+00	200.6	184.08	16.5									
9+00	199.0	184.48	14.5			7+79.1		C66438		6803-05		5-17-78
10+00	199.3	184.88	14.4			9+26.6		C67101		6803-11		6-27-78
	199.1	184.95	14.1	10+16 ⁶		10+84.6		C69671		6823-25		12-4-78
	199.0	184.97	14.0							6823-25		
11+00	197.6	185.30	12.3									
12+00	196.7	185.70	14.0									
	195.8	185.91	9.9	12+54 ⁰								
LINE 13												
0+00	189.8	180.74	9.1	0+00 = 6+24 ¹ line 1								
1+00	192.2	181.14	11.1									
	191.6	181.22	10.4	1+20 ¹								
LINE 14												
0+00	191.1	180.50	10.6	0+00 = 10+53 ³ line 1								
1+00	191.4	180.90	10.5									
	193.8	181.22	12.7	1+55 ⁰								
2+00	194.5	182.37	12.1									
3+00	195.3	184.93	10.4									
	195.9	186.98	8.9	3+81 ²								
4+00	196.1	187.08	8.8									
5+00	197.3	187.56	9.7			5+96.8		C71587		2403 Walden Bldg 50102		5-2-79
6+00	198.6	187.96	10.6			6+25.8		C71413		2251 Walden Bldg 50101		3-29-79
	198.8	188.02	10.7	6+16 ⁸		6+83.8		C71581		2403 Walden Bldg 50102		5-2-79
7+00	199.4	189.07	10.3			7+32.1		C70990		2251 Walden Bldg 50101		3-29-79
	200.0	190.02	10.0	7+87 ²								
LINE 15												
0+00		181.22		0+00 = 1+55 ⁰ line 14		0+83.6		98-15140-9		2400 Walden Bldg 50102		8-14-80
1+00	194.9	181.62	13.3					808		2417 Walden Bldg 50102		
2+00	193.4	182.02	11.4			2+30.8		800809		2417 Walden Bldg 50102		7-21-80
	193.2	182.34	10.9	2+80 ⁴				810		2417 Walden Bldg 50102		7-21-80
3+00	193.2	182.52	10.7			3+43.4						
	194.2	182.72	11.5	3+50 ⁴								
LINE 16												
0+00		187.08		0+00 = 3+81 ² line 14		0+75.0		800809		2417 Walden Bldg 50102		7-21-80
1+00	196.7	188.08	8.6			1+51.7		800806		2417 Walden Bldg 50102		5-2-79
	197.2	188.53	8.7	1+43 ²		1+23.1		C71582		2417 Walden Bldg 50102		7-21-80

line 11 Cont.

