

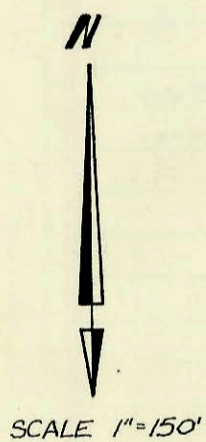


**SANITARY SEWER TO SERVE  
LOTS 3 & 4, BUBLITZ ADDITION**  
 BUILT BY MID-STATES CONST. Co., INC.  
 BOOKED 6-13-74 BOOKED FROM PLAN  
 PRIVATE PROJECT DBKW704032

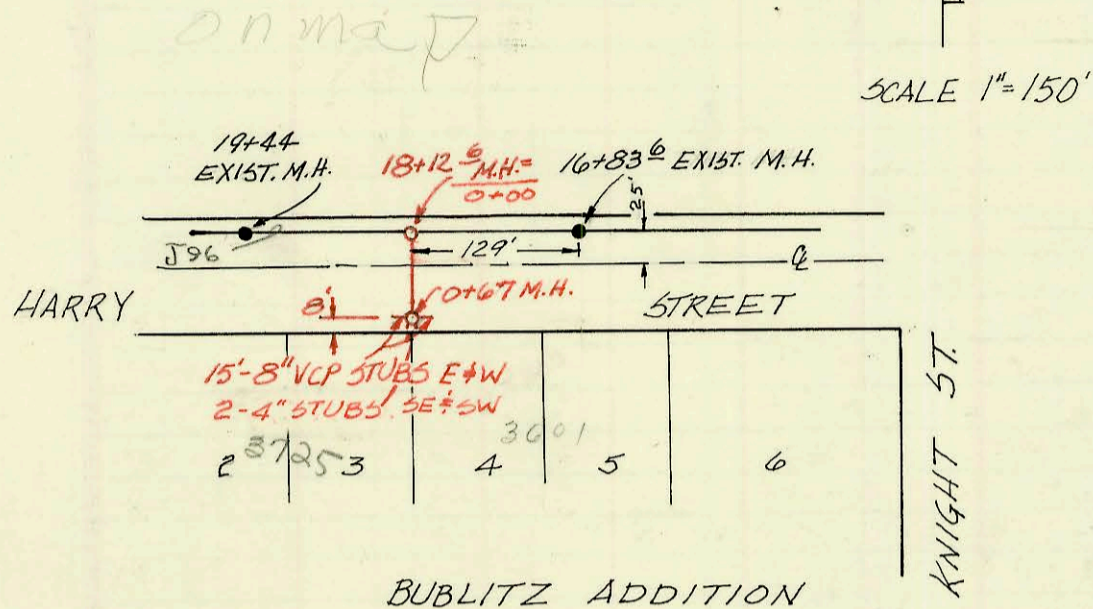

**SANITARY SEWER TO SERVE  
WOODGATE APTS.**  
 BUILT BY MID-STATES CONST.  
 BOOKED 7-25-74 FROM PLAN  
 PRIVATE PROJECT AAKB502061

ON MAP  
5340

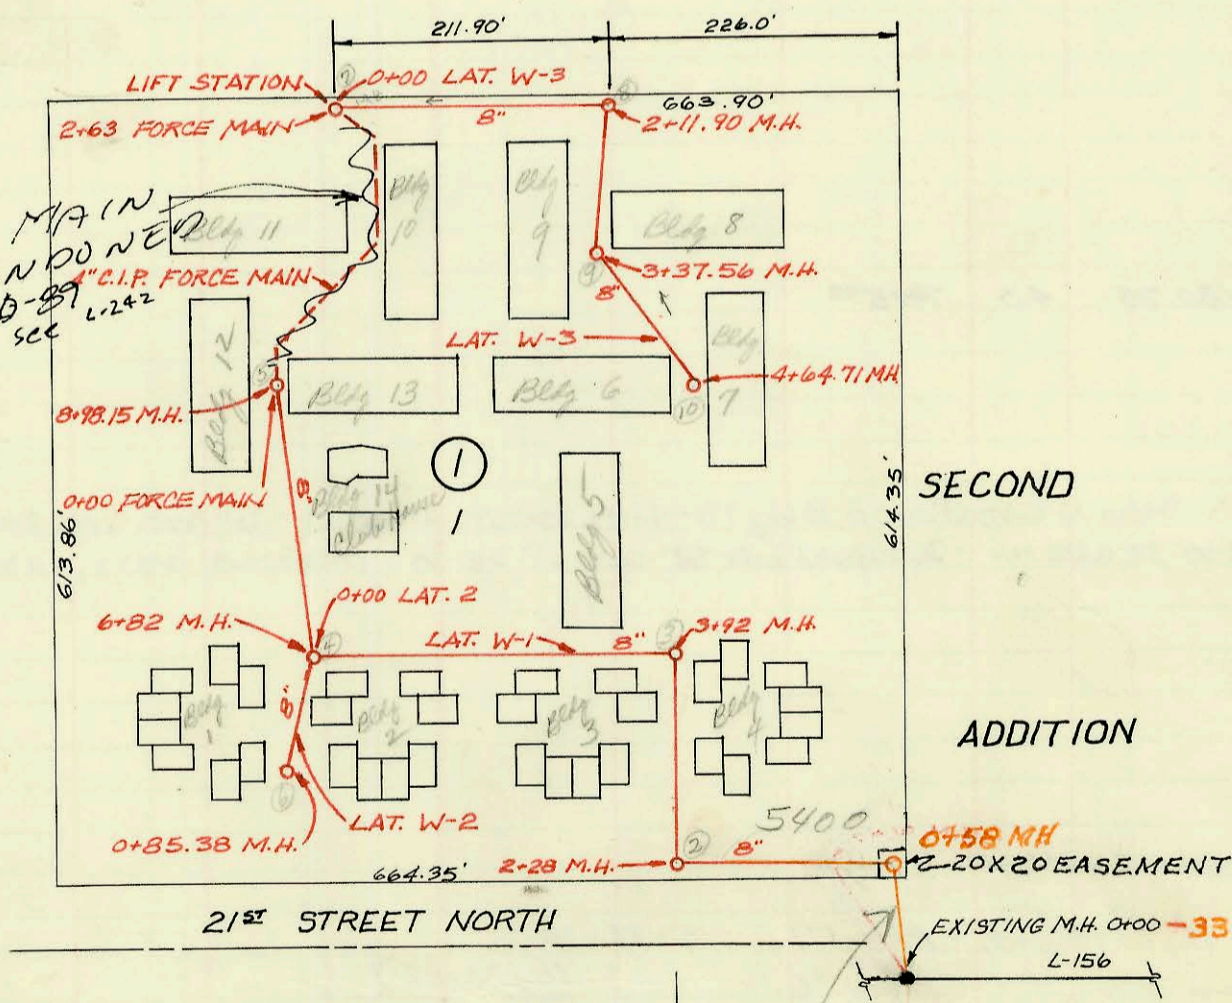

Line reworked with 21st, Oliver to  
 Woodlawn project (A72-84235)  
 released 9/10/06. See attached plan sheets.  
 JDL

CONSTRUCTION RECORD						SERVICE RECORD						
STATION	ELEVATION		Depth	MANHOLE	4-INCH "Y" BRANCHES		No. of Permit		House Number		DATE OF PERMITS	
	Ground	Grade			North West	South East	North West	South East	North West	South East	North West	South East
<b>SANITARY SEWER TO SERVE LOTS 3 &amp; 4 BUBLITZ ADDITION</b>												
0+00	108.9	102.18	6.1									
	108.7	102.92	5.8	0+67	Begin 184126 Exst.	4" Stub SE	C45349		3601 W. Harry			6-14-74
<b>SANITARY SEWER TO SERVE WOODGATE APTS. - 5400 E. 21<sup>st</sup> St.</b>												
LATERAL W-1		IN 202.00	6.9									
0+53	208.9	OUT 201.84	7.1	0+33	EXISTING M.H.							
1+00	210.0	202.35	7.6									
	210.0	IN 202.48	7.8									
		OUT 202.34	7.9	0+58.00								
2+00	212.0	202.80	9.2									
	212.7	IN 203.00	9.7									
		OUT 202.90	9.8	2+28.00								
3+00	211.5	203.25	8.2									
	210.9	IN 203.67	7.2									
		OUT 203.57	7.3	3+92.00								
4+00	210.3	203.70	6.6									
5+00	213.2	204.10	9.1									
6+00	214.5	204.50	10.0									
	215.2	IN 204.98	10.2									
		OUT 204.83	10.4	6+82.00								
7+00	215.2	205.05	10.2									
8+00	212.5	205.42	7.1									
	210.6	205.79	4.8	8+98.15	Top 8+81.5	Top 8+88	C42800	C42788	Bldg. 12	Bldg. 1	12-17-73	12-17-73
					Top 8+94.1		C42801		Bldg. 13			12-17-73
					Top 3+08		C42793		Bldg. 4			12-17-73
					Top 3+86.2		C42794		Bldg. 4			12-17-73
					Top 4+22		C42792		Bldg. 3			12-17-73
					Top 4+42		C42795		Bldg. 5			12-17-73
					Top 4+96.4		C42791	(Club House)	Bldg. 3			12-17-73
					Top 5+88	Top 5+82	C42790	Bldg. 14	Bldg. 2	12-17-73	12-17-73	12-17-73
					Top 6+62.1		C42789		Bldg. 2			12-17-73
					Top 8+81.5	Top 8+88	C42800	C42788	Bldg. 12	Bldg. 1	12-17-73	12-17-73
					Top 8+94.1		C42801		Bldg. 13			12-17-73
<b>LATERAL W-2</b>												
0+00	215.2	204.93	10.3	0+00	(6+82 LAT. W-1)							
	217.0	205.44	11.6	0+85.38	Top 0+80.38		C42787		Bldg. 1			12-17-73
<b>FORCE MAIN</b>												
0+00	206.0	201.00	5.0	0+00	(0+00 LAT W-3) M.H. Top							
1+00	207.4	202.76	4.6		LIFT STATION							
2+00	209.0	204.52	4.5									
	210.6	206.24	4.4	2+63.00								
<b>LATERAL W-3</b>												
0+00	206.0	198.91	7.1	0+00	(0+00 FORCE MAIN)							
1+00	204.5	199.31	5.2									
2+00	203.5	199.71	3.8									
	204.1	IN 199.86	4.2									
		OUT 199.76	4.3	2+11.90								
3+00	206.0	201.45	4.6									
	207.8	IN 202.24	5.6									
		OUT 202.14	5.7	3+37.56								
4+00	210.2	202.90	7.3									
	209.0	203.60	5.4	4+64.71	Top 4+56.9	M.H. Top	C42796		Bldg. 6			12-17-73
							C42797		Bldg. 7			12-17-73