

SERVICE RECORD

ACTION RECORD

Note


Lines serving Chisholm Creek are privately owned & maintained even though located in areas designated as public easement per Law Dept memo dated 9-21-82

SANITARY SEWER TO SERVE CHISHOLM CREEK BUILT BY W.B. CARTER BOOKED 6-19-74 FROM PLAN PRIVATE PROJECT DBKW703048 ON MAP

3700 W Woodlawn



SCALE 1"=100'

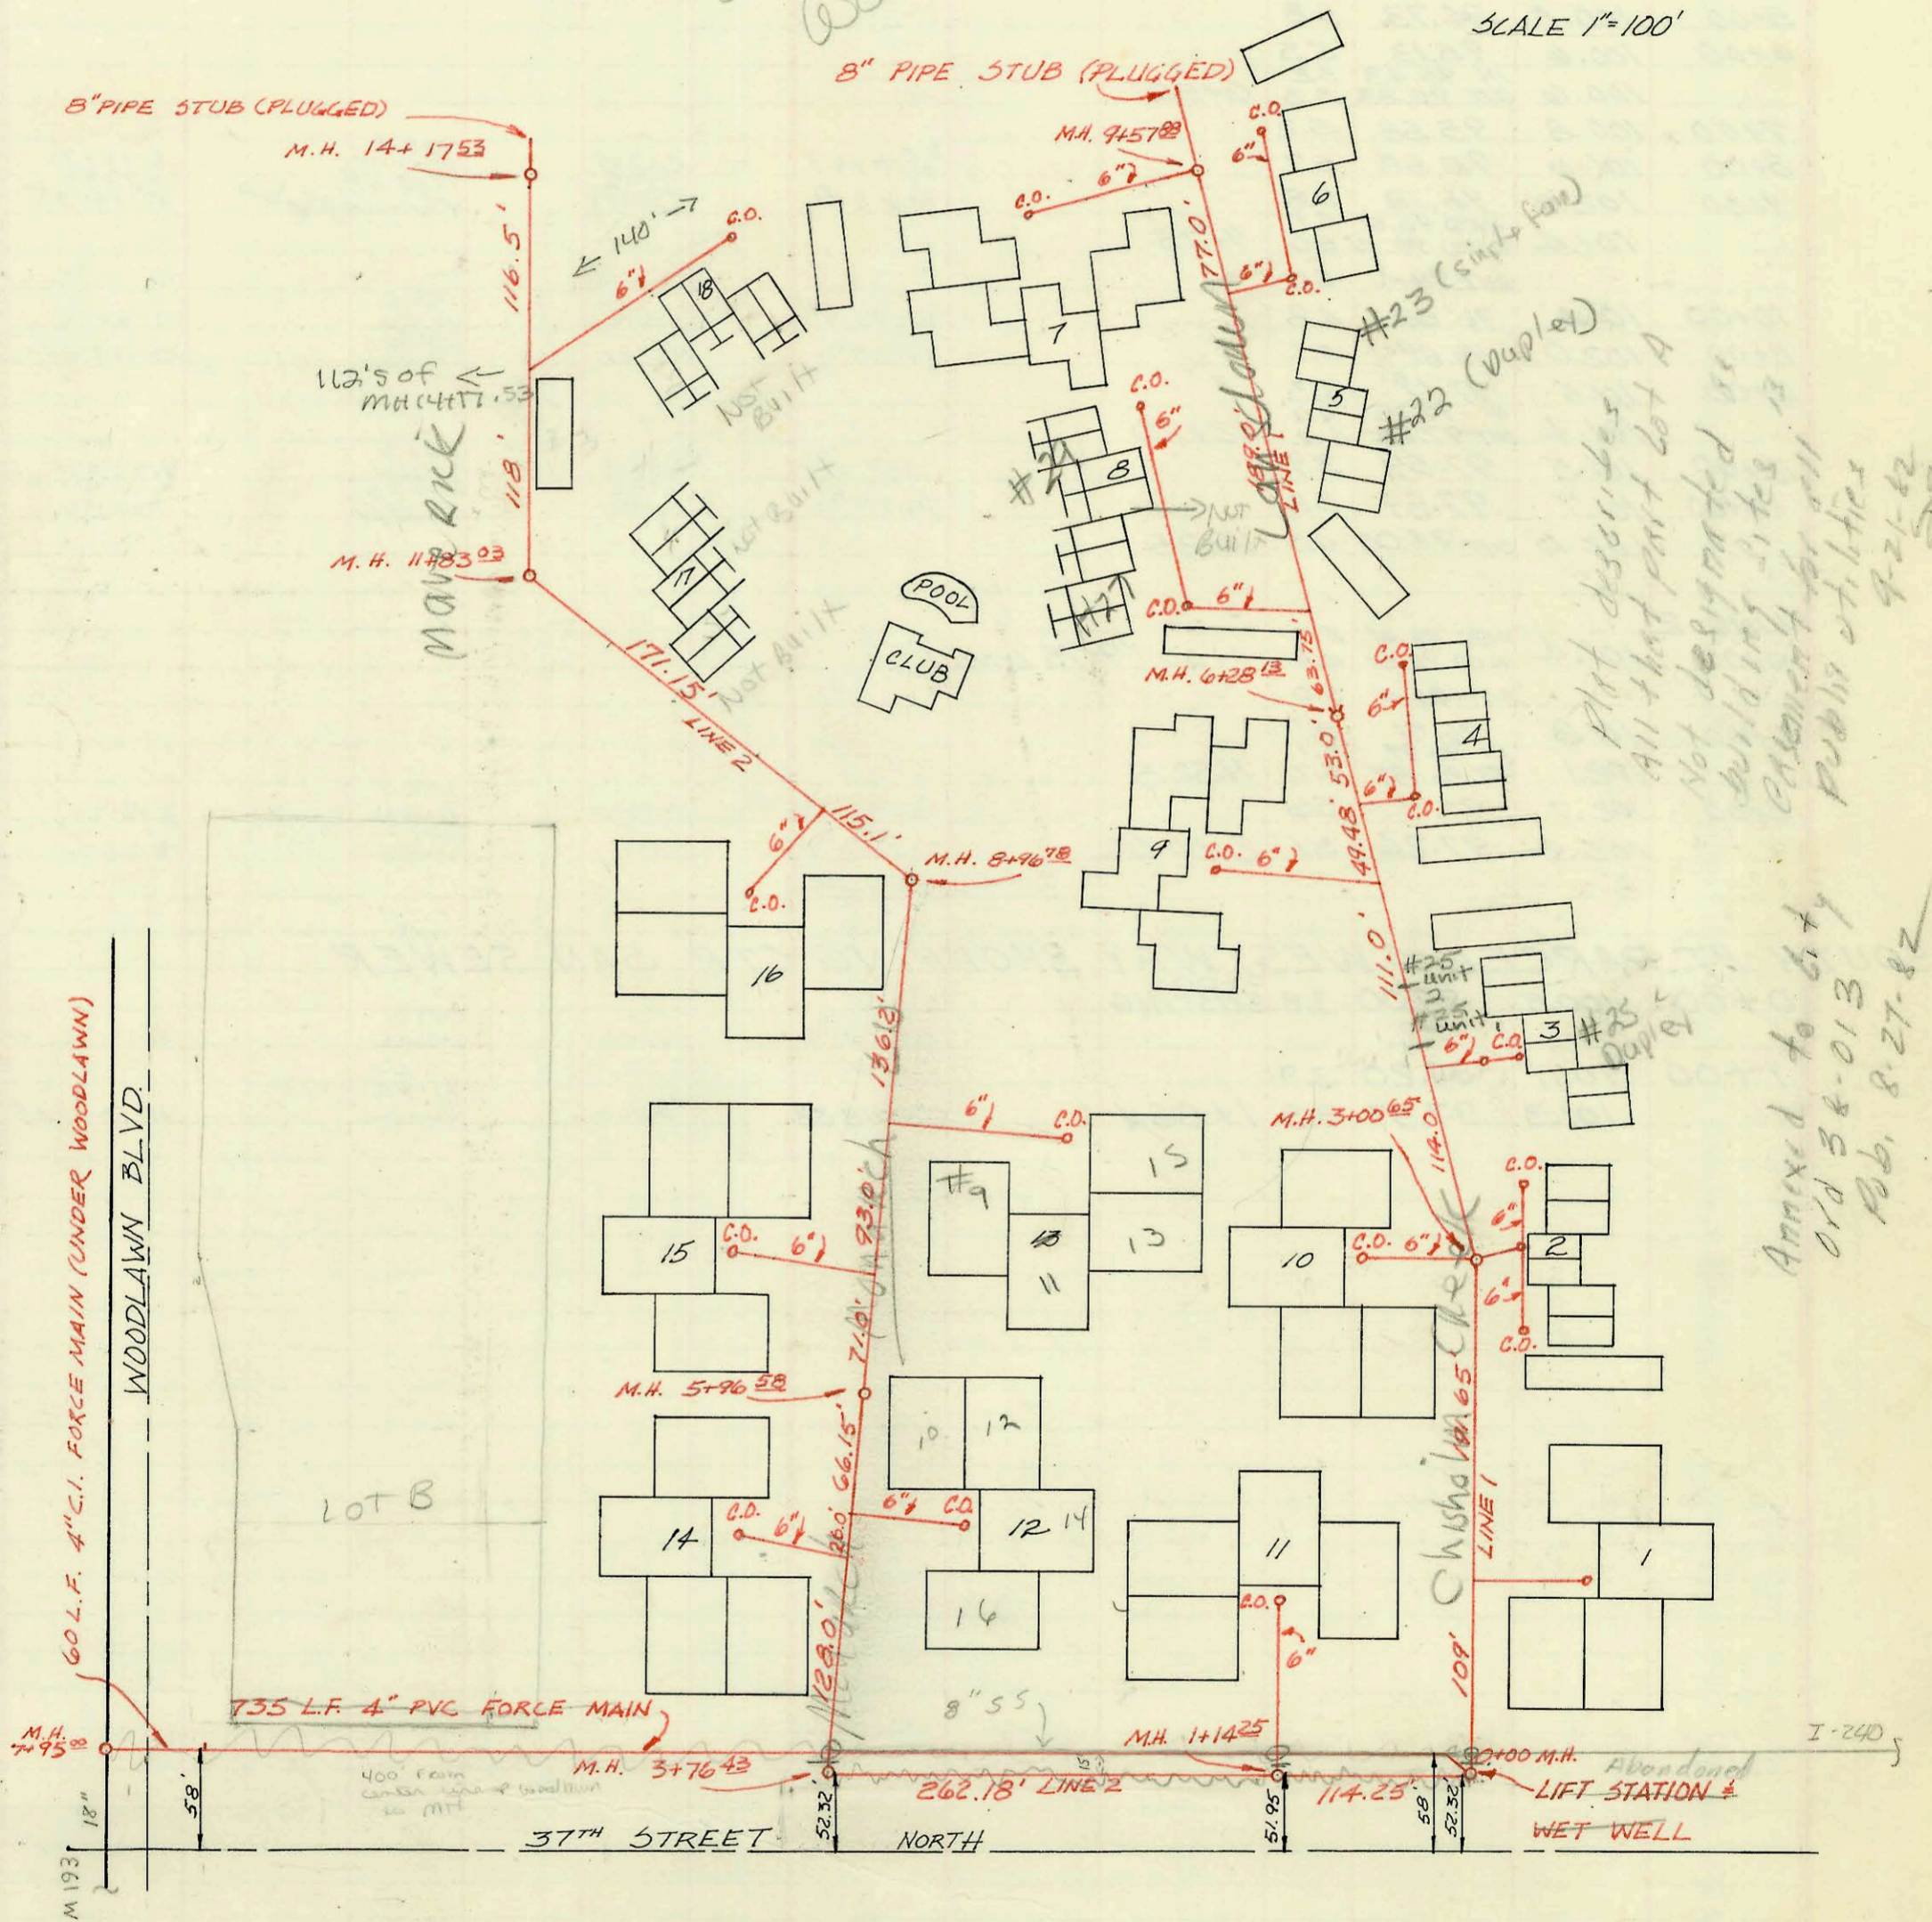

CONSTRUCTION RECORD						SERVICE RECORD						
STATION	ELEVATION		Depth	MANHOLE	4-INCH "Y" BRANCHES		No. of Permit		House Number		DATE OF PERMITS	
	Ground	Grade			North West	South East	North West	South East	North West	South East	North West	South East
SANITARY SEWER TO SERVE CHISHOLM CREEK												
LINE NO. 1												
0+00	174.1	167.13	7.0	LIFT STATION #WET WELL								
1+00	174.7	167.35	7.4									
2+00	175.3	167.57	5.7									
3+00	175.9	167.79	8.1									
	175.9	IN 167.87 OUT 167.79	8.0 8.1	3+00 ⁶⁵								
4+00	175.8	168.28	7.5									
5+00	175.8	168.69	7.1									
6+00	175.8	169.10	6.7									
	175.8	IN 169.27 OUT 169.23	6.5 6.6	6+28 ¹³								
7+00	176.0	169.52	6.5									
8+00	176.3	169.87	6.4									
9+00	176.6	170.22	6.4									
	176.8	IN 170.45 OUT 170.45	6.4	9+57 ⁸⁸								
LINE NO. 2												
0+00	174.1	164.44	9.7									
1+00	173.7	164.74	9.0									
	173.7	IN 164.77 OUT 164.78	8.9 8.9	1+14 ²⁵								
2+00	175.0	165.04	10.0									
3+00	176.6	165.34	11.3									
	177.8	165.53	12.3	3+76 ⁴³								
4+00	177.8	165.63	12.2									
5+00	178.0	166.01	12.0									
	178.1	IN 166.45 OUT 166.38	11.6 11.7	5+96 ⁵⁸								
6+00	178.1	166.46	11.6									
7+00	178.0	166.91	11.1									
8+00	178.0	167.36	10.6									
	178.0	IN 167.81 OUT 167.74	10.2 10.3	8+96 ⁷⁸								
9+00	178.0	167.82	10.2									
10+00	178.4	168.25	10.2		4" SCH 40 10+36.03 Predco		2000- 02609		BLDG 17-2			11-29-00
11+00	178.8	168.68	10.2		4" SCH 40 11+24.03 Predco		2000- 02489		BLDG 17-1			11-15-00
	179.0	IN 169.11 OUT 169.03	9.9 10.0	11+83 ⁰³								
12+00	179.0	169.12	9.9									
13+00	178.9	169.59	9.3									
14+00	178.9	170.06	8.8									
	178.9	IN 170.40 OUT 170.21	8.5 8.7	14+17 ⁵³	4" SCH 40 14+51 4" SCH 40 14+51		2000- 02487 2000- 02608	TWIN HOME	BLDG #19-1 BLDG #19-2			11-15-00 11-29-01
FORCE MAIN												
0+00	174.1	168.77	5.3									
1+00												
2+00												
3+00												
4+00												
5+00												
6+00												
7+00												
	184.8	180.75	4.0	7+95 ⁰⁰								

2000-02488 - 11/15/00 - 3900 N Woodlawn Bldg 18 - Mies Const. 4" SCH 40 - 6" SVC. Line taps into main 112'S of MH + goes NE 140' to a DEMH - DL Tapped line 58' SW of DE CO - TWINCO, 2U22, 1H22

- C 46733 - 3900 N. Woodlawn - Bldg #7 - 9-19-74
- C 46734 " " Bldg #6 " (9+30.88)
- C 46735 " " Clubhouse " (9+87.1)
- C 46534 " " Bldg 16 - 9-6-74 (9+40.1)
- C 46533 " " Bldg 15 " (8+80.5)
- C 46532 " " Bldg 14 " (5+23.4)
- C 45839 - 3900 N. Woodlawn - Bldg 1 - 7/19/74 (1+26) 3/1 Bldg.
- C 45842 " " Bldg 2 " "
- C 45843 " " Bldg 10 " "
- C 45844 " " Bldg 9 " (5+11.1)
- C 45845 " " Bldg 4 " (6+37.13)
- C 46091 " " Bldg 11 " "
- C 46092 " " Bldg 12 " (5+13.4)
- C 46093 " " Bldg 13 " (7+62.5)