
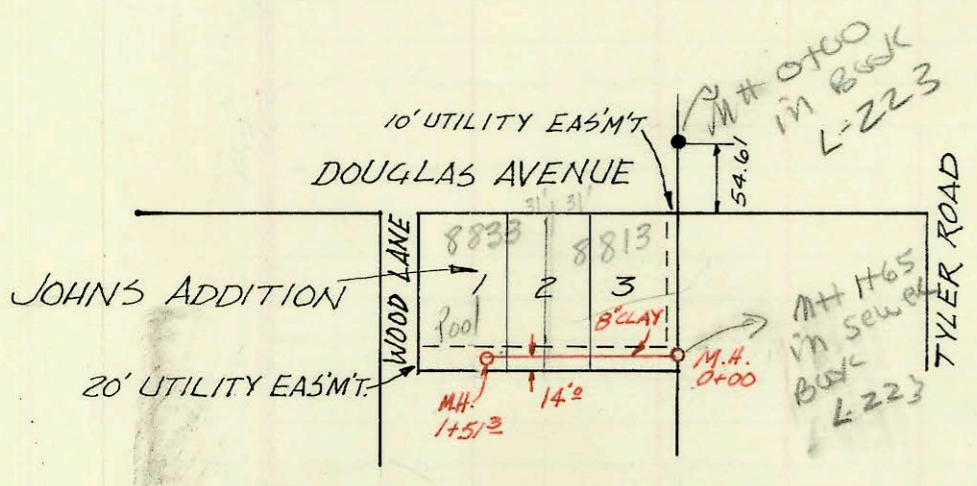


LAT 14, MAIN 1, WESTLINK SEWER
BUILT BY CARTER CONSTRUCTION
BOOKED 6-19-74 FROM G-2
PROJECT NO. DBKL573080

on map

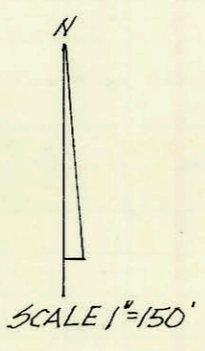


137.3
100.6
107


SANITARY SEWER TO SERVE WESTWAY SHOPPING CENTER

BUILT BY UTILITY
BOOKED 8-5-74 FROM PLAN
PROJ. NO. DBKW704037

on map

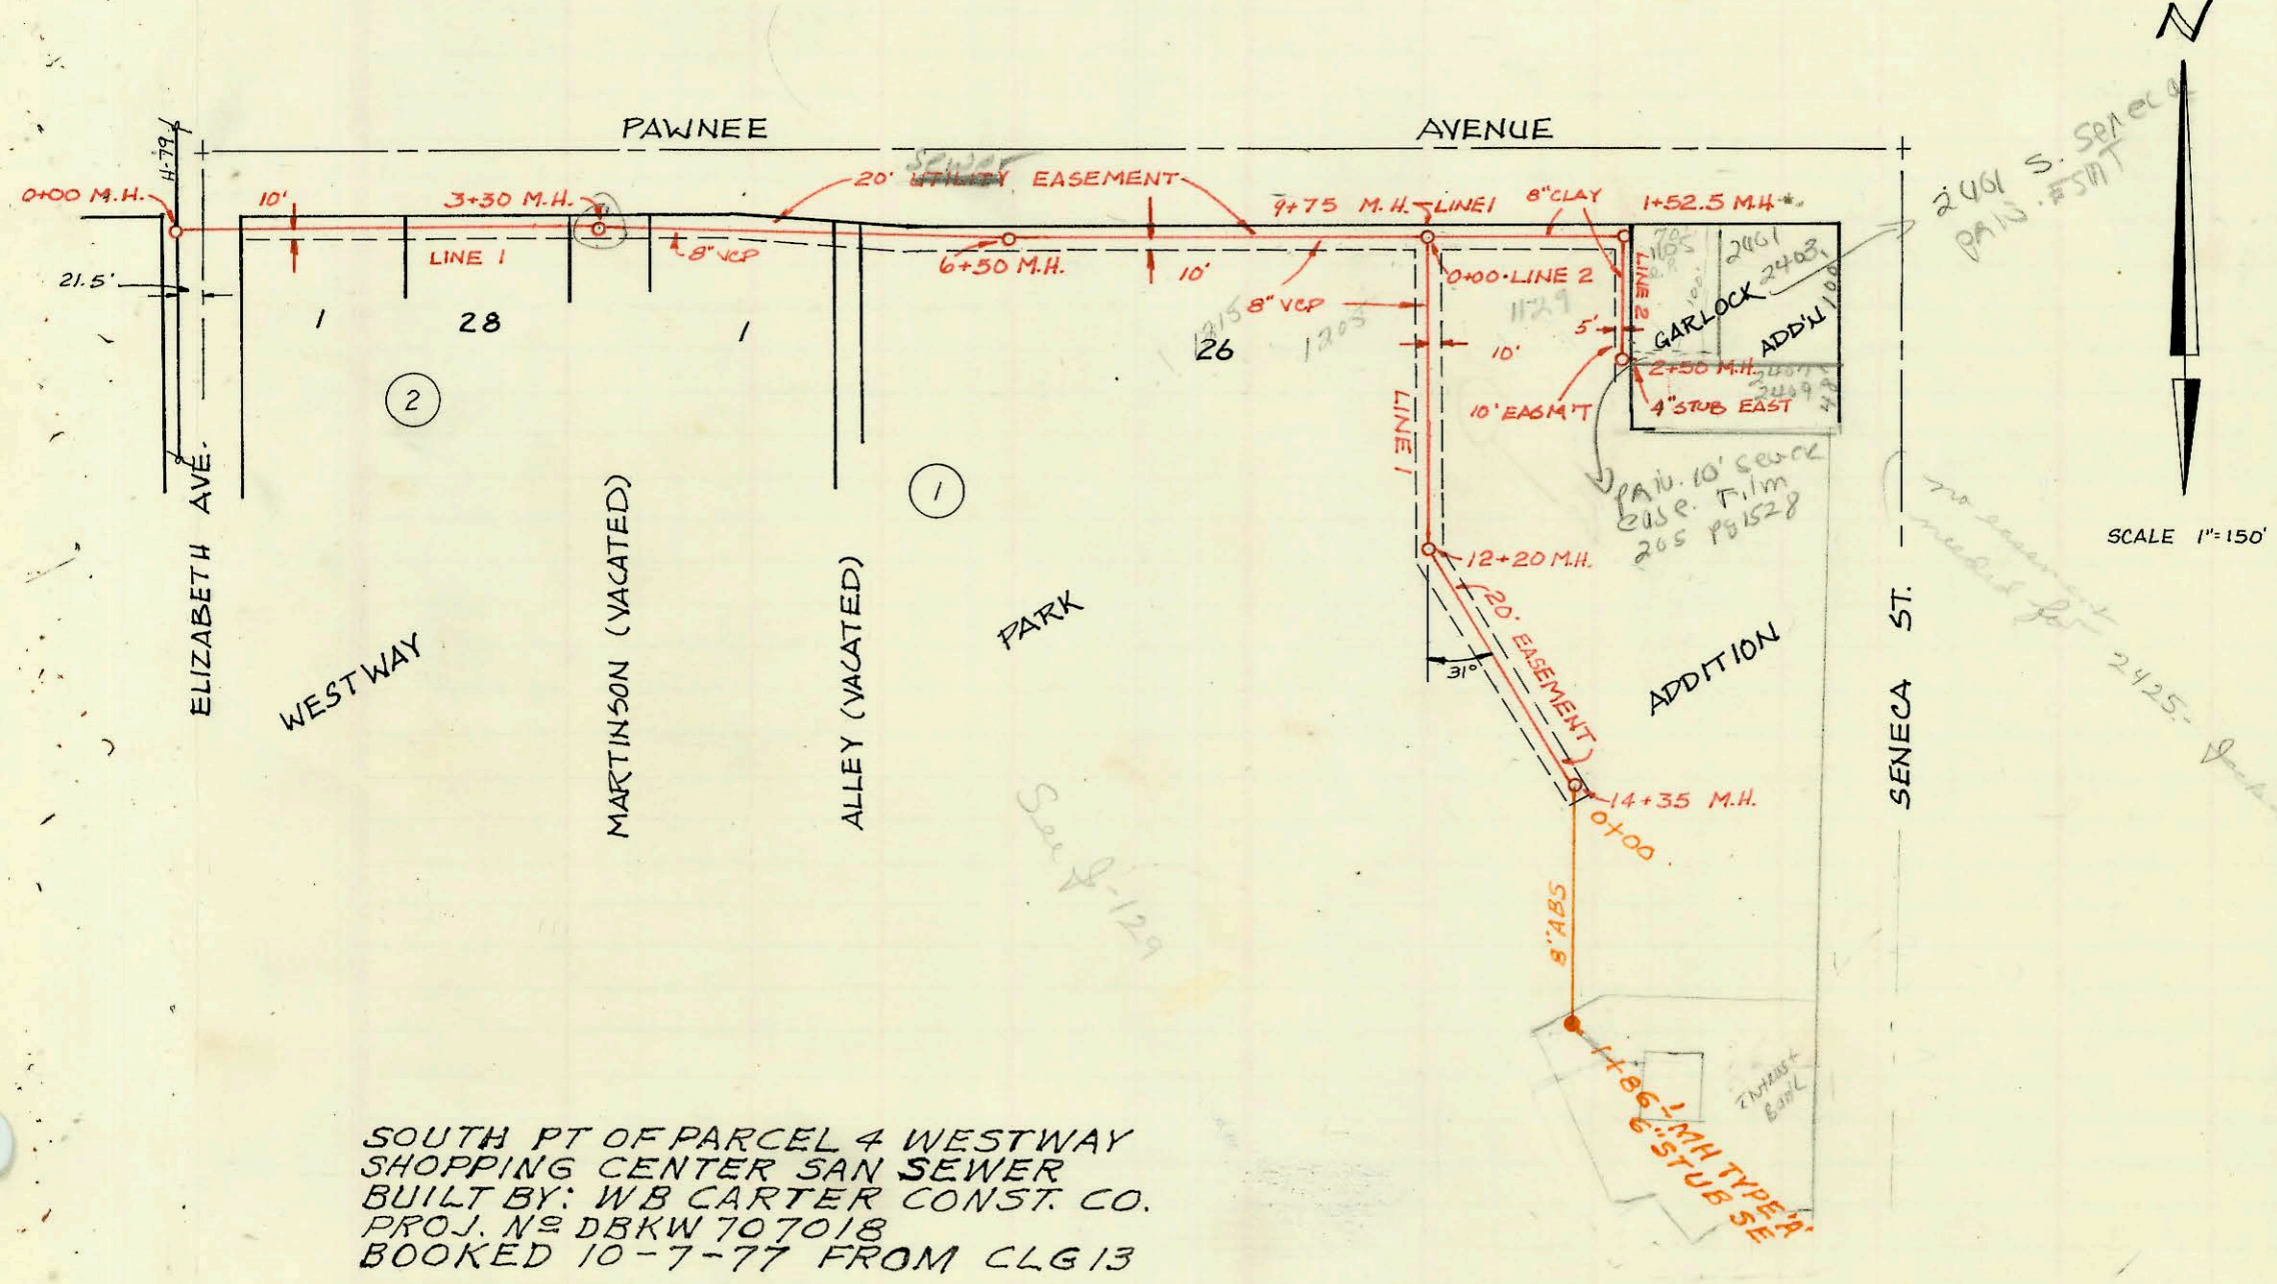

SOUTH PT OF PARCEL 4 WESTWAY SHOPPING CENTER SAN SEWER
BUILT BY: WB CARTER CONST. CO.
PROJ. NO. DBKW 707018
BOOKED 10-7-77 FROM CLG 13

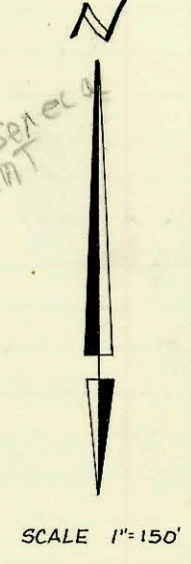

2401 S. Seneca
PA 10.7511

no sewer for 2425- (vacated parcel)

CONSTRUCTION RECORD					SERVICE RECORD							
STATION	ELEVATION		Depth	MANHOLE	4-INCH "Y" BRANCHES		No. of Permit		House Number		DATE OF PERMITS	
	Ground	Grade			North West	South East	North West	South East	North West	South East	North West	South East
LAT. 14, MAIN 1, WESTLINK SEWER												
0+00	144.0	134.98	9.0	0+00								
1+00	144.9	135.38	9.5	1+40 ⁶			045484		8833 W. Douglas		6-29-74	
	144.8	135.58	9.2	1+51 ³								
SANITARY SEWER FOR WESTWAY SHOPPING CENTER												
LINE 1												
0+00	99.0	IN 92.63 OUT 85.58	6.4 13.4	0+00								
1+00	100.2	93.03	7.2									
2+00	100.1	93.43	6.7		Tap 2+04		059180		1415 W. Pawnee		12-20-76	
3+00	99.3	93.83	5.5									
	99.2	IN 94.05 OUT 93.95	5.2	3+30								
4+00	99.7	94.33	5.4									
5+00	100.5	94.73	5.8									
6+00	100.6	95.13	5.5									
	100.6	IN 95.43 OUT 95.33	5.2	6+50								
7+00	100.8	95.58	5.2									
8+00	101.6	95.88	5.7		8+64.7		050049		1305 W. Pawnee		8-14-75	
9+00	102.0	96.18	5.8		9+04 ²		050049		1215 W. Pawnee		8-27-75	
	101.4	IN 96.51 OUT 96.41	4.9	9+75			050049		1215 W. Pawnee		8-14-75	
10+00	101.4	96.58	4.8									
11+00	102.0	96.89	5.1		10+95.4 ^{tap}		045614		1129 W. Pawnee		7-8-74	
12+00	101.5	97.19	4.3		11+91.0 ^{tap}		063782		2411 S. Seneca		10-31-77	
	101.4	IN 97.35 OUT 97.25	4.0	12+20								
13+00	101.5	97.59	3.9		13+48.7 ^{tap}		063247		2425 S. Seneca		9-28-77	
14+00	101.7	97.89	3.8		14+12.7 ^{tap}		063958		2435 S. Seneca		10-19-78	
	102.0	OUT 98.00	4.0	14+35			064901				1-27-78	
LINE 2												
0+00	101.4	IN 96.41 OUT 96.41	5.0	0+00 (9+75 LINE 1)								
1+00	101.8	96.71	5.1									
	102.1	IN 96.91 OUT 96.87	5.2	1+52.5								
2+00	102.7	97.11	5.6		2+37.2 ^{tap}		059990		1105 W. Pawnee		2-18-77	
	102.4	97.24	5.1	2+50.0 ^{OK}	2+37.8 ^{tap}		057871		2401 S. Seneca		8-25-76	
SOUTH PT PARCEL 4 WESTWAY SHOPPING CTR SAN SEWER												
0+00	100.8	97.00	3.8	EXISTING								
1+00	101.1	97.20	3.9		0+55.1 ^{tap}		066435		2435 S. Seneca		5-17-78	
	101.3	97.37	3.9	1+86.1	6" STUB SE		063960		2519 S. Seneca		11-10-77	

97-6407-9 9-24-97 1215 W Pawnee - Padgett

19368-2407 S. Seneca - 10-22-87