


SCALE 1"=150'

LAT 80 MAIN 4 SS. "23
 Built by Utility Cont. Inc.
 Booked 9-9-74 from G-5
 Proj. No. DBKL573004
 on map

Replat
 See 9-28

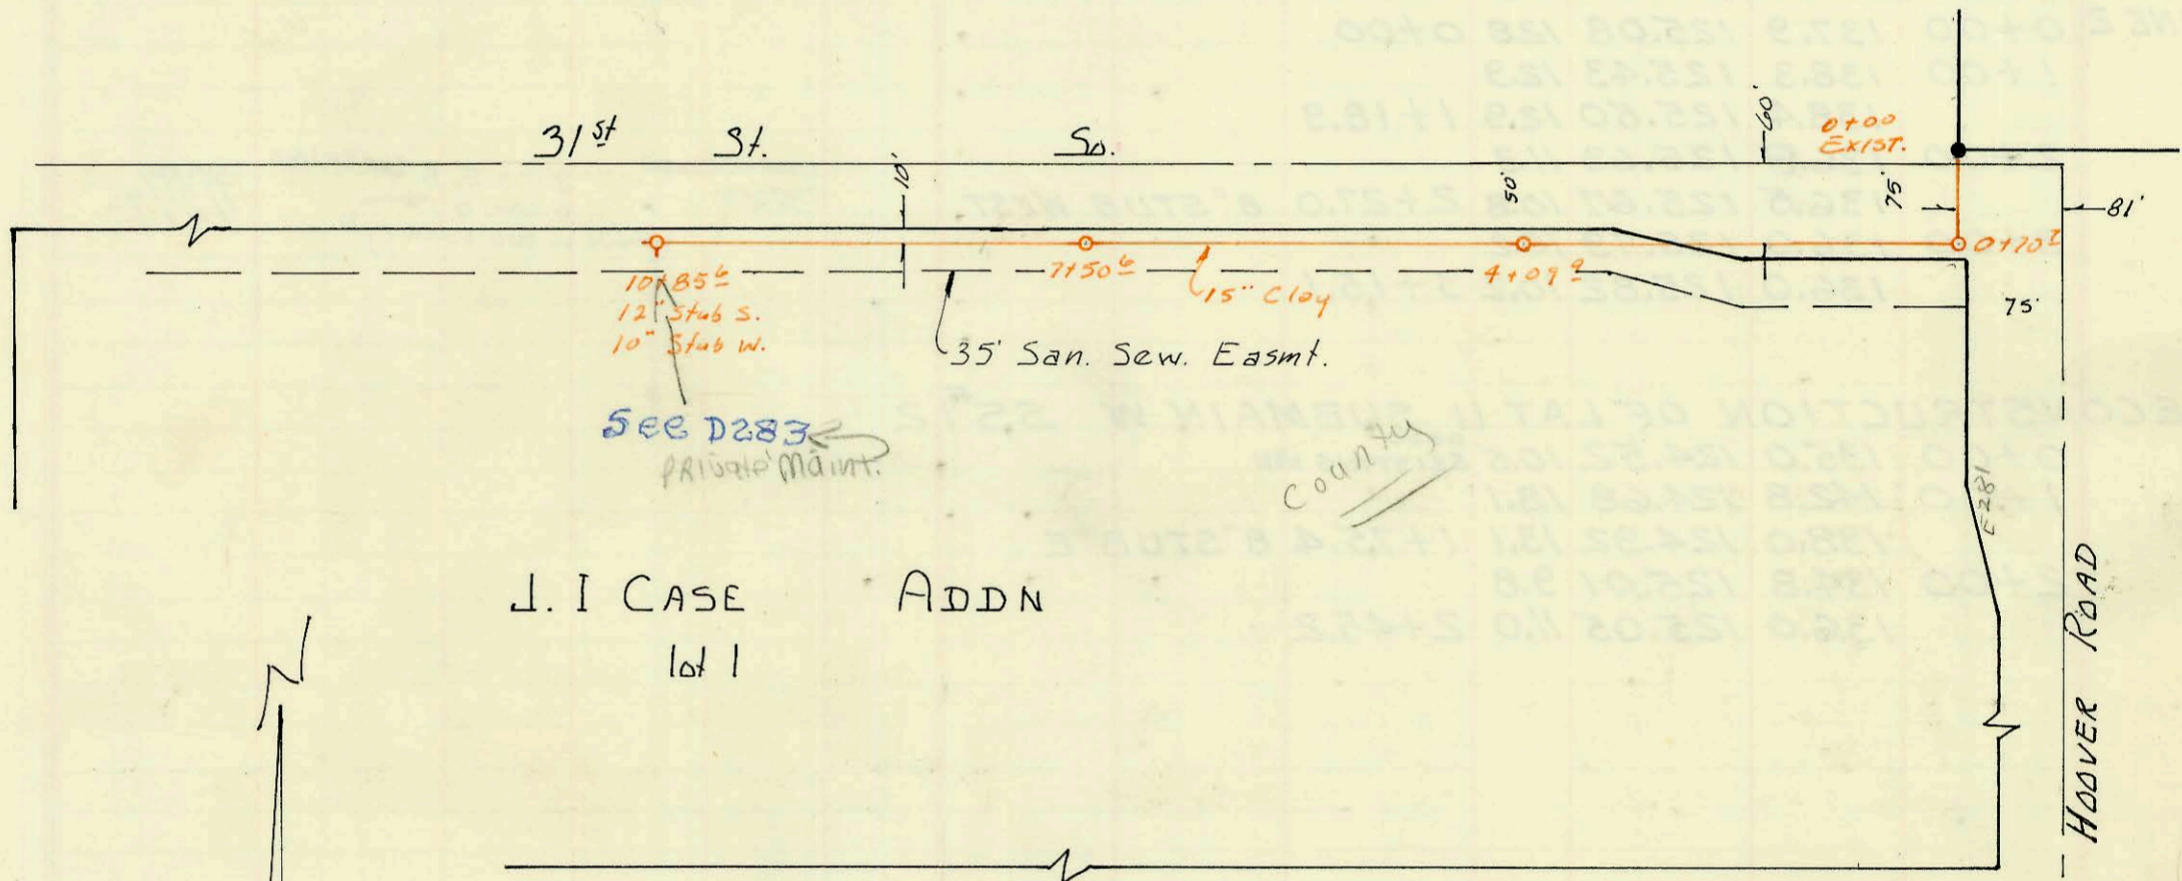

Scale 1"=150'


J. I CASE ADDN
 lot 1

LAT 67 SWI.
 Built by Mid-States Const. Co.
 Booked 9-9-74 from SS JK "B
 Proj. No. DBKL574003
 on map

PRIVATE SANITARY SEWER ABANDONMENT
 TO SERVE DILLONS 11TH ADDITION
 PRIV. PROJ. NO. 565 PPS (607861)
 BUILT BY W. B. CARTER CONST. CO.
 BOOKED 2-15-96 FROM AS BUILTS

LAT 7 MAIN 2 SWI SEWER
 BUILT BY: WB CARTER
 PROJ. N^o DBKL 572081
 BOOKED 10-1-74 FROM SS JK #3
 on map

not in
 draft plat (T. Bone)
 (220 E.)
 (47th St. So.)
 OWNER OF T. BONE
 K. E. TROUS, TRUSTEES WITH
 BREWER & CO. HE UNDERTAKES
 HE WILL BE INCLUDED IN
 LAT 9 MAIN 2 SWI

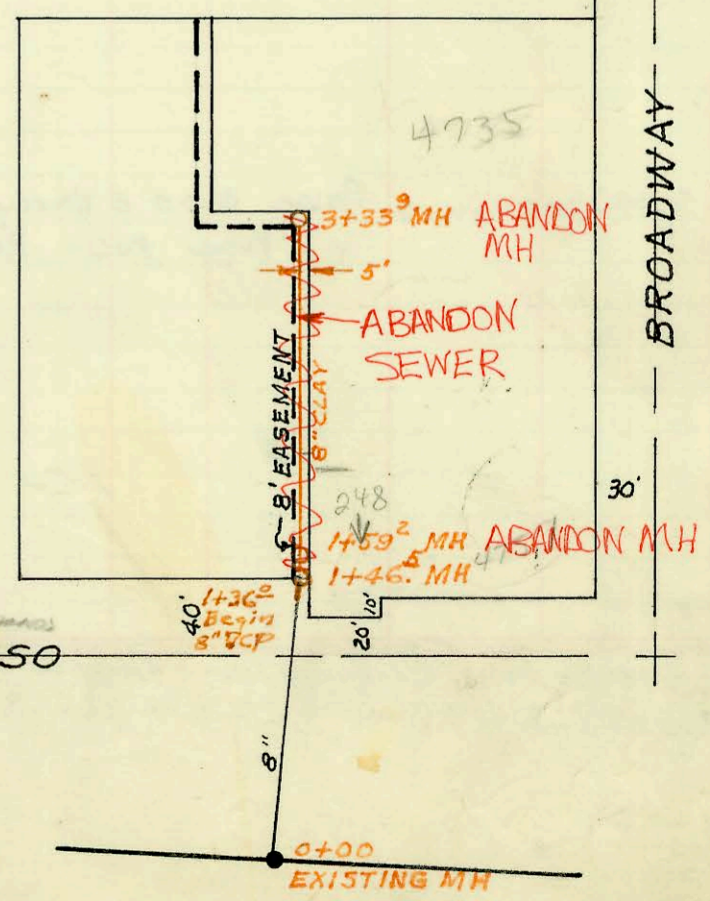

Scale 1"=100'

CONSTRUCTION RECORD						SERVICE RECORD						
STATION	ELEVATION		Depth	MANHOLE	4-INCH "Y" BRANCHES		No. of Permit		House Number		DATE OF PERMITS	
	Ground	Grade			North West	South East	North West	South East	North West	South East	North West	South East
LAT 80 MAIN 4 SS#23												
0+00	127.5	120.92	6.6	0+00								
1+00	127.4	121.22	6.2									
2+00	127.6	121.52	6.1									
	127.2	IN 121.90	5.3	2+92?								
3+00		OUT 122.21	5.8		top 3+24		46633		3055		9-18-74	
	128.0	IN 122.31	5.7	3+95?	top 2+88		46450		3053		9-3-74	
4+00		OUT 122.41	5.6									
	128.2	IN 122.51	5.7	4+29?	4+57.5 top		3740		3051		7-21-81	
5+00	127.4	122.72	4.7									
6+00	128.0	123.02	5.0									
	127.5	123.25	4.2	6+74?	6+70.1 top		10529		3005		3-27-84	
LAT 67 S.W.I.												
0+00	109.0	97.46	11.5	0+00 Exist.								
	110.1	97.65	12.6	0+70.7								
1+00	110.3	97.73	12.6									
2+00	110.1	98.00	12.1									
3+00	110.4	98.27	12.1									
4+00												
	110.2	98.57	11.6	4+09?								
5+00	110.0	98.82	11.2									
6+00	110.0	99.09	10.9									
7+00	110.1	99.36	10.7									
	100.4	99.49	10.9	7+50.6								
8+00	110.1	99.63	10.5									
9+00	110.1	99.90	10.2									
10+00	110.3	100.17	10.1									
	110.1	100.40	9.7	10+85.6	12" S.W.S.							
					10" S.W.W.							
LAT 7 MAIN 2 SW INTERCEPTOR SEWER												
0+00	86.49	73.48	13.01	EXISTING								
	85.6	76.45	9.2	1+46.5								
	85.5	76.50	9.0	1+59.2								
2+00	86.1	76.66	9.4		top 2+11.7		95627		4757		4-26-95	
3+00	85.7	77.06	8.6				47938				12/31/74	
	85.6	77.20	8.4	3+33.9	4" S.W.S. West 10" W		95629		4735		4-26-95	
					slo 2+58.1		95627		4735		3-31-75	
							48850		4735		4-26-95	
							25603		4735		6-21-76	

95-6030-7 4-26-95 248 E 4735 - slo w/concrete primary add = 212 E 4735