


Call County for
sewers

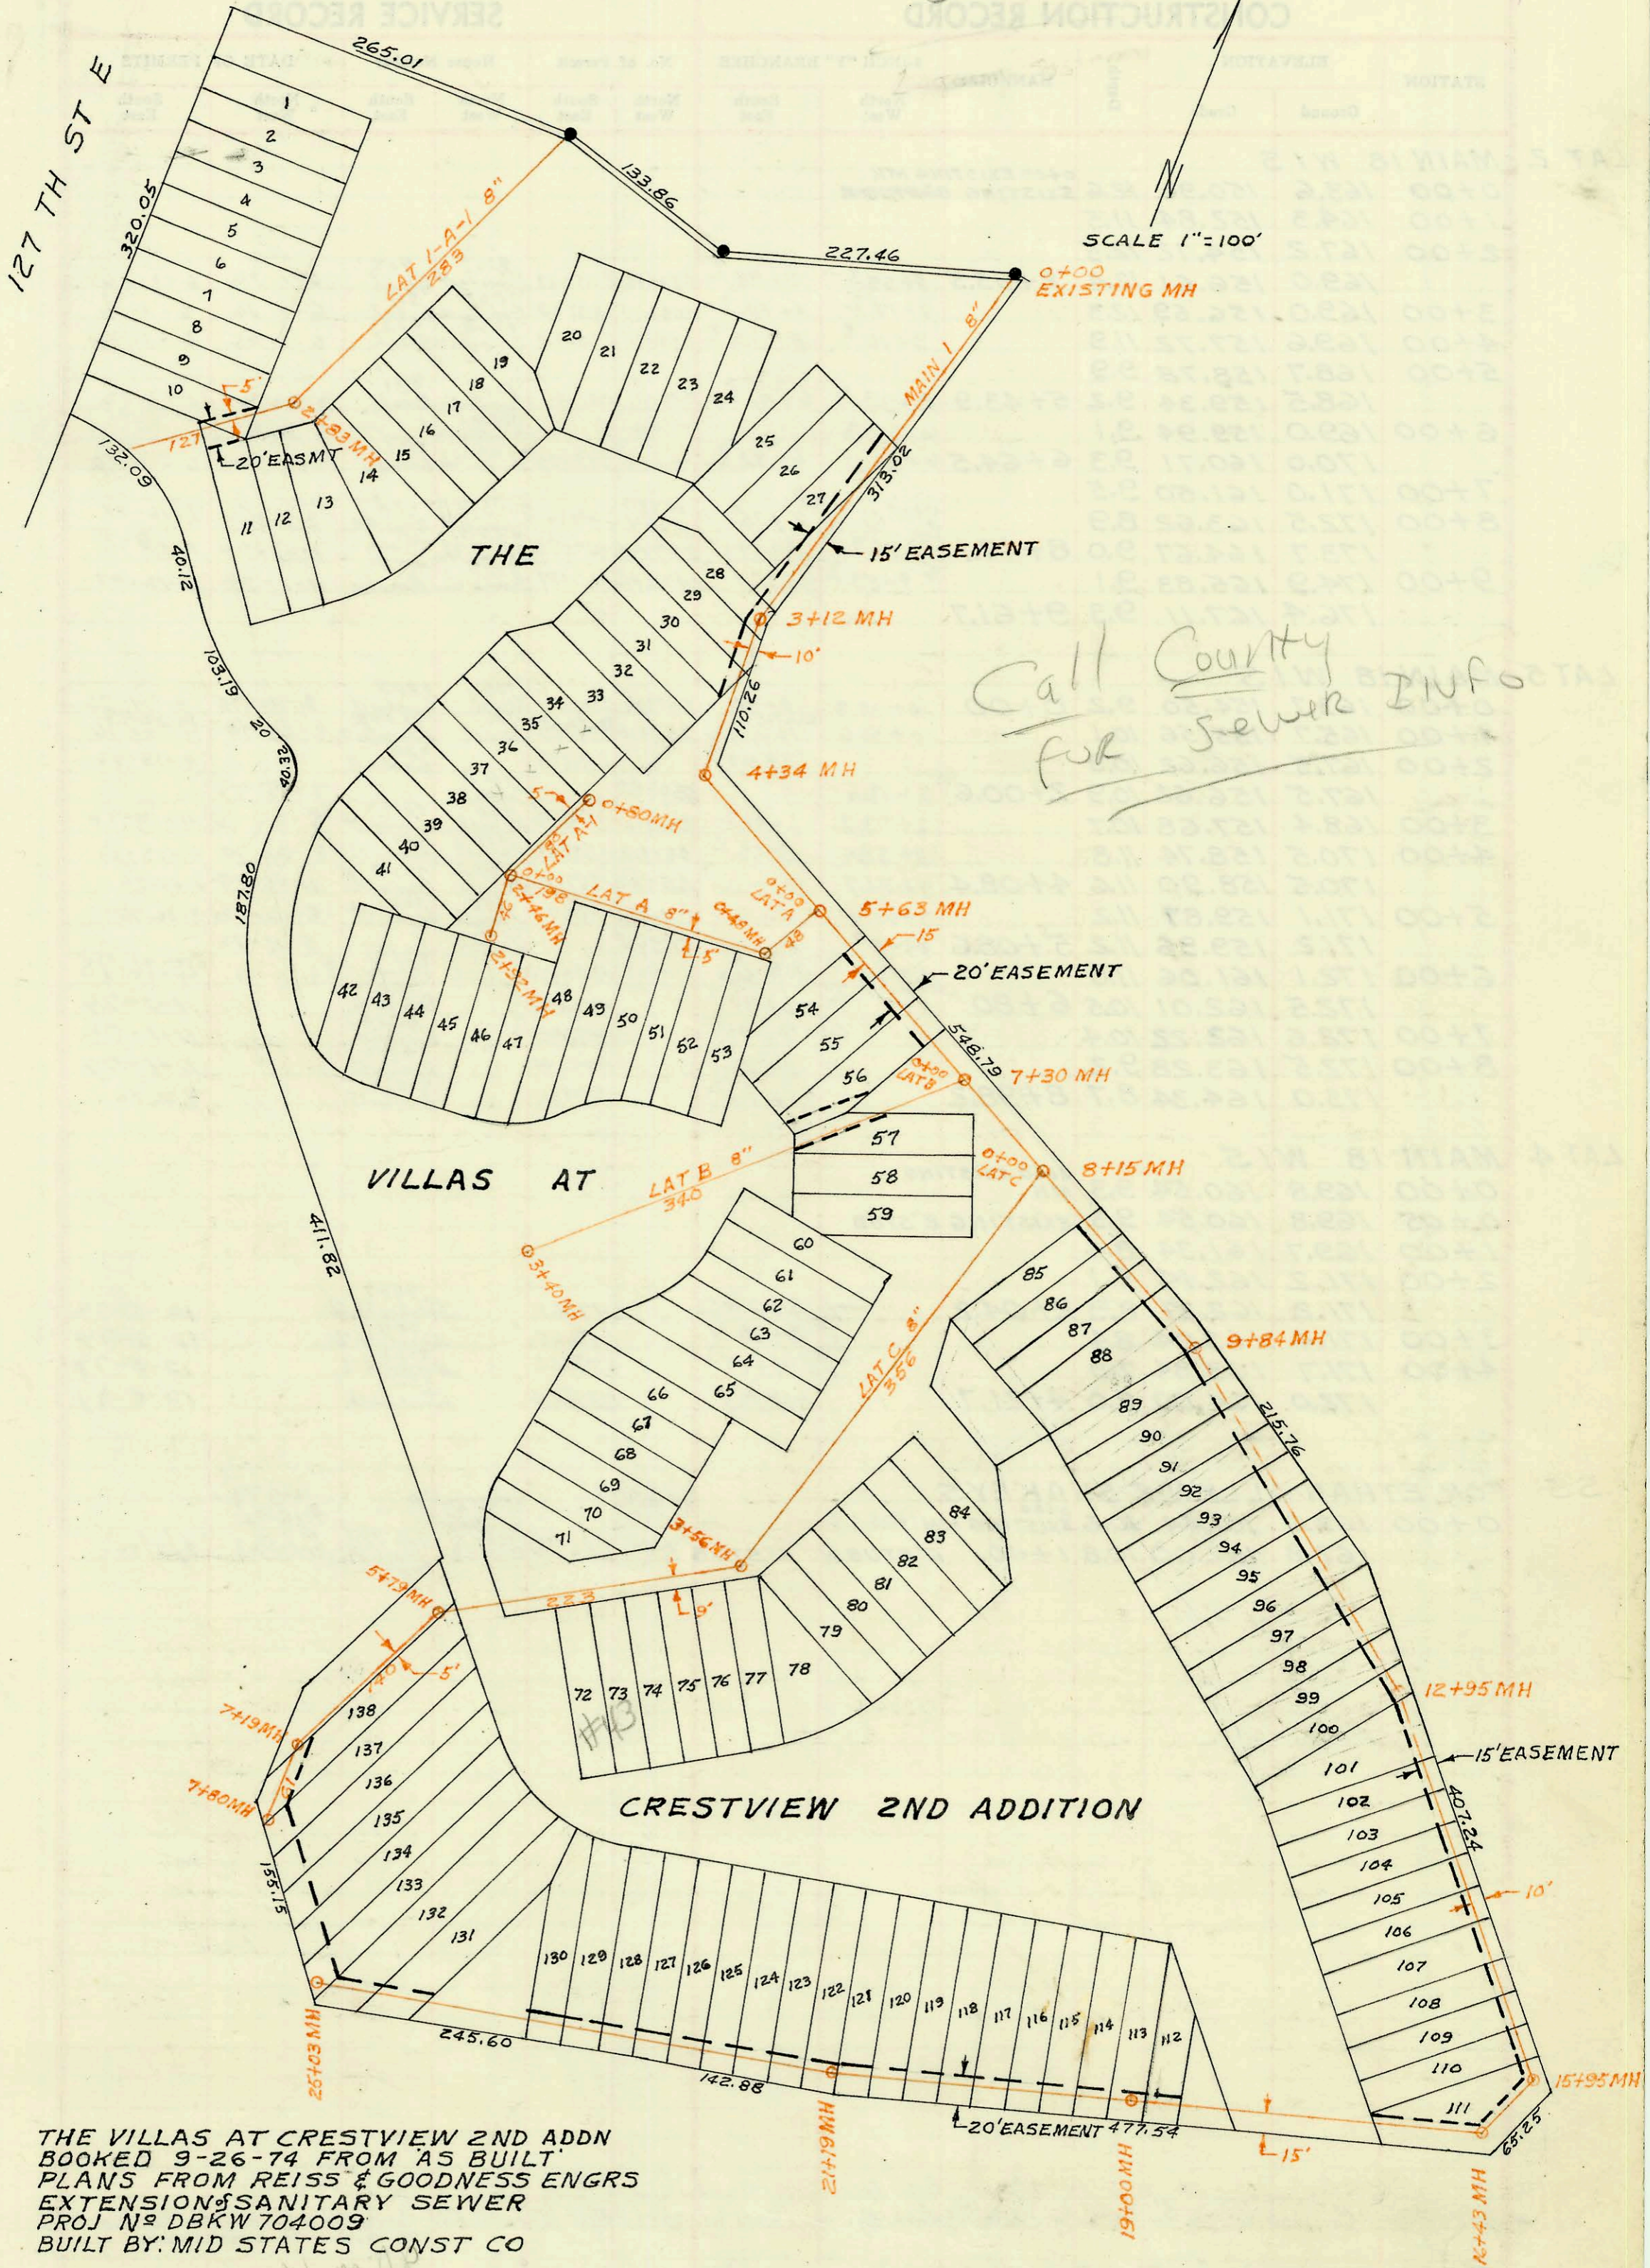

THE VILLAS AT CRESTVIEW 2ND ADDN
 BOOKED 9-26-74 FROM AS BUILT
 PLANS FROM REISS & GOODNESS ENGRS
 EXTENSION & SANITARY SEWER
 PROJ N^o DBKW 704009
 BUILT BY: MID STATES CONST CO

CONSTRUCTION RECORD

SERVICE RECORD

STATION	ELEVATION		Depth	MANHOLE	4-INCH "Y" BRANCHES		No. of Permit		House Number		DATE OF PERMITS	
	Ground	Grade			North West	South East	North West	South East	North West	South East	North West	South East
The Villas At Crestview 2nd Addn San Sewer Extension												
MAIN 1	0+00	170.8	162.48	8.3	0+00							
	1+00											
	2+00											
	3+00											
	4+00	170.2	163.38	6.8	3+12							
	5+00	171.9	163.96	7.9	4+34							
	6+00	169.4	164.55	4.9	5+63							
	7+00											
	8+00	170.0	165.22	4.8	7+30							
	9+00	169.2	165.56	3.6	8+15							
	10+00											
	11+00											
	12+00											
	13+00	172.2	167.58	4.6	12+95							
	14+00											
	15+00											
	16+00	176.6	168.88	7.7	15+95							
	17+00	177.0	169.17	7.8	16+43							
	18+00											
	20+00	179.7	170.30	9.4	19+00							
	21+00											
	22+00	180.1	171.18	9.0	21+19							
	23+00											
	24+00											
	25+00	182.3	172.81	9.5	25+03							
LAT 1-A-1	0+00	174.9	168.63	6.3	0+00 (EXISTING MH)							
	1+00											
	2+00											
	3+00	176.2	169.04	7.2	2+83							
	4+10				(CAPPED)							
LAT A	0+00	169.4	164.65	4.8	0+00 = 5+63 MAIN 1							
	1+00	169.6	164.84	4.8	0+48							
	2+00											
	3+00	174.3	165.73	8.6	2+46							
	4+00	174.0	166.01	8.0	2+92							
LAT A-1	0+00	174.3	165.83	8.5	0+00 = 2+46 LAT A							
	1+00	173.5	166.15	7.3	0+80							
LAT B	0+00	170.0	165.45	4.6	0+00 = 7+30 MAIN 1							
	1+00											
	2+00											
	3+00											
LAT C	0+00	172.5	166.81	5.7	3+40							
	1+00	169.2	165.66	3.6	0+00 = 8+15 MAIN 1							
	2+00											
	3+00											
	4+00	175.5	167.08	8.4	3+56							
	5+00											
	6+00	177.3	168.08	9.3	5+79							
	7+00											
	8+00	180.0	168.74	11.3	7+19							
	9+00	181.1	170.08	11.0	7+80							

STANDARD DRAWING WITH STAMP
 CONTRACTOR'S COPY
 NOT BE USED FOR CONSTRUCTION
 PROJECT NO. 17418
 SHEET NO. 17418-1
 DATE 12-3-79