


SCALE 1"=100'


LAT 3 MAIN 18 WIS
LINES 1, 2, 3, & 4
BUILT BY: MID STATES CONST CO
PROJ N° DBKL574014
BOOKED 10-7-74 FROM 9I
ON Map

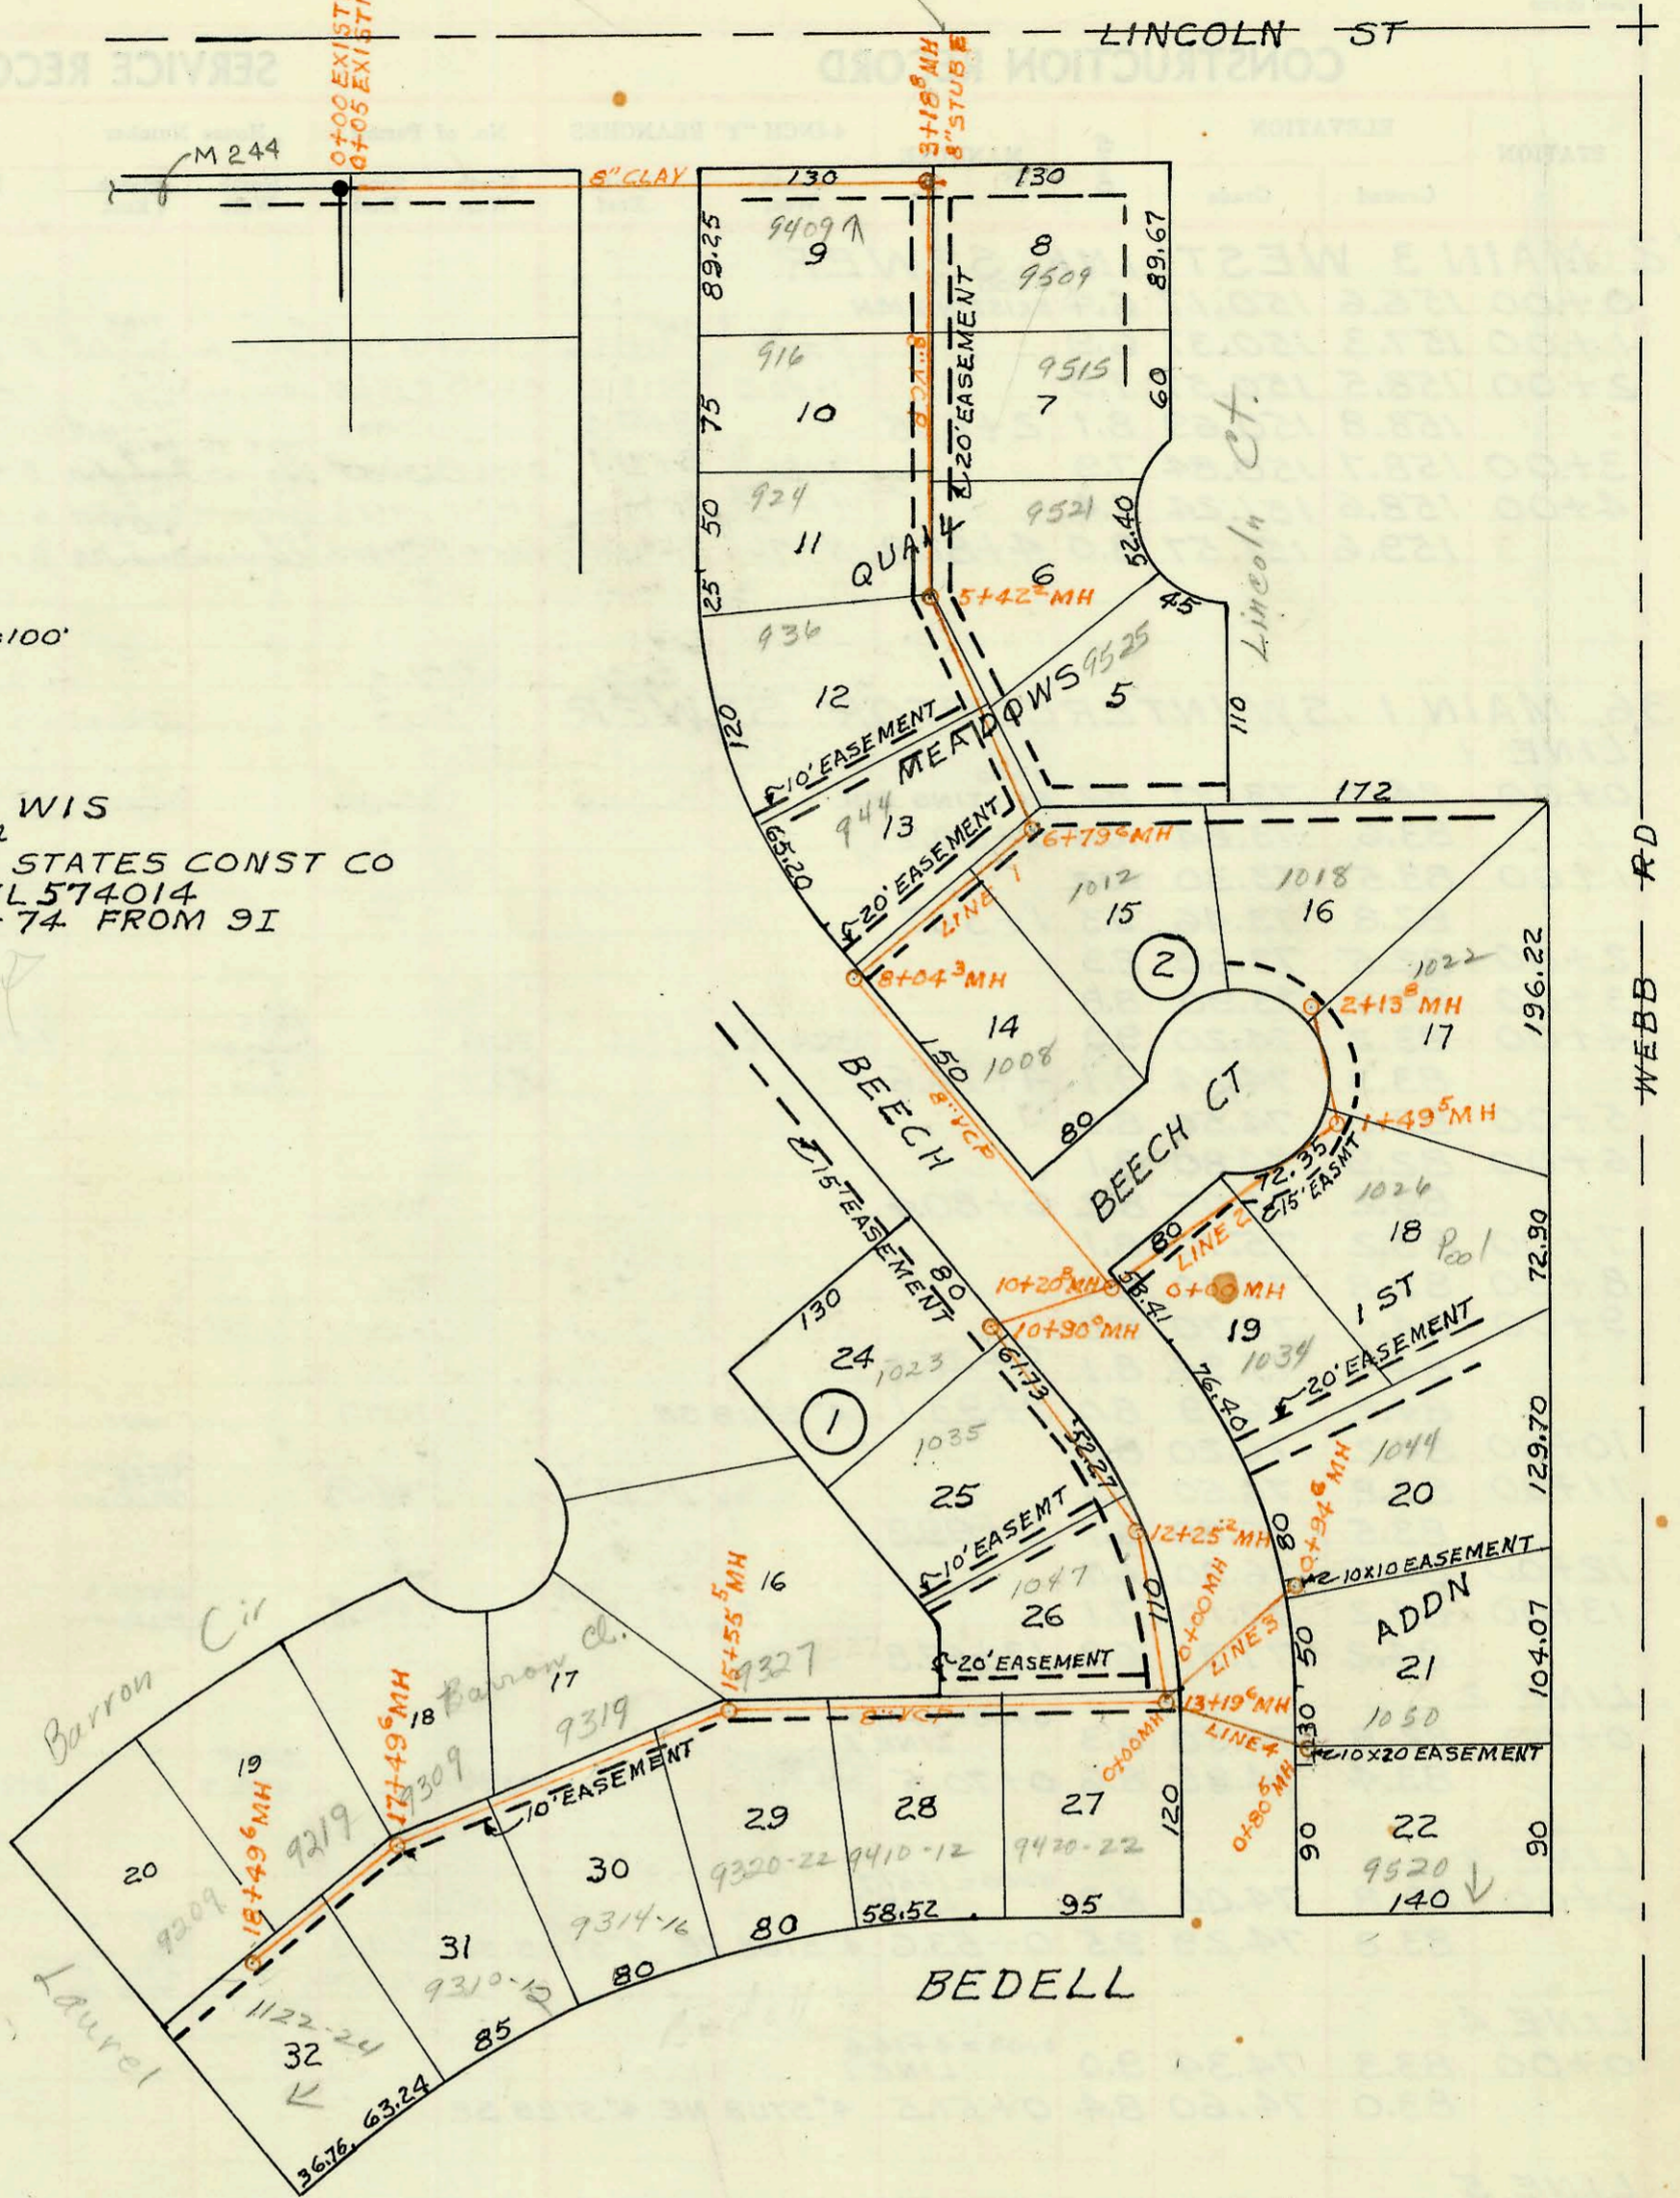

SCALE 1"=100'

PLAZA WEST SHOPPING CTR SS
BUILT BY: UTILITY CONTRACTORS
PROJ N° BHKB503045
BOOKED 10-11-74 FROM PLAN
ON Map

M. Todd Pley had
a tap made to this rest.
line for "Butter City" line is
on 8" clay - He said line is
not 6" clay
BSK

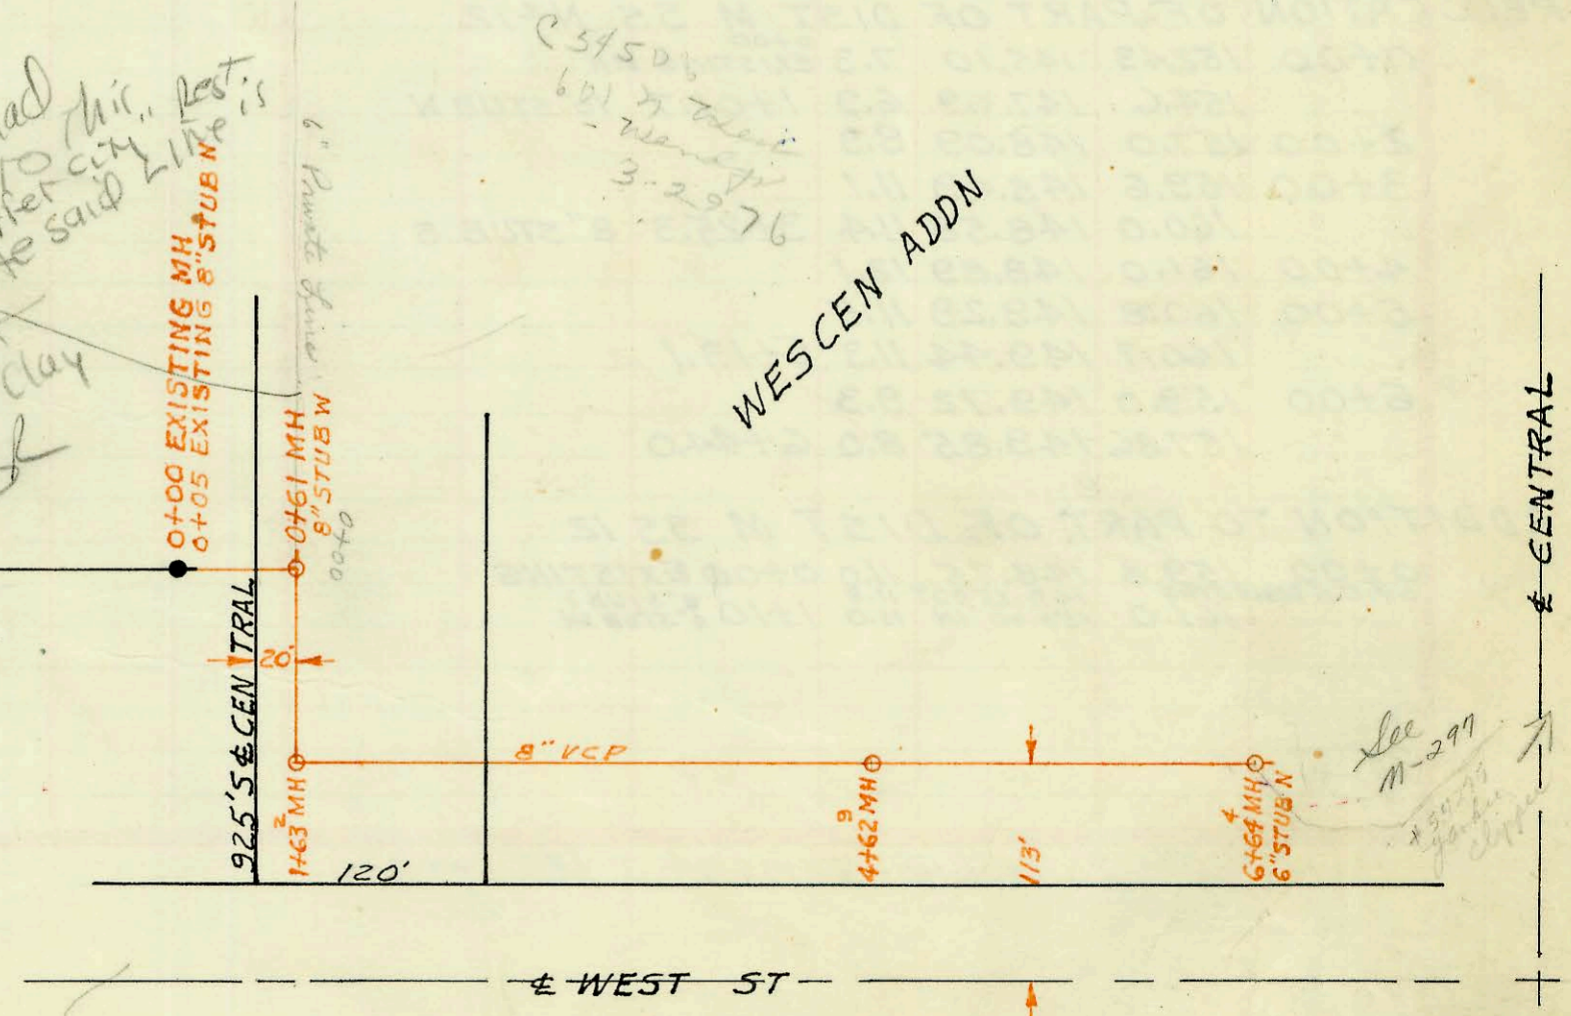

See
M-297

CONSTRUCTION RECORD

SERVICE RECORD

LAT 3

STATION	ELEVATION		Depth	MANHOLE	4-INCH "Y" BRANCHES		No. of Permit		House Number		DATE OF PERMITS	
	Ground	Grade			North West	South East	North West	South East	North West	South East	North West	South East
0+00	169.4	157.80	11.6	0+00 EXISTING MH								
0+05	169.4	157.84	11.6	EXISTING 8" STUB								
1+00	170.1	158.66	11.4									
2+00	170.5	159.52	11.0									
3+00	169.6	160.38	9.2									
	169.5	160.64	8.9	3+18.8 8" STUB E								
4+00	171.0	161.34	9.7									
5+00	172.2	162.20	10.0									
	172.6	162.73	9.9	5+42.2								
6+00	173.5	163.16	10.3									
	174.2	164.02	10.2	6+79.6								
7+00	174.3	164.12	10.2									
8+00	174.5	164.98	9.5									
	174.5	165.19	9.3	8+04.3								
9+00	176.4	165.54	10.9									
10+00	179.4	165.94	13.5									
	179.5	166.16	13.3	10+20.8								
	180.0	166.54	13.5	10+90.0								
11+00	180.0	166.58	13.4									
12+00	181.6	166.94	14.7									
	182.3	167.18	15.1	12+25.2								
13+00	183.0	167.44	15.6									
	183.0	167.66	15.3	13+19.6								
14+00	182.5	167.94	14.6									
15+00	181.7	168.34	13.4									
	180.2	168.71	11.5	15+55.5								
16+00	179.8	168.84	11.0									
17+00	179.1	169.24	9.9									
	178.3	169.58	8.7	17+49.6								
18+00	177.7	169.74	8.0									
	177.6	169.98	7.6	18+49.6								
LINE 2												
	180.0	168.10	11.9	0+00 = 10+20.8 Line 1								
1+00	179.0	170.10	8.9									
	178.2	171.16	7.0	1+49.5								
2+00	177.4	172.20	5.2									
	177.2	172.44	4.8	2+13.8 M.H. TAP								
LINE 3												
	183.1	171.07	12.0	0+00 = 13+19.6 Line 1								
	183.2	172.93	10.3	0+94.6 M.H. Tap								
LINE 4												
	183.0	171.66	11.3	0+00 = 13+19.6 Line 1								
	183.8	173.26	10.5	0+80.5 TAP MH								
SS												
0+00	120.3	114.84	5.5	0+00 EXISTING MH								
0+05				EXISTING 8" STUB								
	121.61	115.39	6.2	0+61 8" Stub W.								
1+00	120.6	115.46	5.1									
	120.65	115.68	5.0	1+63.2								
2+00	120.6	115.79	4.8									
3+00	120.7	116.09	4.6									
4+00	120.6	116.39	4.2									
	120.62	116.58	4.0	4+62.9								
5+00	120.8	116.71	4.1									
6+00	120.8	117.06	3.7									
	121.85	117.28	4.6	6+64.4								
				6" private line for Plaza West								
				0+00	0+57							
					0+73							
					2+18.1							

601 N. Street (30.0) 7/23/73
 601 N. Street (30.4) 7/23/73
 601 N. Street (30.8) 7/23/73