


HIGH POINT EAST
 SANITARY SEWER
 BUILT BY: PRIVATE
 PROJ N^o BHKB503066
 BOOKED 11-26-74 FROM PLAN

on map

SCALE 1"=150'

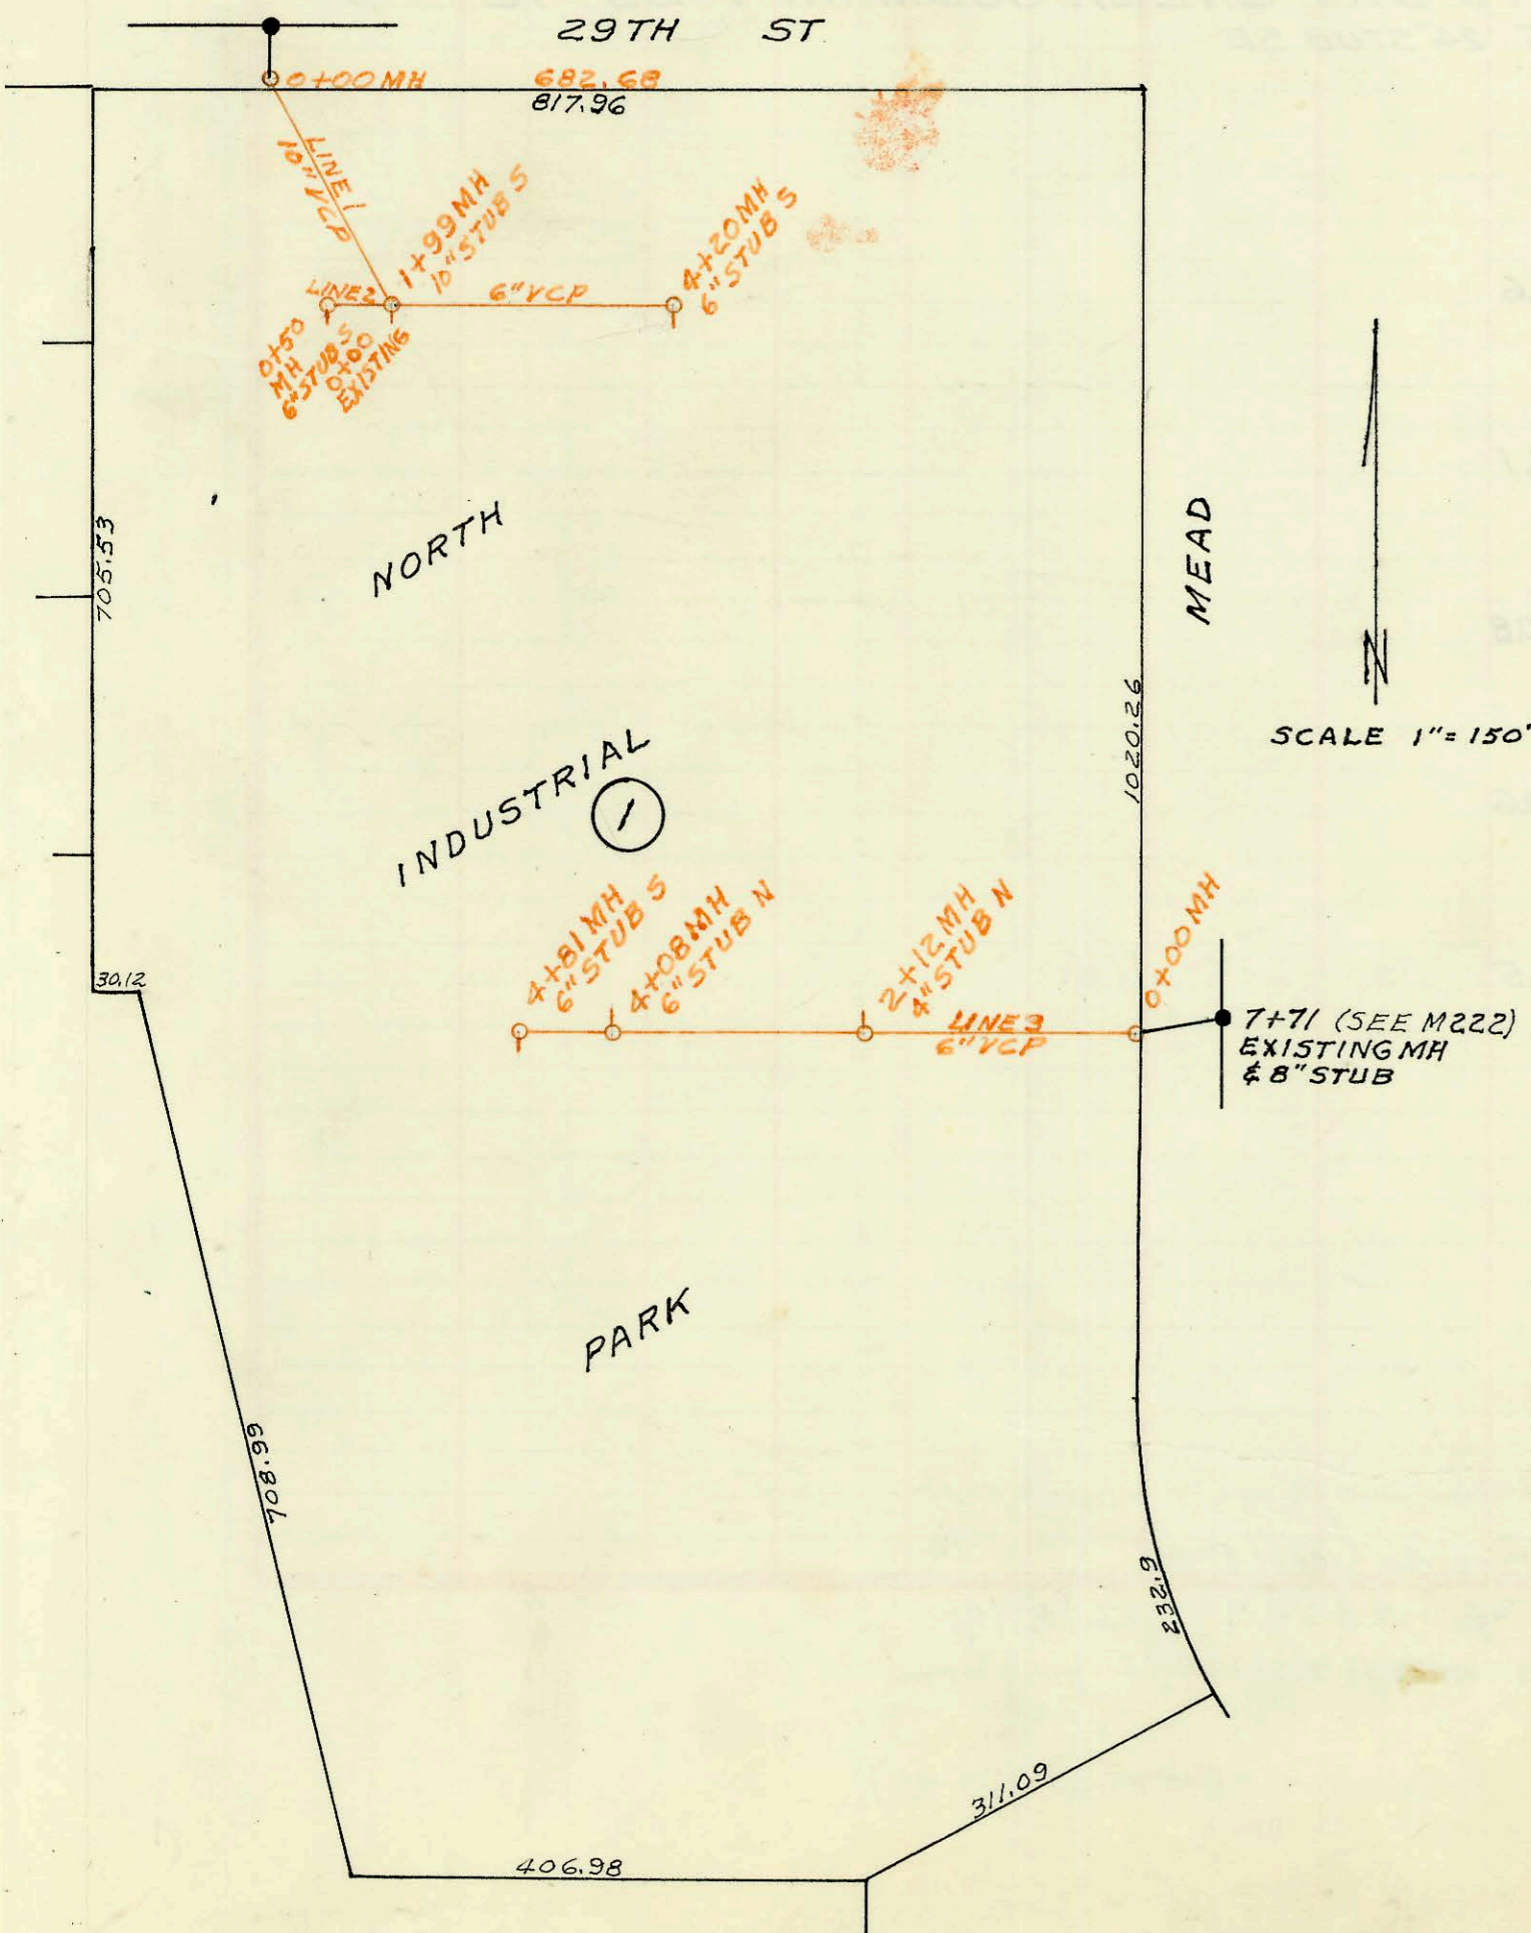

KANSAS BEEF INDUSTRY SANITARY SEWER
 BUILT BY: MID STATES CONST CO INC
 PROJ. N^o BHKB504011
 BOOKED 11-27-74 FROM PLAN

on map

SCALE 1"=150'

