


SCALE 1"=150

LATI MAIN 3 WESTLINK SS
 BUILT BY: WB CARTER CONST CO
 PROJ N° DBLK 574025
 BOOKED 12-3-74 FROM G-4

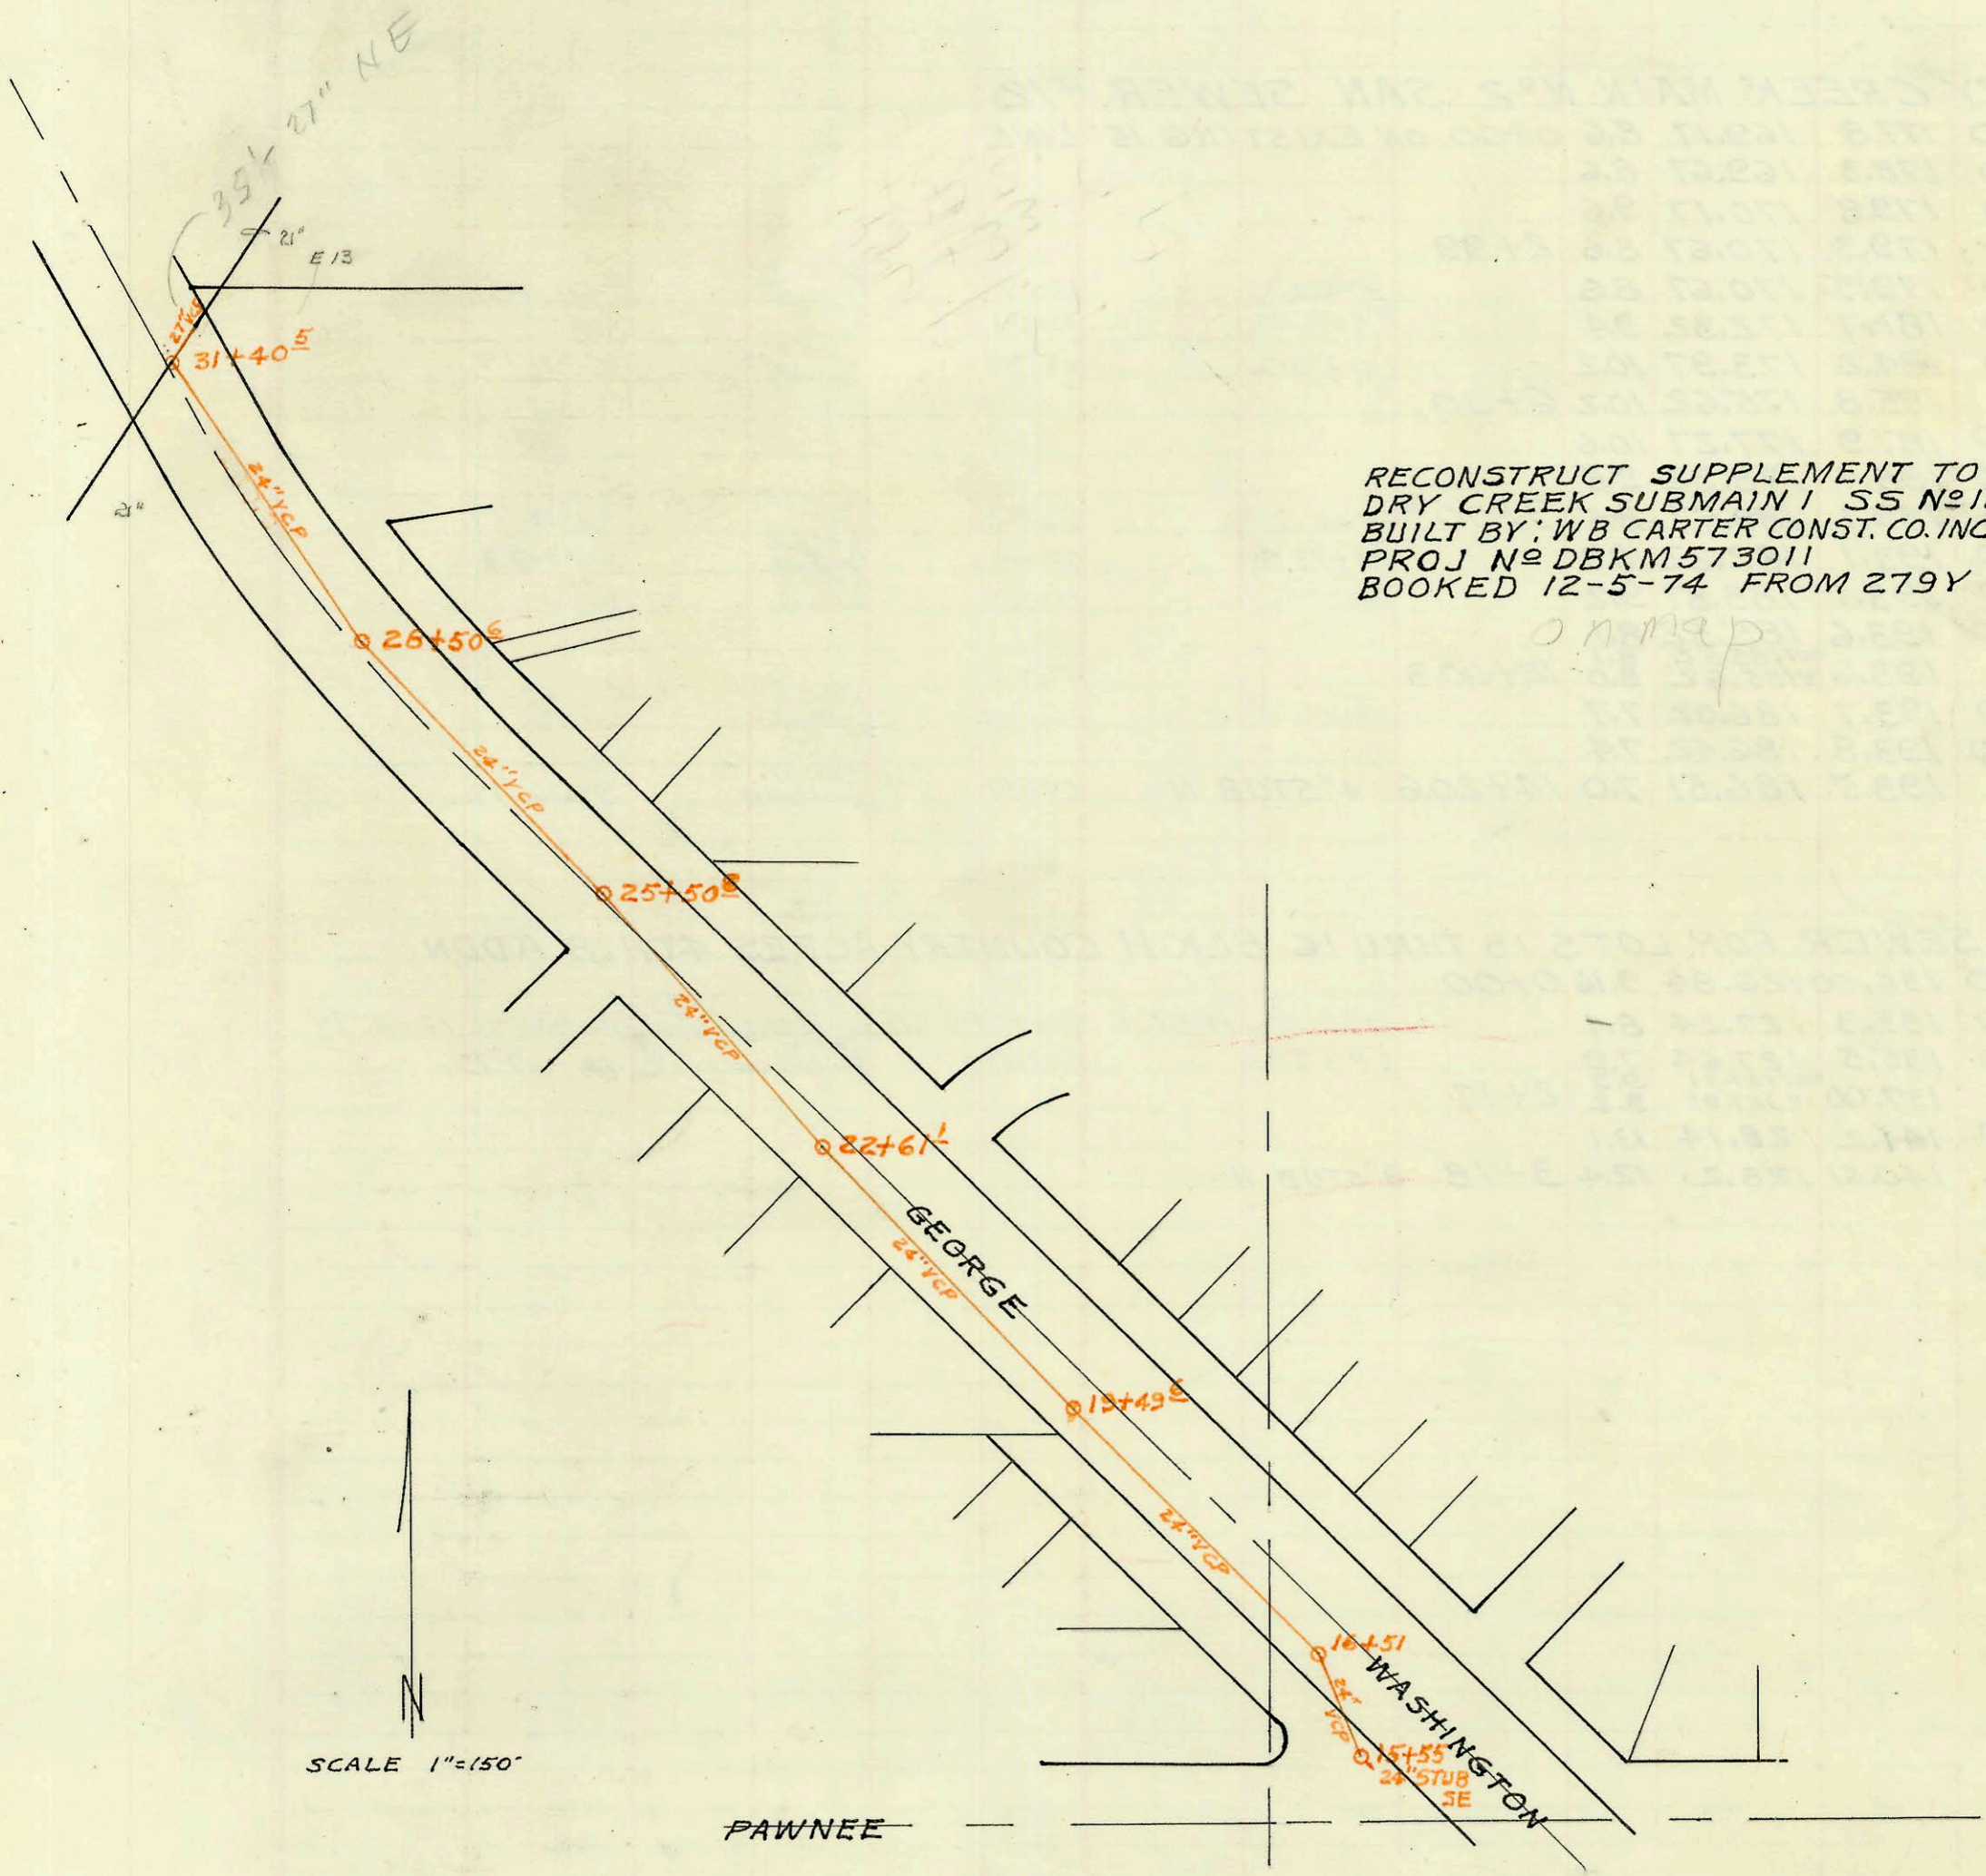

RECONSTRUCT SUPPLEMENT TO
 DRY CREEK SUBMAIN 1 SS N°12
 BUILT BY: WB CARTER CONST. CO. INC.
 PROJ N° DBKM 573011
 BOOKED 12-5-74 FROM 279Y

SCALE 1"=150

PAWNEE

