


SCALE 1"=150'

LAT 127 SAN SEWER N°22
 BUILT BY: WB CARTER CONST CO INC
 PROJ N° DBKL574080
 BOOKED 12-24-74 FROM JAK SS II

on map

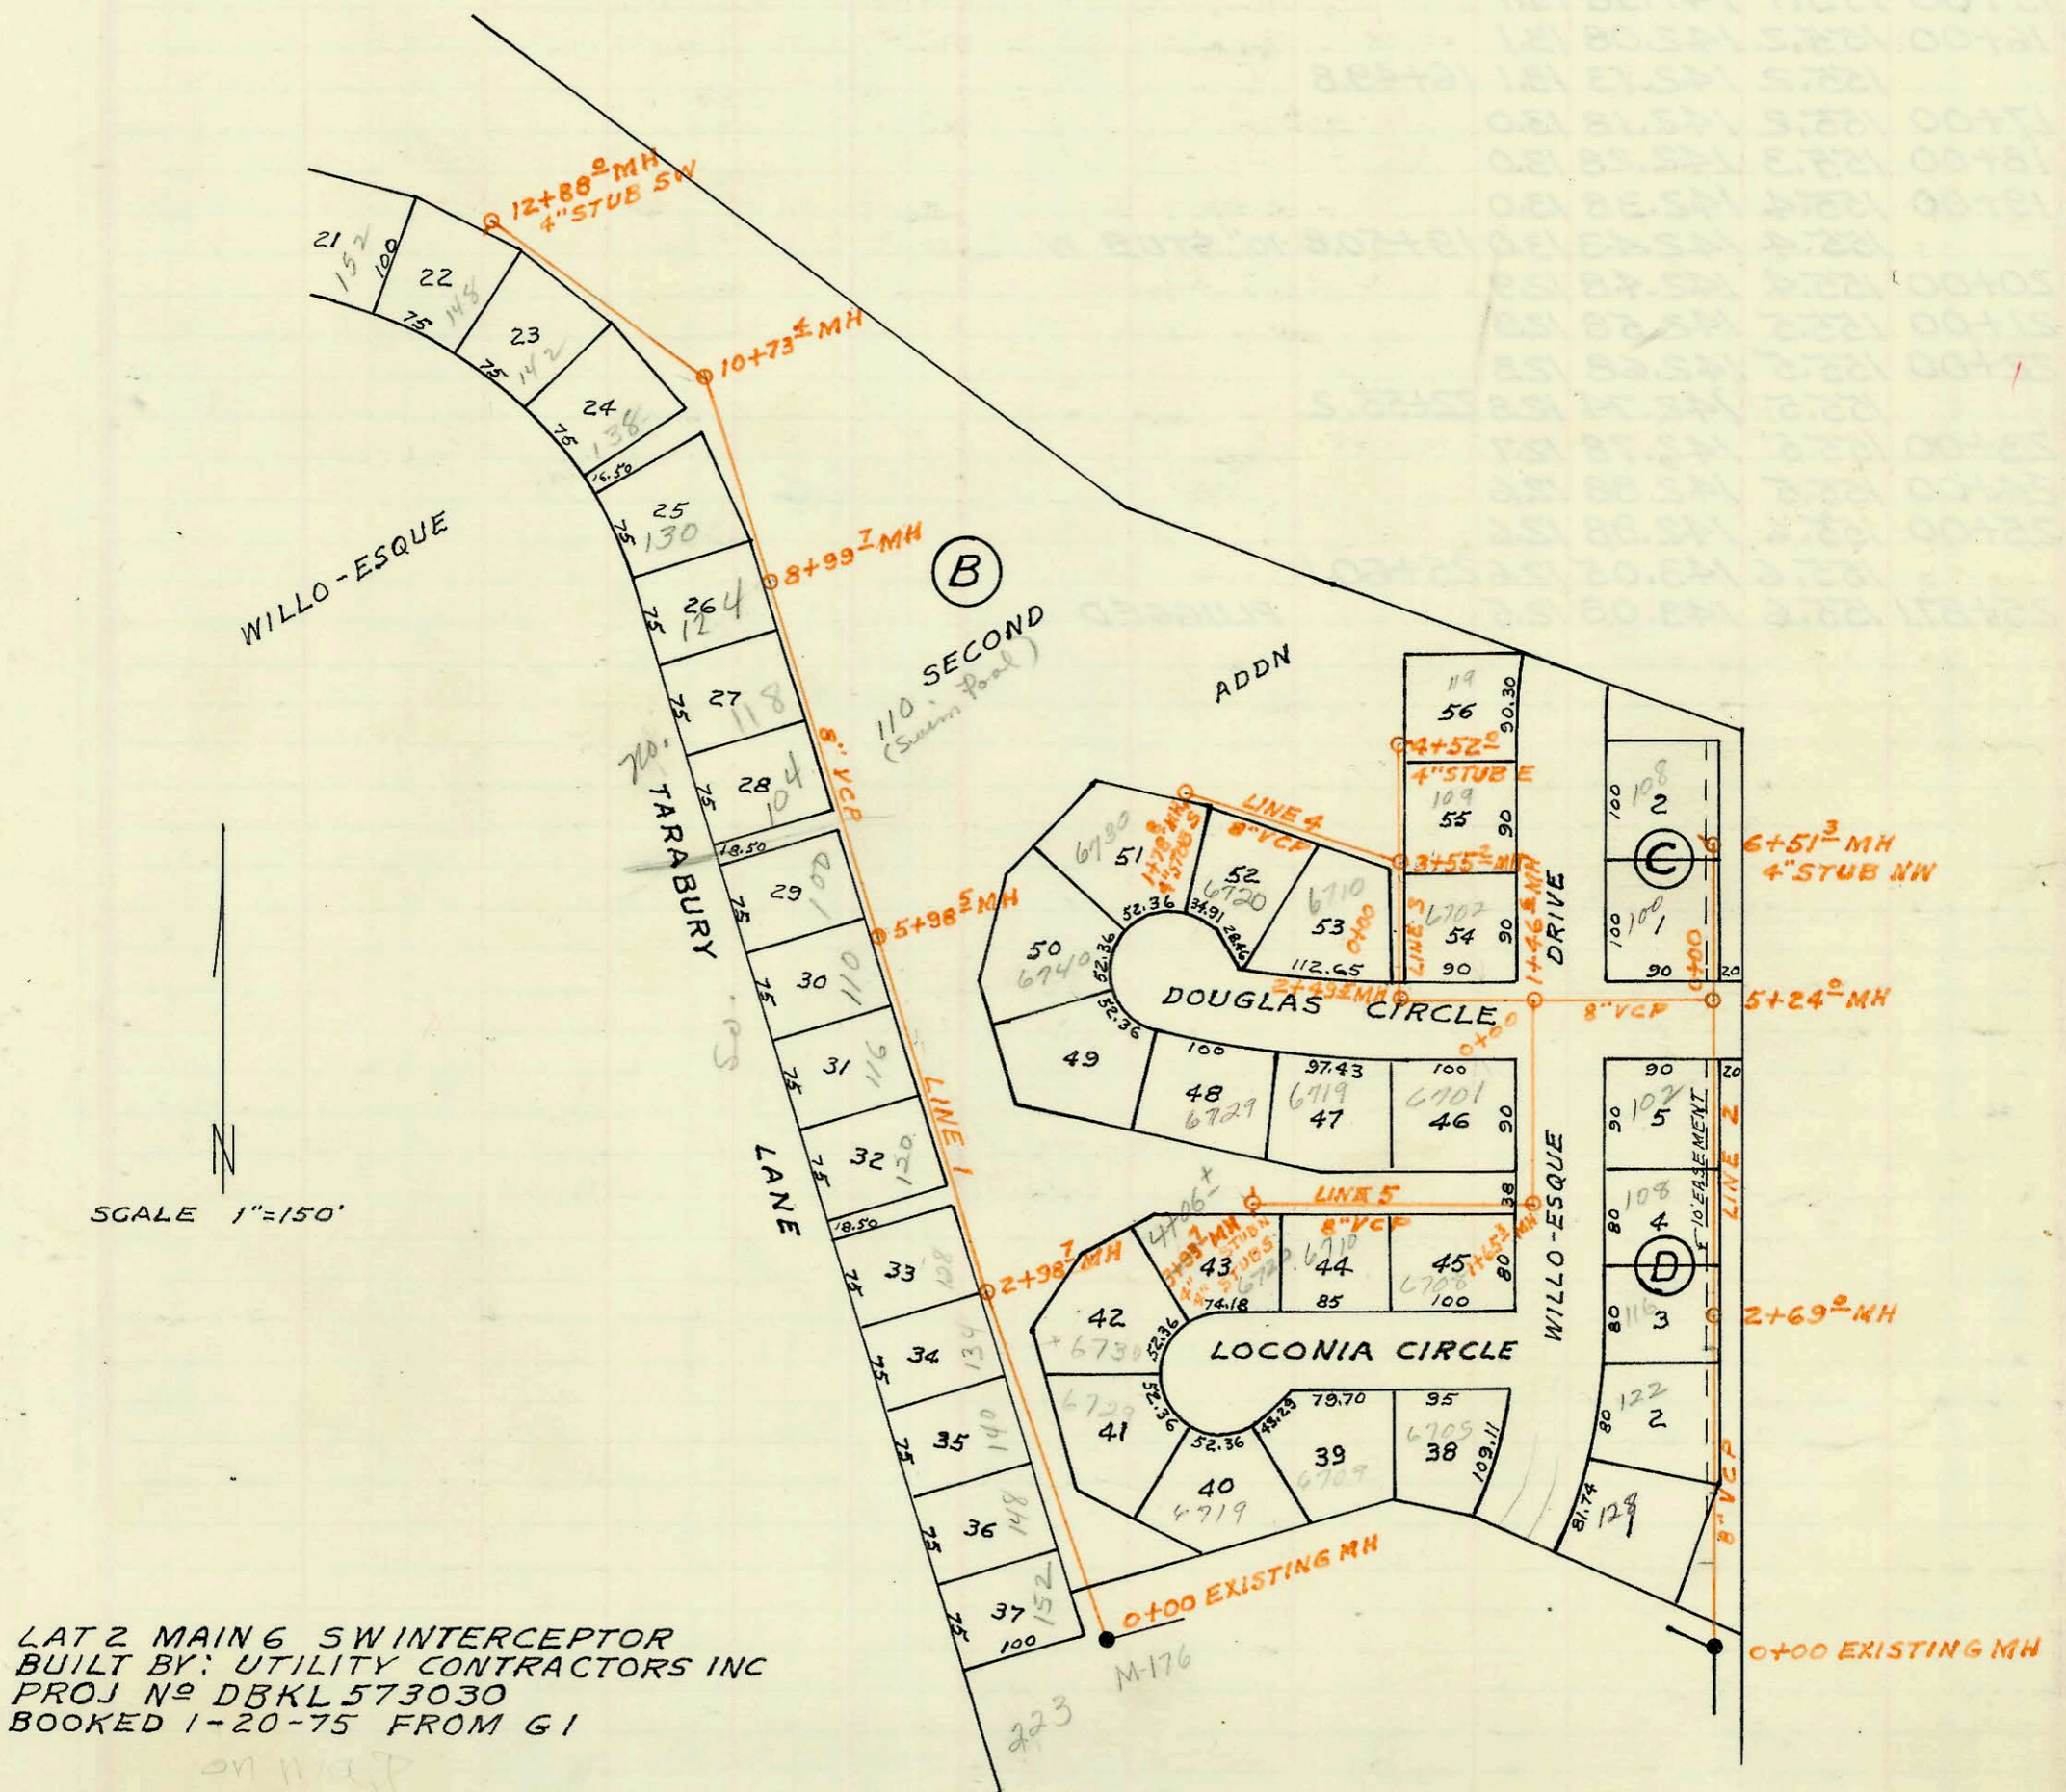

SCALE 1"=150'

LAT 2 MAIN 6 SW INTERCEPTOR
 BUILT BY: UTILITY CONTRACTORS INC
 PROJ N° DBKL 573030
 BOOKED 1-20-75 FROM G1

on map

CONSTRUCTION RECORD

SERVICE RECORD

STATION	ELEVATION		Depth	MANHOLE	4-INCH "Y" BRANCHES		No. of Permit		House Number		DATE OF PERMITS	
	Ground	Grade			North West	South East	North West	South East	North West	South East	North West	South East
LATERAL 127 SAN SEWER N^o 22												
0+00	112.3	106.66	5.6	0+00								
1+00	112.0	106.86	5.1									
2+00	112.5	107.06	5.4									
3+00	112.3	107.26	5.0									
	112.8	OUT 107.35 IN 107.45	5.5 5.4	3+45.4	6" STUB W		Not		in	Ben.		Dist.
4+00	112.5	107.56	4.9									
5+00	112.0	107.76	4.2									
	112.6	107.87	4.7	5+55.9	STUB W		C50718		4200 W. Harry		8-7-75	
LATERAL 2 MAIN 6 SOUTHWEST INTERCEPTOR												
LINE 1												
0+00	143.2	129.32	13.9	0+00	EXISTING MH							
1+00	145.6	130.07	15.5									
2+00	147.7	130.82	16.9									
	148.2	OUT 131.57 IN 131.67	16.6 16.5	2+98.7	1+85.0	2+70.6						
3+00	148.2	131.67	16.5									
4+00	149.6	132.42	17.2									
5+00	150.5	133.17	17.3									
	150.5	133.92	16.6	5+98.5	5+15	5+92.5						
6+00	150.5	133.92	16.6									
7+00	149.5	134.67	14.8									
8+00	148.3	135.42	12.9									
	147.7	136.17	11.5	8+99.7								
9+00	147.7	136.17	11.5									
10+00	147.5	136.92	10.6									
	147.0	OUT 137.48 IN 137.58	9.5 9.4	10+73.4								
11+00	147.0	137.77	9.2									
12+00	147.0	138.52	8.5									
	147.2	139.20	8.0	12+88.0	4" STUB SW							
LINE 2												
0+00	134.9	123.79	11.1	0+00	EXISTING MH							
1+00	135.3	124.29	11.0									
2+00	136.1	124.79	11.3									
	136.4	125.14	11.3	2+69.0	2+37.6							
3+00	136.6	125.29	11.3									
4+00	137.0	125.79	11.2									
5+00	137.9	126.29	11.6									
	138.5	OUT 126.40 IN 130.51	12.1 8.0	5+24.0	6+06.2							
6+00	139.1	131.28	7.8									
	139.8	131.78	8.0	6+51.3	4" STUB NW							
LINE 3												
0+00	138.9	126.61	12.3	0+00	= 5+24.0 LINE 2							
1+00	140.8	127.11	13.7									
	141.7	OUT 127.35 IN 127.45	14.4 14.3	1+46.6								
2+00	143.3	128.51	14.8									
	143.6	OUT 129.51 IN 129.61	14.1 14.0	2+49.5								
3+00	143.4	130.67	12.7									
	143.6	131.73	11.9	3+55.2								
4+00	143.7	132.67	11.0									
	143.7	133.67	10.0	4+52.0	4" STUB E							
LINE 4												
0+00	143.6	131.83	11.8	0+00	= 3+55.2 LINE 3							
1+00	144.4	133.83	10.6									
	145.7	135.43	10.3	1+78.8	4" STUB S							
LINE 5												
0+00	141.7	127.45	14.3	0+00	= 1+46.6 LINE 3							
1+00	140.0	127.95	12.1									
	139.7	OUT 128.28 IN 128.38	11.4 11.3	1+65.3	2+01.2							
2+00	140.7	123.55	12.2									
3+00	140.4	129.05	11.4									
	143.6	129.50	14.1	3+93.7	4" STUB N	4" STUB						

R- 2000-00840-122 S. Willo-Esque Dr- B+L 4" SCH 40-97's of MH 2+69(1+52) Repl upper 14' (old msmt wrong)

Tap C53711 - 2-19-76 - 1047 S. Searby - D. Hill (9+79.2)
Tap C53712 - 2-19-76 - 1247 S. Searby - D. Hill (9+04.4)