



LATERAL 20 MAIN 4 SWINTERCEPTOR
 BUILT BY: MID STATES CONST CO INC
 PROJ N° DBKL 574049
 BOOKED 1-30-75 FROM CG 15
 on map

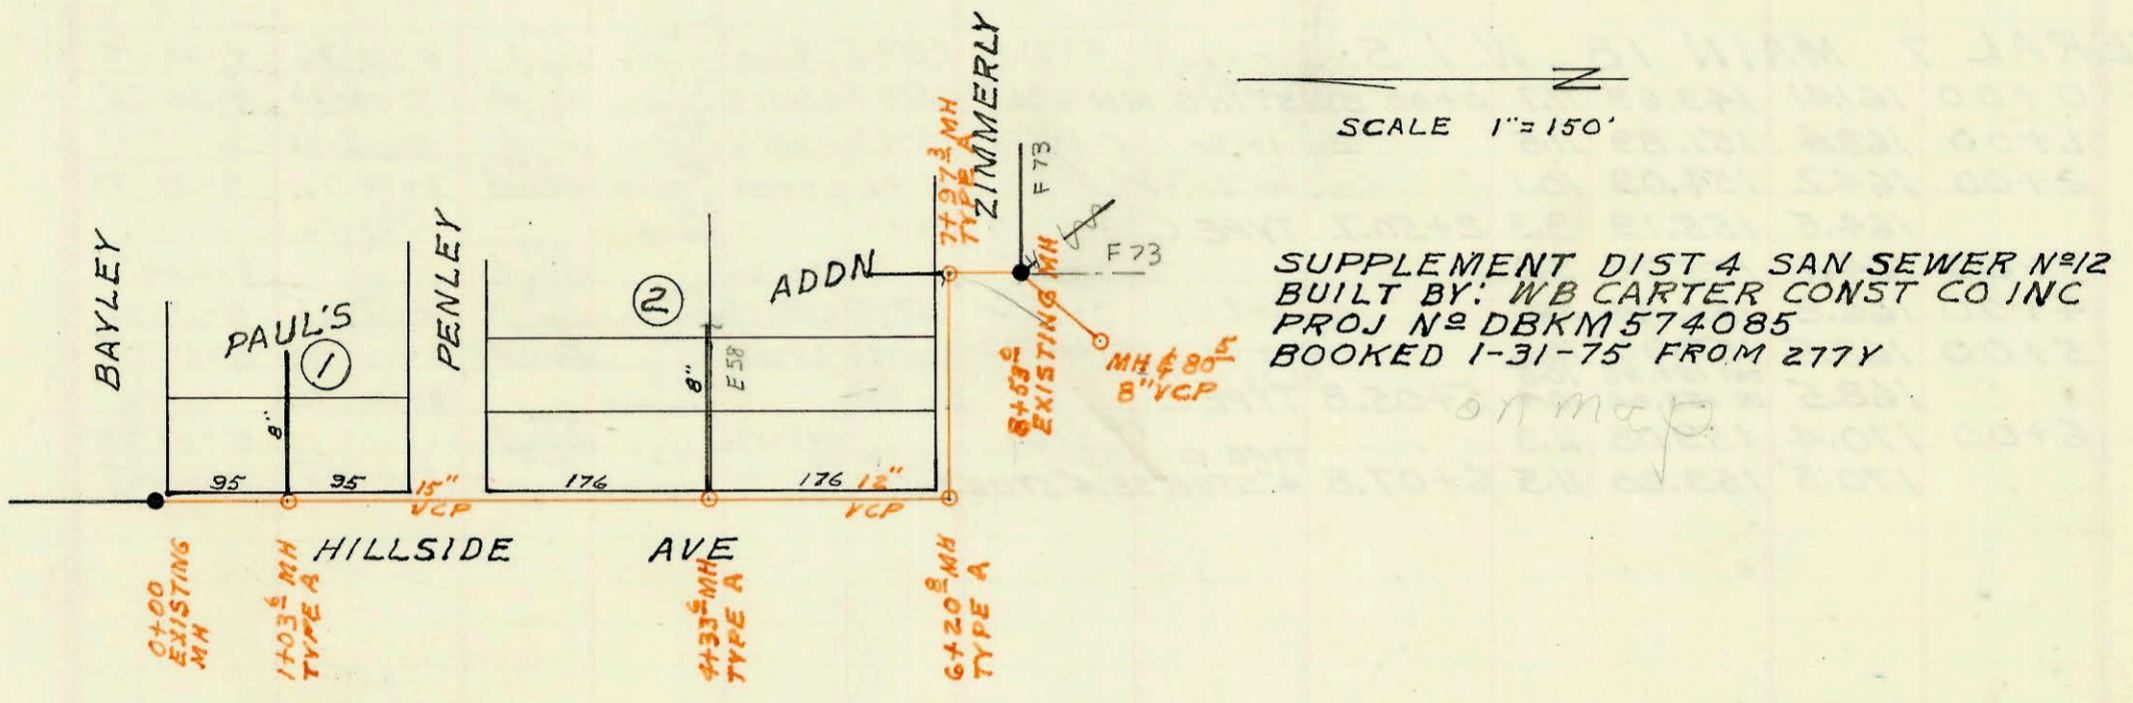

SUPPLEMENT DIST 4 SAN SEWER N°12
 BUILT BY: WB CARTER CONST CO INC
 PROJ N° DBKM 574085
 BOOKED 1-31-75 FROM 277Y
 on map

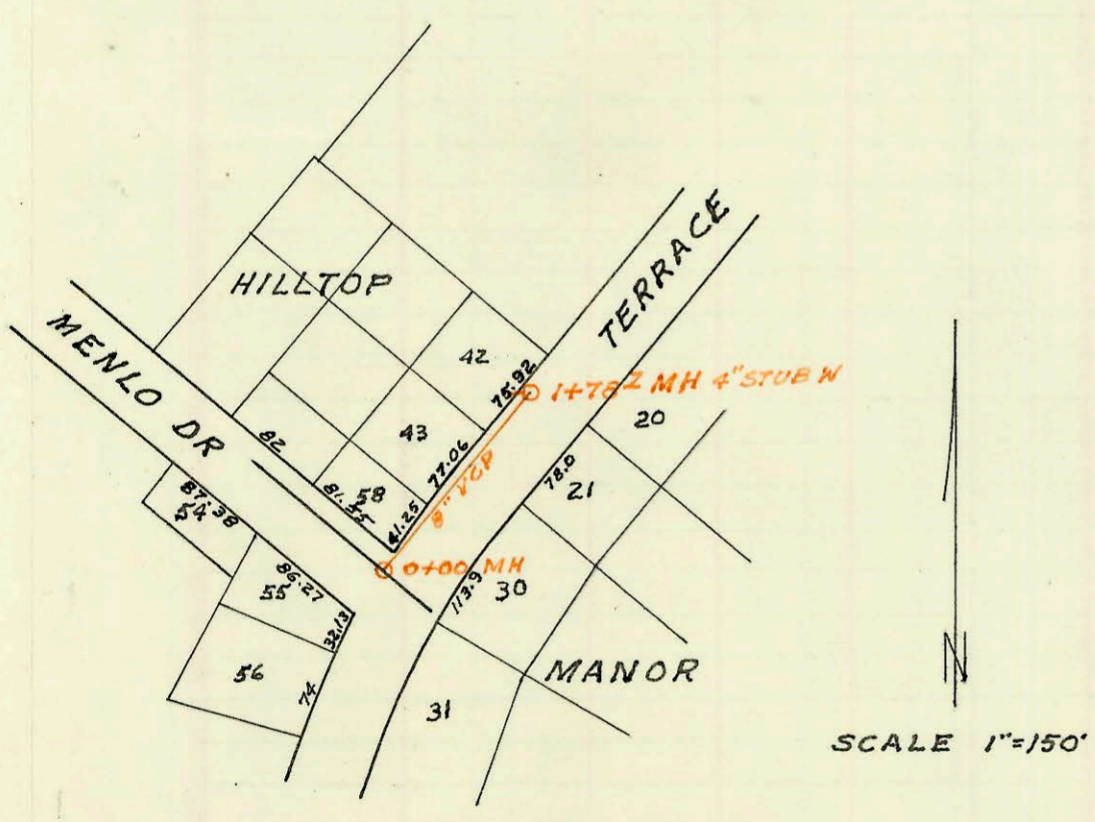

SUPPLEMENT LINE 10 HILLTOP MANOR SEWER
 BUILT BY: WB CARTER CONST CO INC
 PROJ. N° DBKL 574095
 BOOKED 2-12-75 FROM 8P
 on map

CONSTRUCTION RECORD

SERVICE RECORD

STATION	ELEVATION		Depth	MANHOLE	4-INCH "Y" BRANCHES		No. of Permit		House Number		DATE OF PERMITS	
	Ground	Grade			North West	South East	North West	South East	North West	South East	North West	South East
LATERAL 20 MAIN 4 SW INTERCEPTOR SEWER												
LINE 1												
0+00	137.3	127.34	10.0	0+00	EXISTING MH							
1+00	137.3	127.54	9.8			1+42.0	11024		453 Summit Hill 437 S.		5-25-84	
2+00	137.5	127.74	9.8			2+29.5	C48340		438 S. Summit Hill		2/10/75	
	137.2	127.88	9.3	2+73.0A	2+44.0		C49099		430 S. Ridge Rd		4-18-75	
3+00	137.0	127.94	9.1			3+31.2	7761		421 S. Summit Hill		4-28-83	
4+00	136.5	128.14	8.4			4+17.6	7761	C53546	7125 University		2/3/76	
5+00	135.3	128.34	7.0			5+06.4	8312	C48230	University Summit Hill		6-7-83	1-29-75
	135.2	128.42	6.8	5+43.0A								
6+00	135.1	128.54	6.6					208 S. 2nd	353 S. Summit Hill		9-3-03	
7+00	135.9	128.74	7.2			7+86.2		C49352			5-5-75	
8+00	137.0	128.94	8.1					255 S. 4th	352 S. Ridge Rd		4-3-03	9-3-07
	137.0	128.94	8.1	8+00.7A	8+19.7	8+56.3	10068	C49191	326 S. Ridge Rd	321 S. Summit Hill	4-16-84	4-23-75
9+00	137.6	129.14	8.5			9+85.0	48851	C49447	Ridge Rd Summit Hill		10-23-00	5-12-75
10+00	138.2	129.34	8.9									
	137.7	129.50	8.2	10+79.1A	4" STUB N							
11+00	137.7	129.69	8.0									
	136.9	129.95	7.0	11+65.8A	4" STUB N							
LINE 2												
0+00	137.7	131.00	6.7	0+00	= 10+79.1 LINE 1							
1+00	138.4	132.00	6.4					200-02588	7125 W. Maple	3102' from SPT 50' E of sidewalk	11-28-00	
	138.4	132.00	6.4	1+01.0	4" STUB N			43417			12-18-72	
SUPPLEMENT DIST 4 SAN SEWER #12												
0+00	106.4	102.35	4.1	0+00	EXISTING							
1+00	106.5	102.43	4.1									
	106.5	102.43	4.1	1+03.6A								
2+00	106.3	102.53	3.8									
3+00	106.5	102.63	3.9									
4+00	106.1	102.73	3.4									
	106.3	102.76	3.5									
		IN 103.01	3.3	4+33.6A								
5+00	106.6	103.14	3.5									
6+00	106.7	103.34	3.4									
	106.7	OUT 103.38	3.3									
		IN 103.49	3.2	6+20.8A								
7+00	107.5	103.64	3.9									
	109.1	OUT 103.82	5.3									
		IN 103.92	5.2	7+97.3A								
8+00	109.1	103.95	5.2									
	109.1	104.12	3.0	8+53.0	EXISTING							
SUPPLEMENT LINE 10 HILLTOP MANOR SAN SEWER												
0+00	157.2	150.75	6.5	0+00	ON EXISTING LINE							
1+00	156.5	150.95	5.6					C48090	1355 S. Terrace		1-17-75	
1+78.7	155.8	151.10	4.7	1+78.7	TYPE A 4" STUB W			C48091	1353 S. Terrace		1-17-75	
0+00												
0+80.5												

Could be Private Job

Tap C48089 - 1361 S. Terrace - 1-17-75 (1+01.8)
 Tap C48088 - 1363 S. Terrace - 1-17-75 (0+68.4)
 Tap C48087 - 1369 S. Terrace - 1-17-75 (0+27.4)